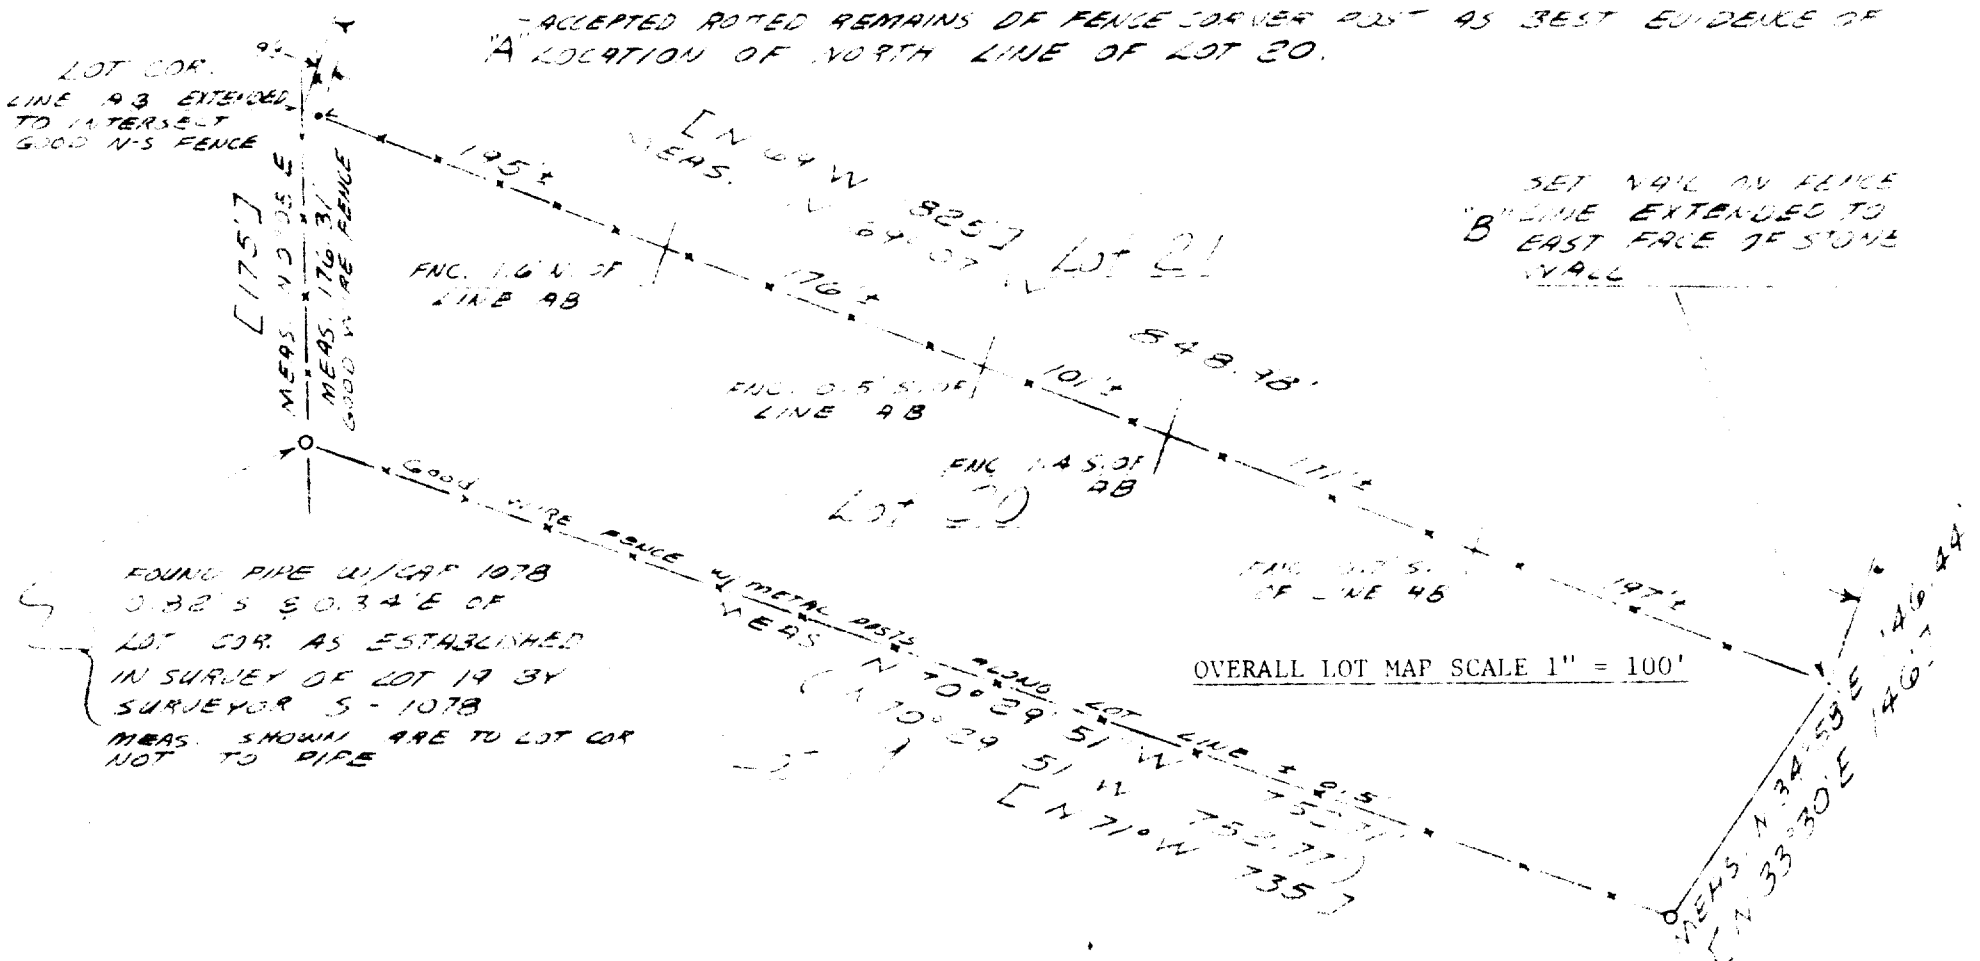

PLAT OF SURVEY OF LOT 20 OF STEARN'S AND GEROULD'S SUBDIVISION LOCATED IN THE SOUTHWEST 1/4 OF SECTION 11, TOWN 1 NORTH, RANGE 16 EAST, WALWORTH COUNTY, WISCONSIN FOR CRAIG CURRY

I HEREBY CERTIFY that the above described property has been surveyed under my direction and that this plat is a true and accurate representation of the lot lines as occupied and fenced and of the location of a residence on said lot to the best of my professional knowledge and belief.

Robert A. Farris RLS

Dated this 13th day of July, 1983

WISCONSIN ROBERT A. FARRIS S-1293 ELKHORN, WIS LAND SURVEYOR

(xxxx) = lot dimension appearing on the original plat of Stearns & Gerould's Sub.

(xxxx) = lot dimension appearing on plat of survey of lot 19 by s-1078 on file in the office of the Walworth County Surveyor

Note: No original lot corner stakes could be found. The existing lot line fences were accepted as the best evidence of the original lot lines.

DETAIL OF FRONT PART OF LOT MAP SCALE 1" = 20'

FARRIS, HANSEN & ASSOCIATES, INC.
715 W. Walworth St. P.O. Box 487
Elkhorn, WI 53121

PROJECT NO. 2128
5-605-F

SS+G-13