
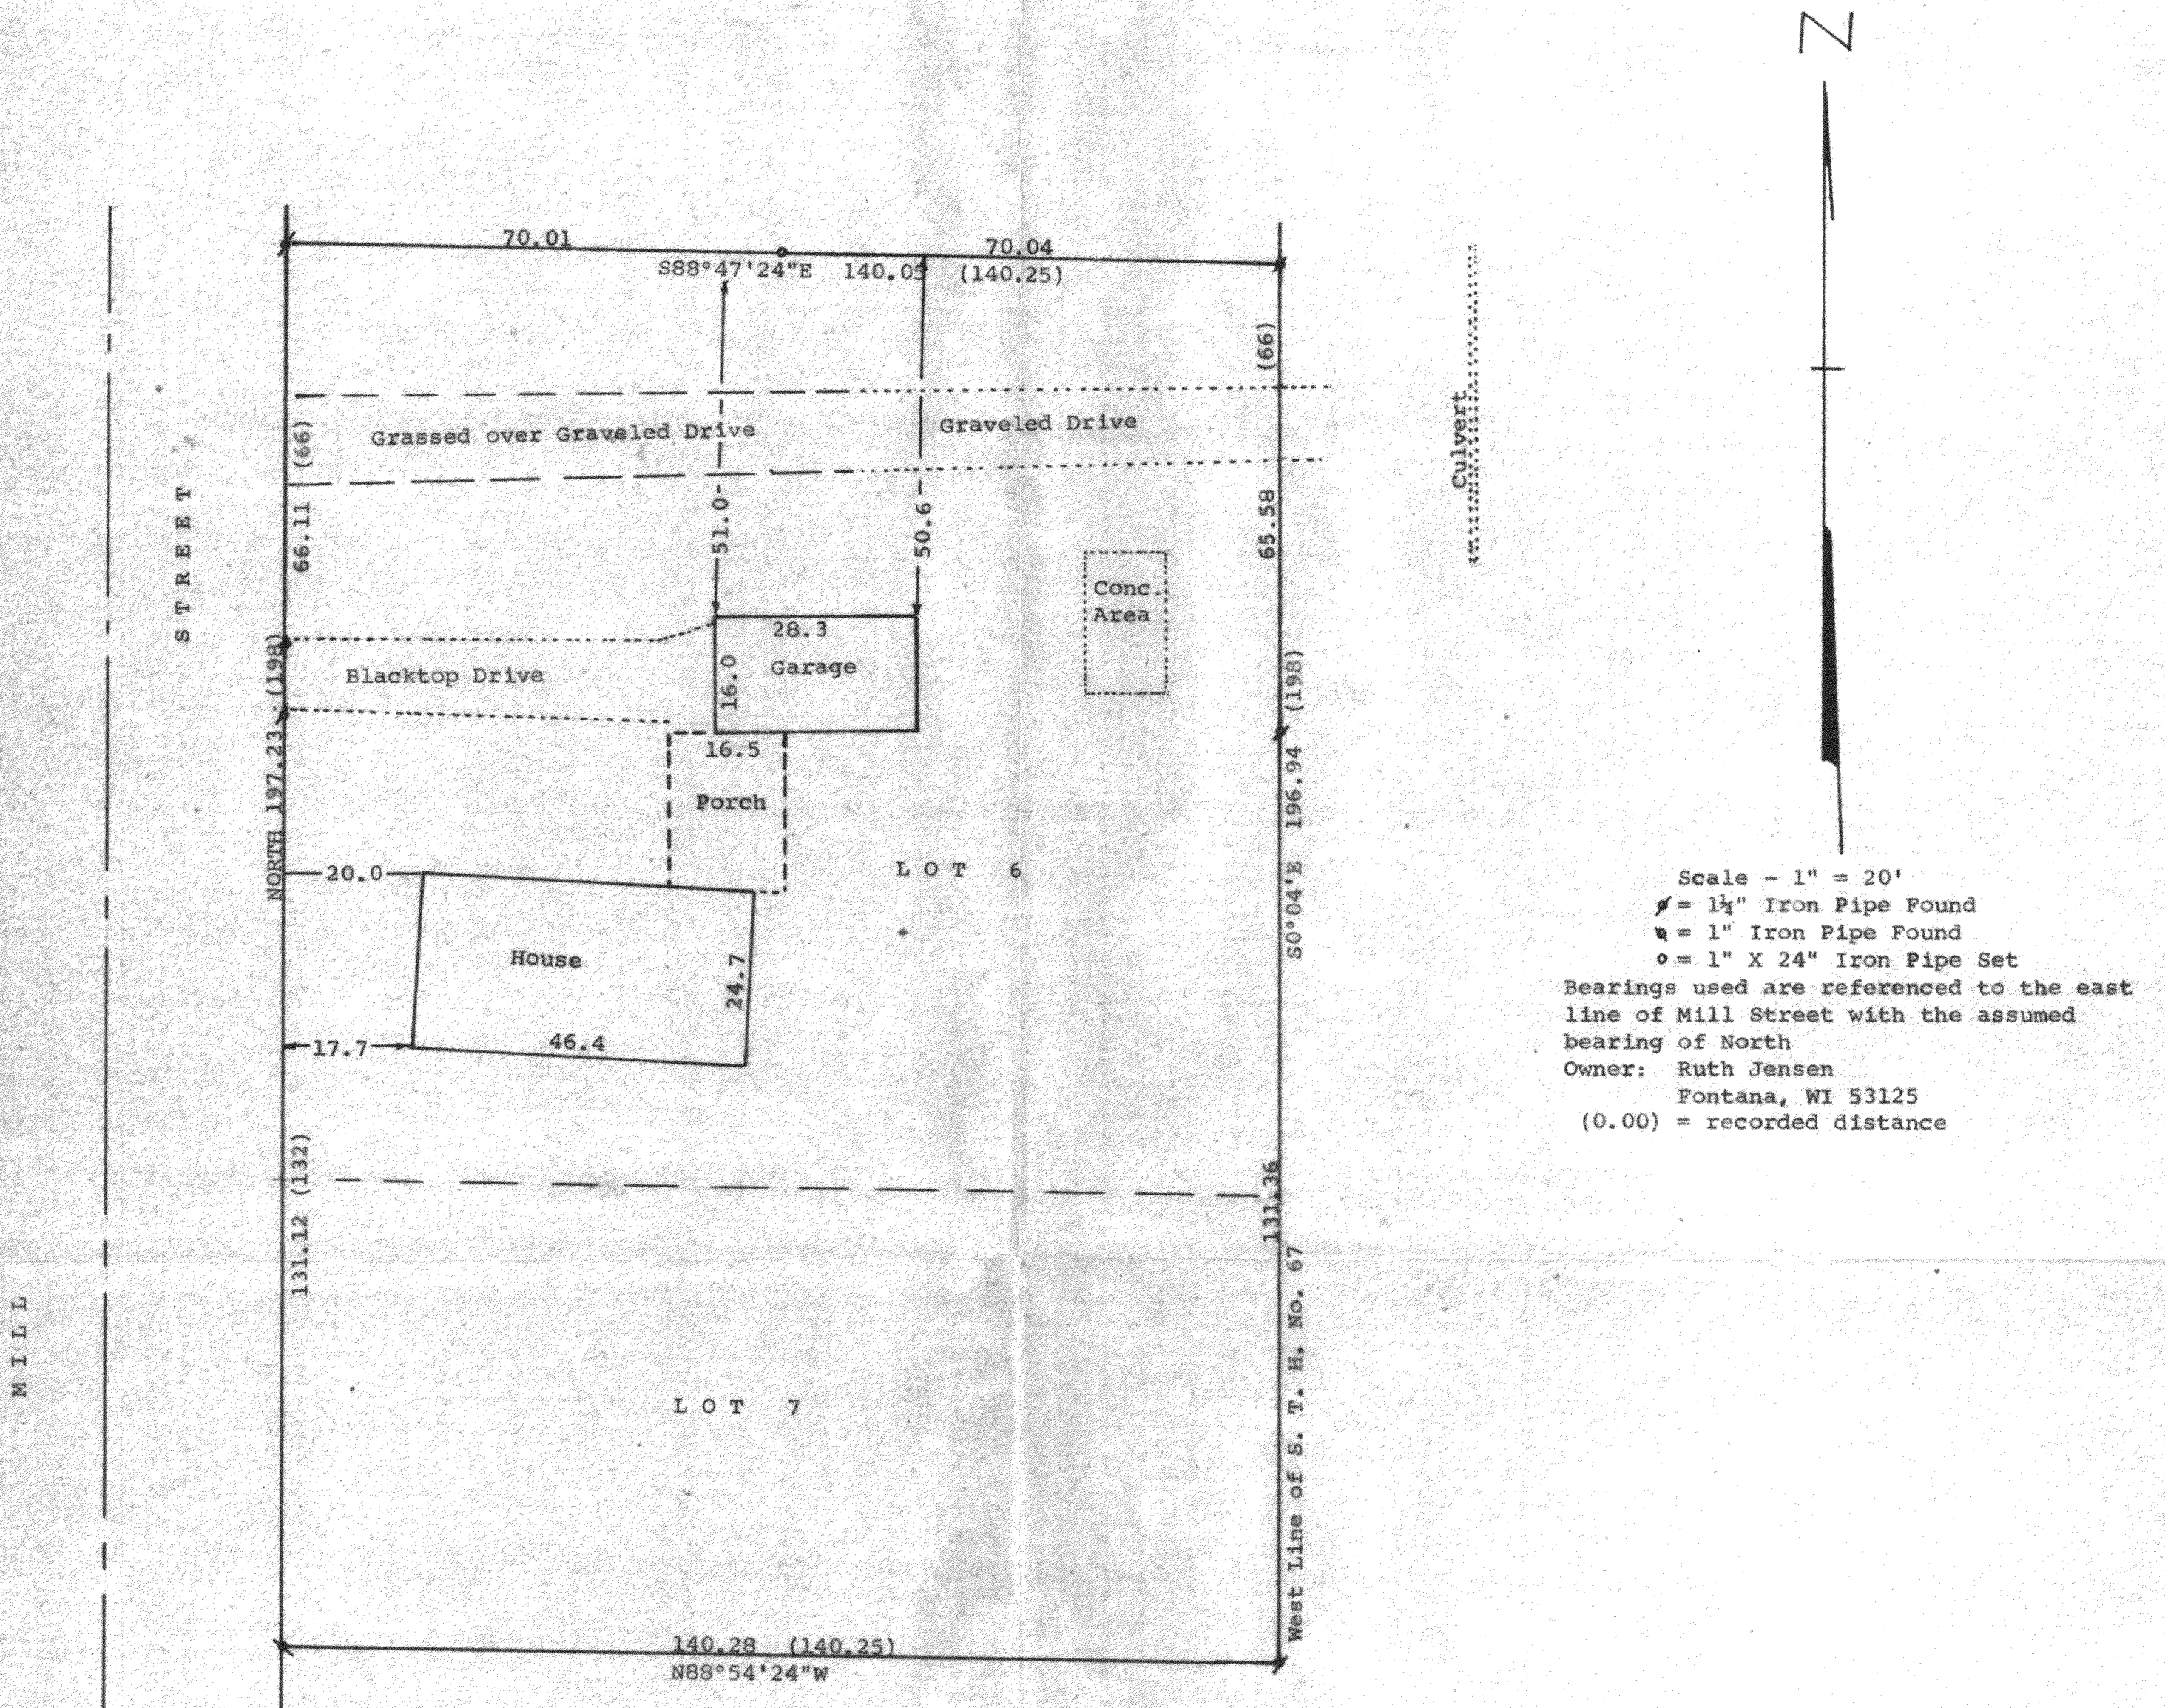


DUNHAM SURVEYING, S.C.
SURVEYING & SUBDIVIDING
DELAVER, WISCONSIN 53115

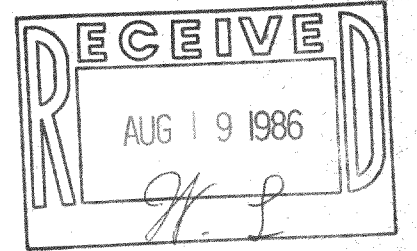

Scale - 1" = 20'
 * = 1 1/2" Iron Pipe Found
 v = 1" Iron Pipe Found
 o = 1" X 24" Iron Pipe Set
 Bearings used are referenced to the east line of Mill Street with the assumed bearing of North
 Owner: Ruth Jensen
 Fontana, WI 53125
 (0.00) = recorded distance

STATE OF WISCONSIN) SS
 COUNTY OF WALWORTH)
 I, George T. Dunham, Surveyor, certify that I have surveyed the property described as follows:
 Lots 6 and 7 in Block 3 of Assessor's Plat No. 1, C. L. Douglas Addition to the Village of Fontana-on-Geneva Lake, Walworth County, Wisconsin,
 and that the above map is a true representation thereof and shows the size and location of the property, its exterior boundaries, the location of all visible structures and dimensions of all principal buildings thereon, boundary fences, apparent easements, roadways and visible encroachments, if any, and that I have surveyed the property hereon described according to the official records, to the best of my knowledge and belief.
 April 1, 1986

George T. Dunham
 George T. Dunham, Surveyor

