# ABELL
## SURVEYING & MAPPING
DELAVAN, WISCONSIN 53115
414-728-6737


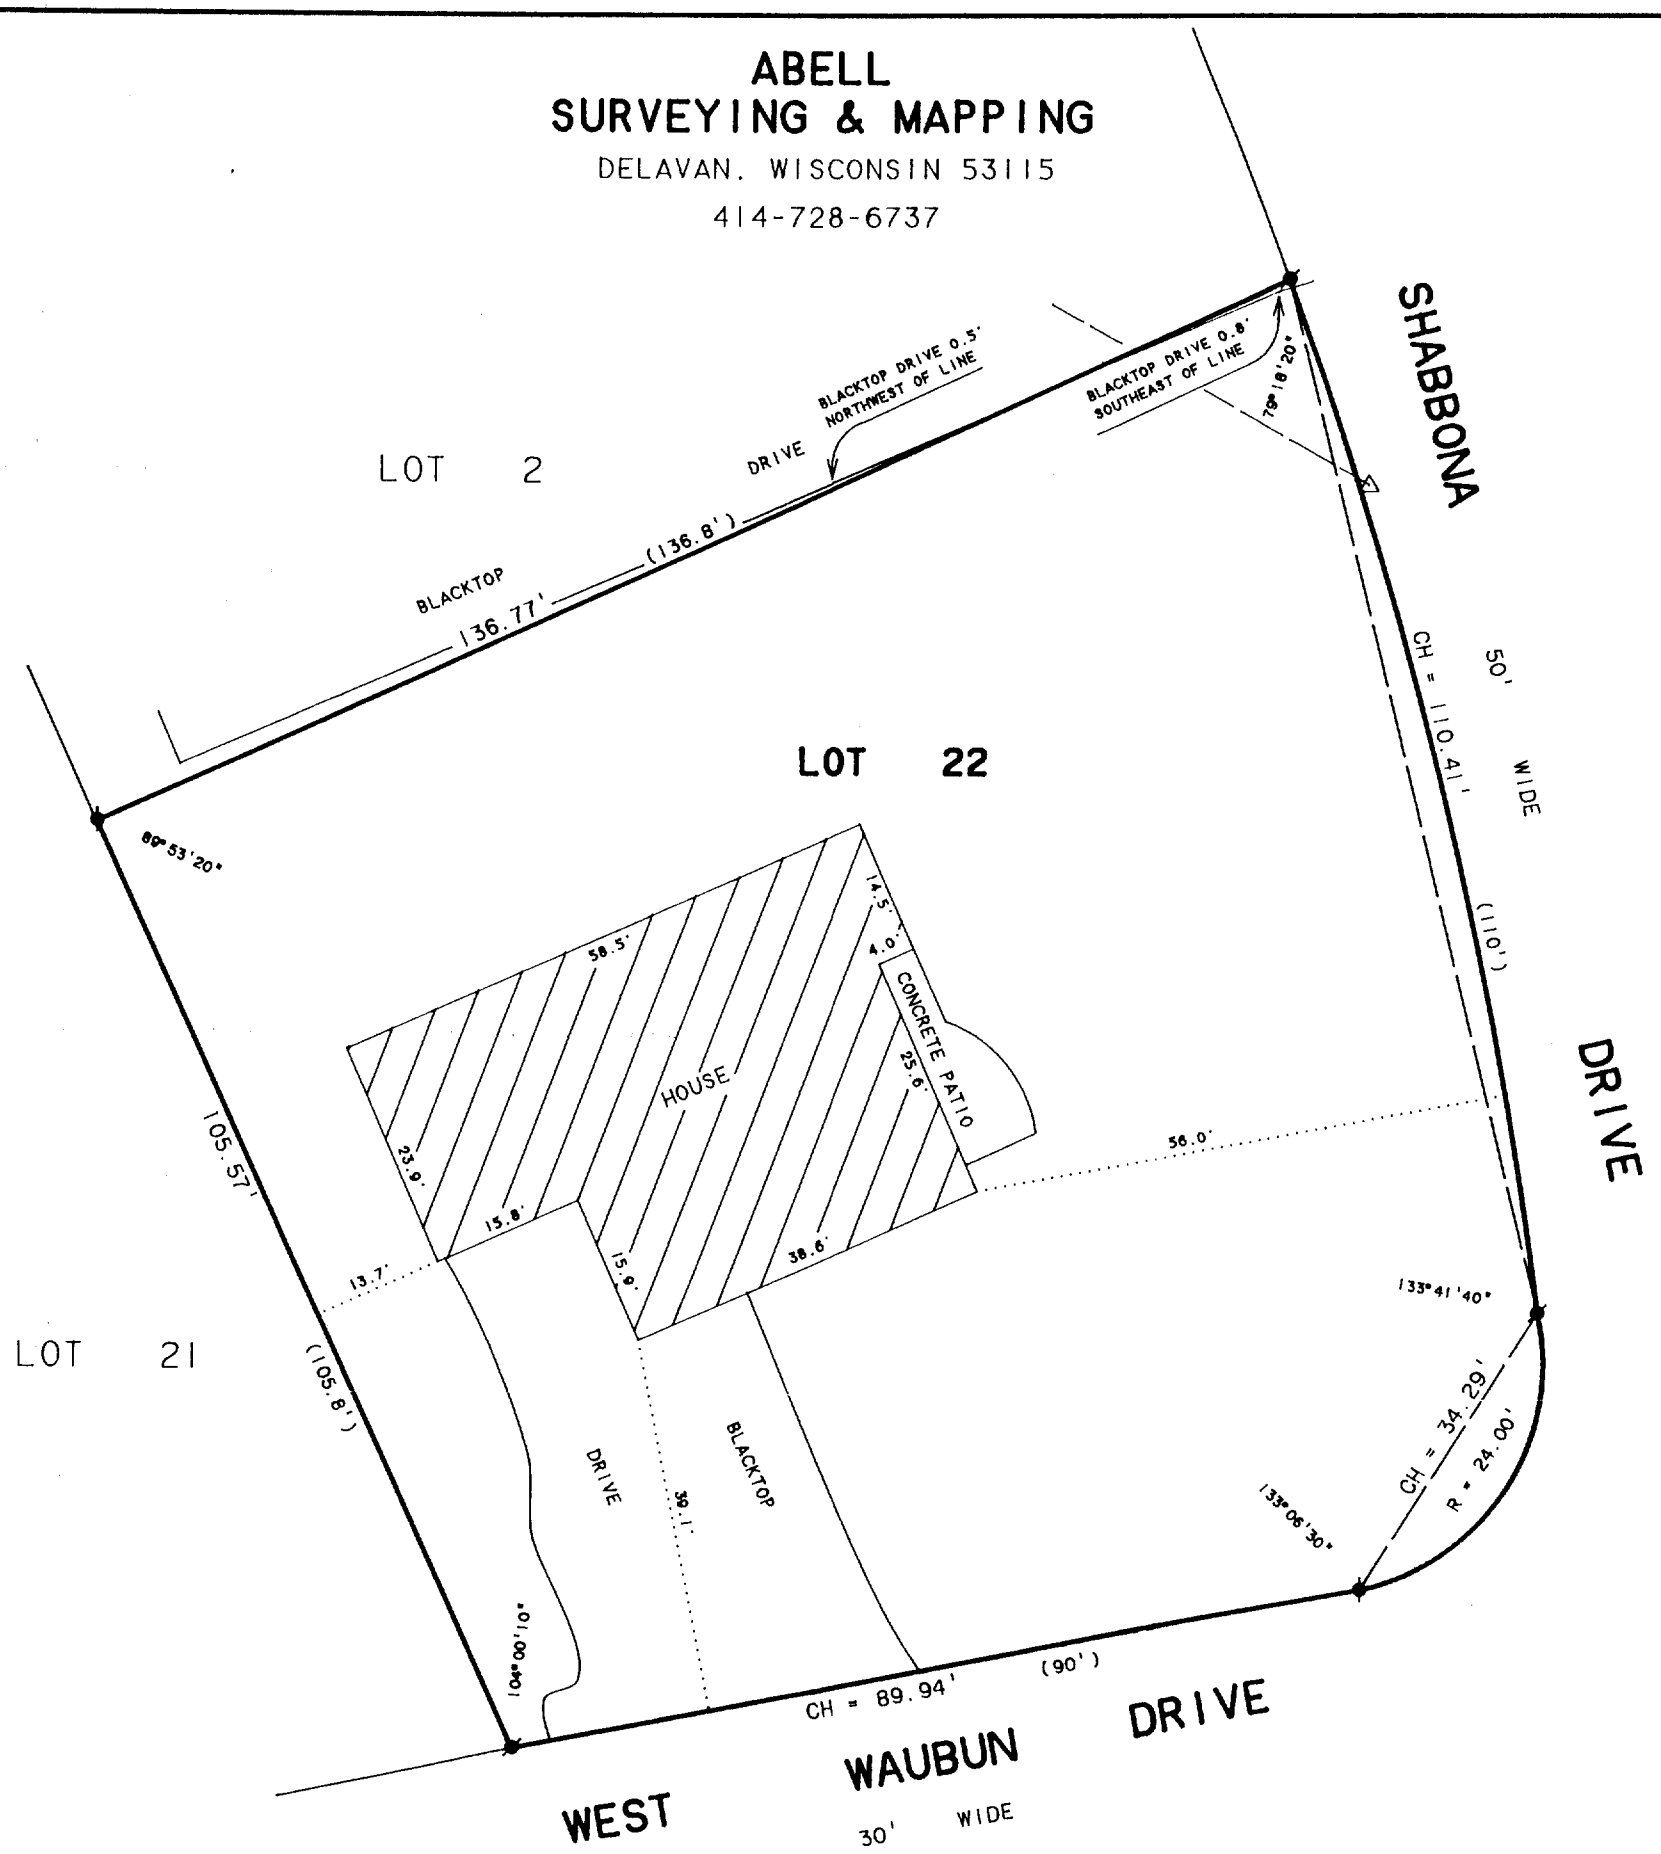


N

SCALE 1"=20'

RECEIVED
AUG 26 1992

## PLAT OF SURVEY OF

LOT 22, COUNTRY CLUB ESTATES UNIT - 2, LOCATED IN THE VILLAGE OF FONTANA-ON-GENEVA LAKE, WALWORTH COUNTY, WISCONSIN.

### LEGEND

- -CONCRETE MONUMENT FOUND
- -UTILITY POLE
- -OVERHEAD UTILITY LINES
- ( )-RECORDED AS

I HEREBY CERTIFY THAT I HAVE SURVEYED THE ABOVE DESCRIBED PROPERTY AND THAT THE ABOVE MAP IS A TRUE REPRESENTATION THEREOF AND SHOWS THE SIZE AND LOCATION OF THE PROPERTY, ITS EXTERIOR BOUNDARIES, THE LOCATION OF ALL VISIBLE STRUCTURES AND DIMENSIONS OF ALL PRINCIPAL BUILDINGS THEREON, BOUNDARY FENCES, APPARENT EASEMENTS, ROADWAYS AND VISIBLE ENCROACHMENTS, IF ANY, TO THE BEST OF MY KNOWLEDGE AND BELIEF.

THIS SURVEY IS MADE FOR THE USE OF THE PRESENT OWNERS OF THE PROPERTY, AND ALSO THOSE WHO PURCHASE, MORTGAGE, OR GUARANTEE THE TITLE THERETO WITHIN ONE (1) YEAR FROM DATE HEREON.

David F. Abell

DAVID F. ABELL
WISCONSIN REGISTERED LAND SURVEYOR, S-1596

ORDERED BY: THE RAULAND AGENCY
118 KENOSHA ST.
WALWORTH, WI. 53184

JUNE 23, 1992
DATE

JOB NUMBER - 92139

NOTE: THIS IS NOT A CERTIFIED COPY UNLESS SEALED.

005-1189

SC02-19