ROBERS & FISCHER, INC.

HOGANSON & ASSOCIATES, INC.

CONSULTING ENGINEERS & LAND SURVEYORS

PHONE (414) 763-2652 — 116 E. CHESTNUT ST. — BURLINGTON, WIS. 53105

Plat of Survey and House Location

Lot 8, Block 2 of Assessor's Plat # 1, C.L. Douglas Addition, Village of Fontana-on-Geneva Lake, Wisconsin.

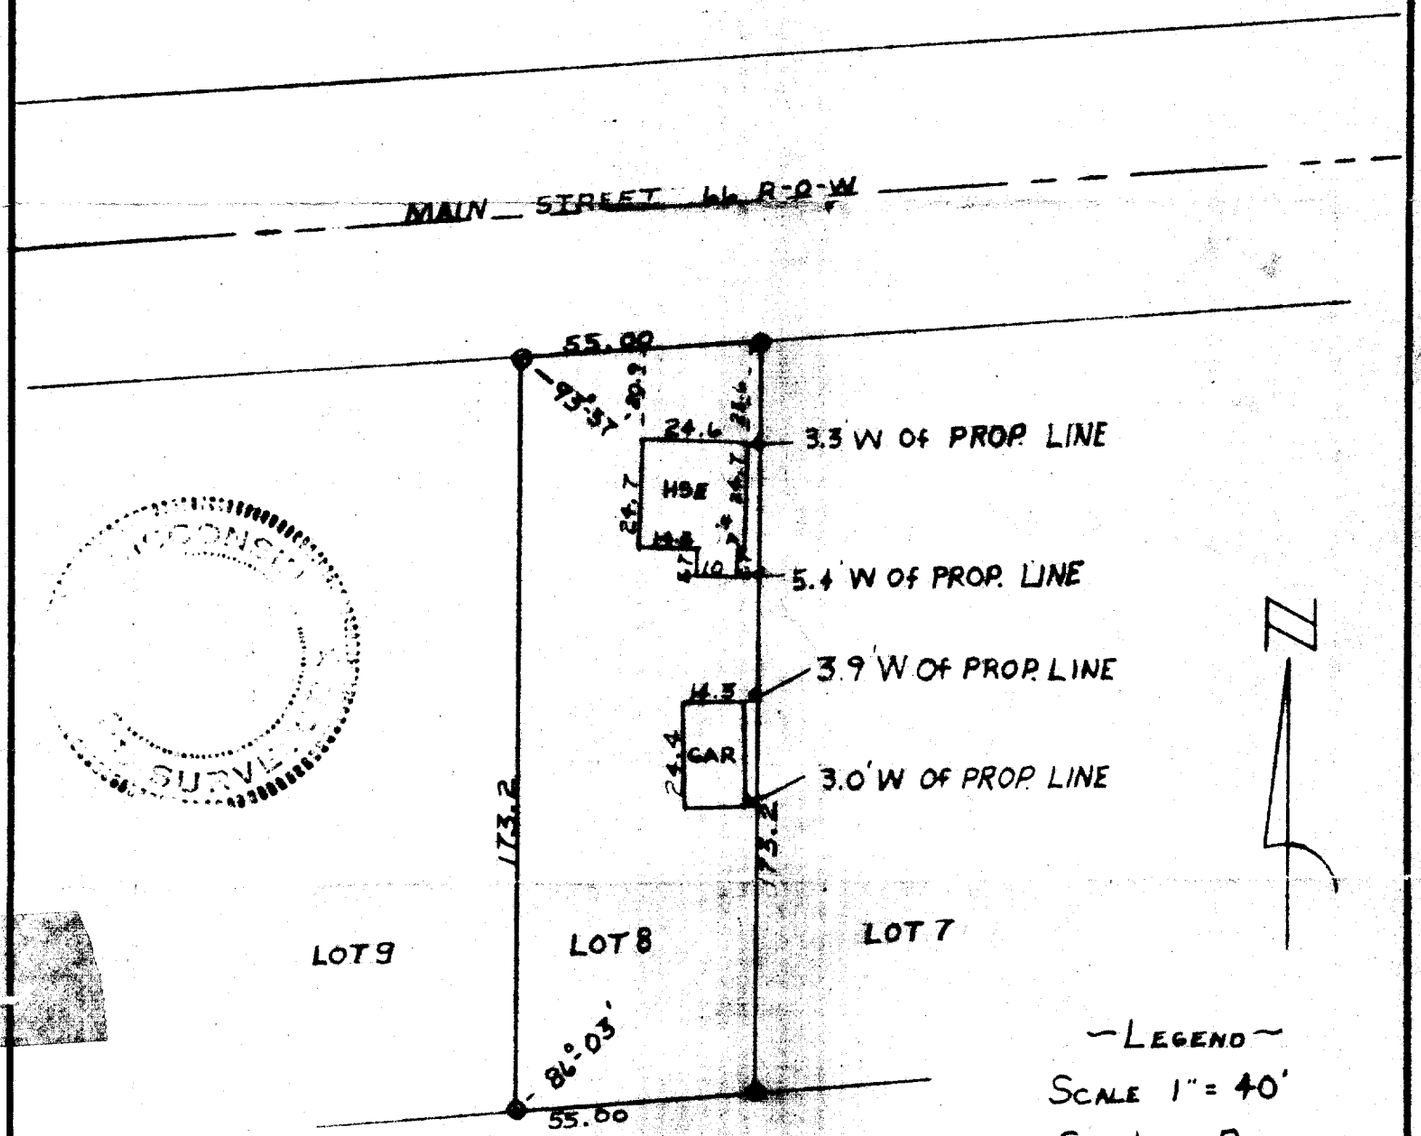

I HEREBY CERTIFY THAT WE HAVE SURVEYED THE LANDS DESCRIBED ABOVE ACCORDING TO OFFICIAL RECORDS AND THAT THE PLAT DRAWN HEREON IS A CORRECT REPRESENTATION OF SAID SURVEY.

Charles R. Fischer
WIS. REG. LAND SURVEYOR

DATE Dec. 70

5-141

JOB NO. 70152

STEV 1.91

5-141