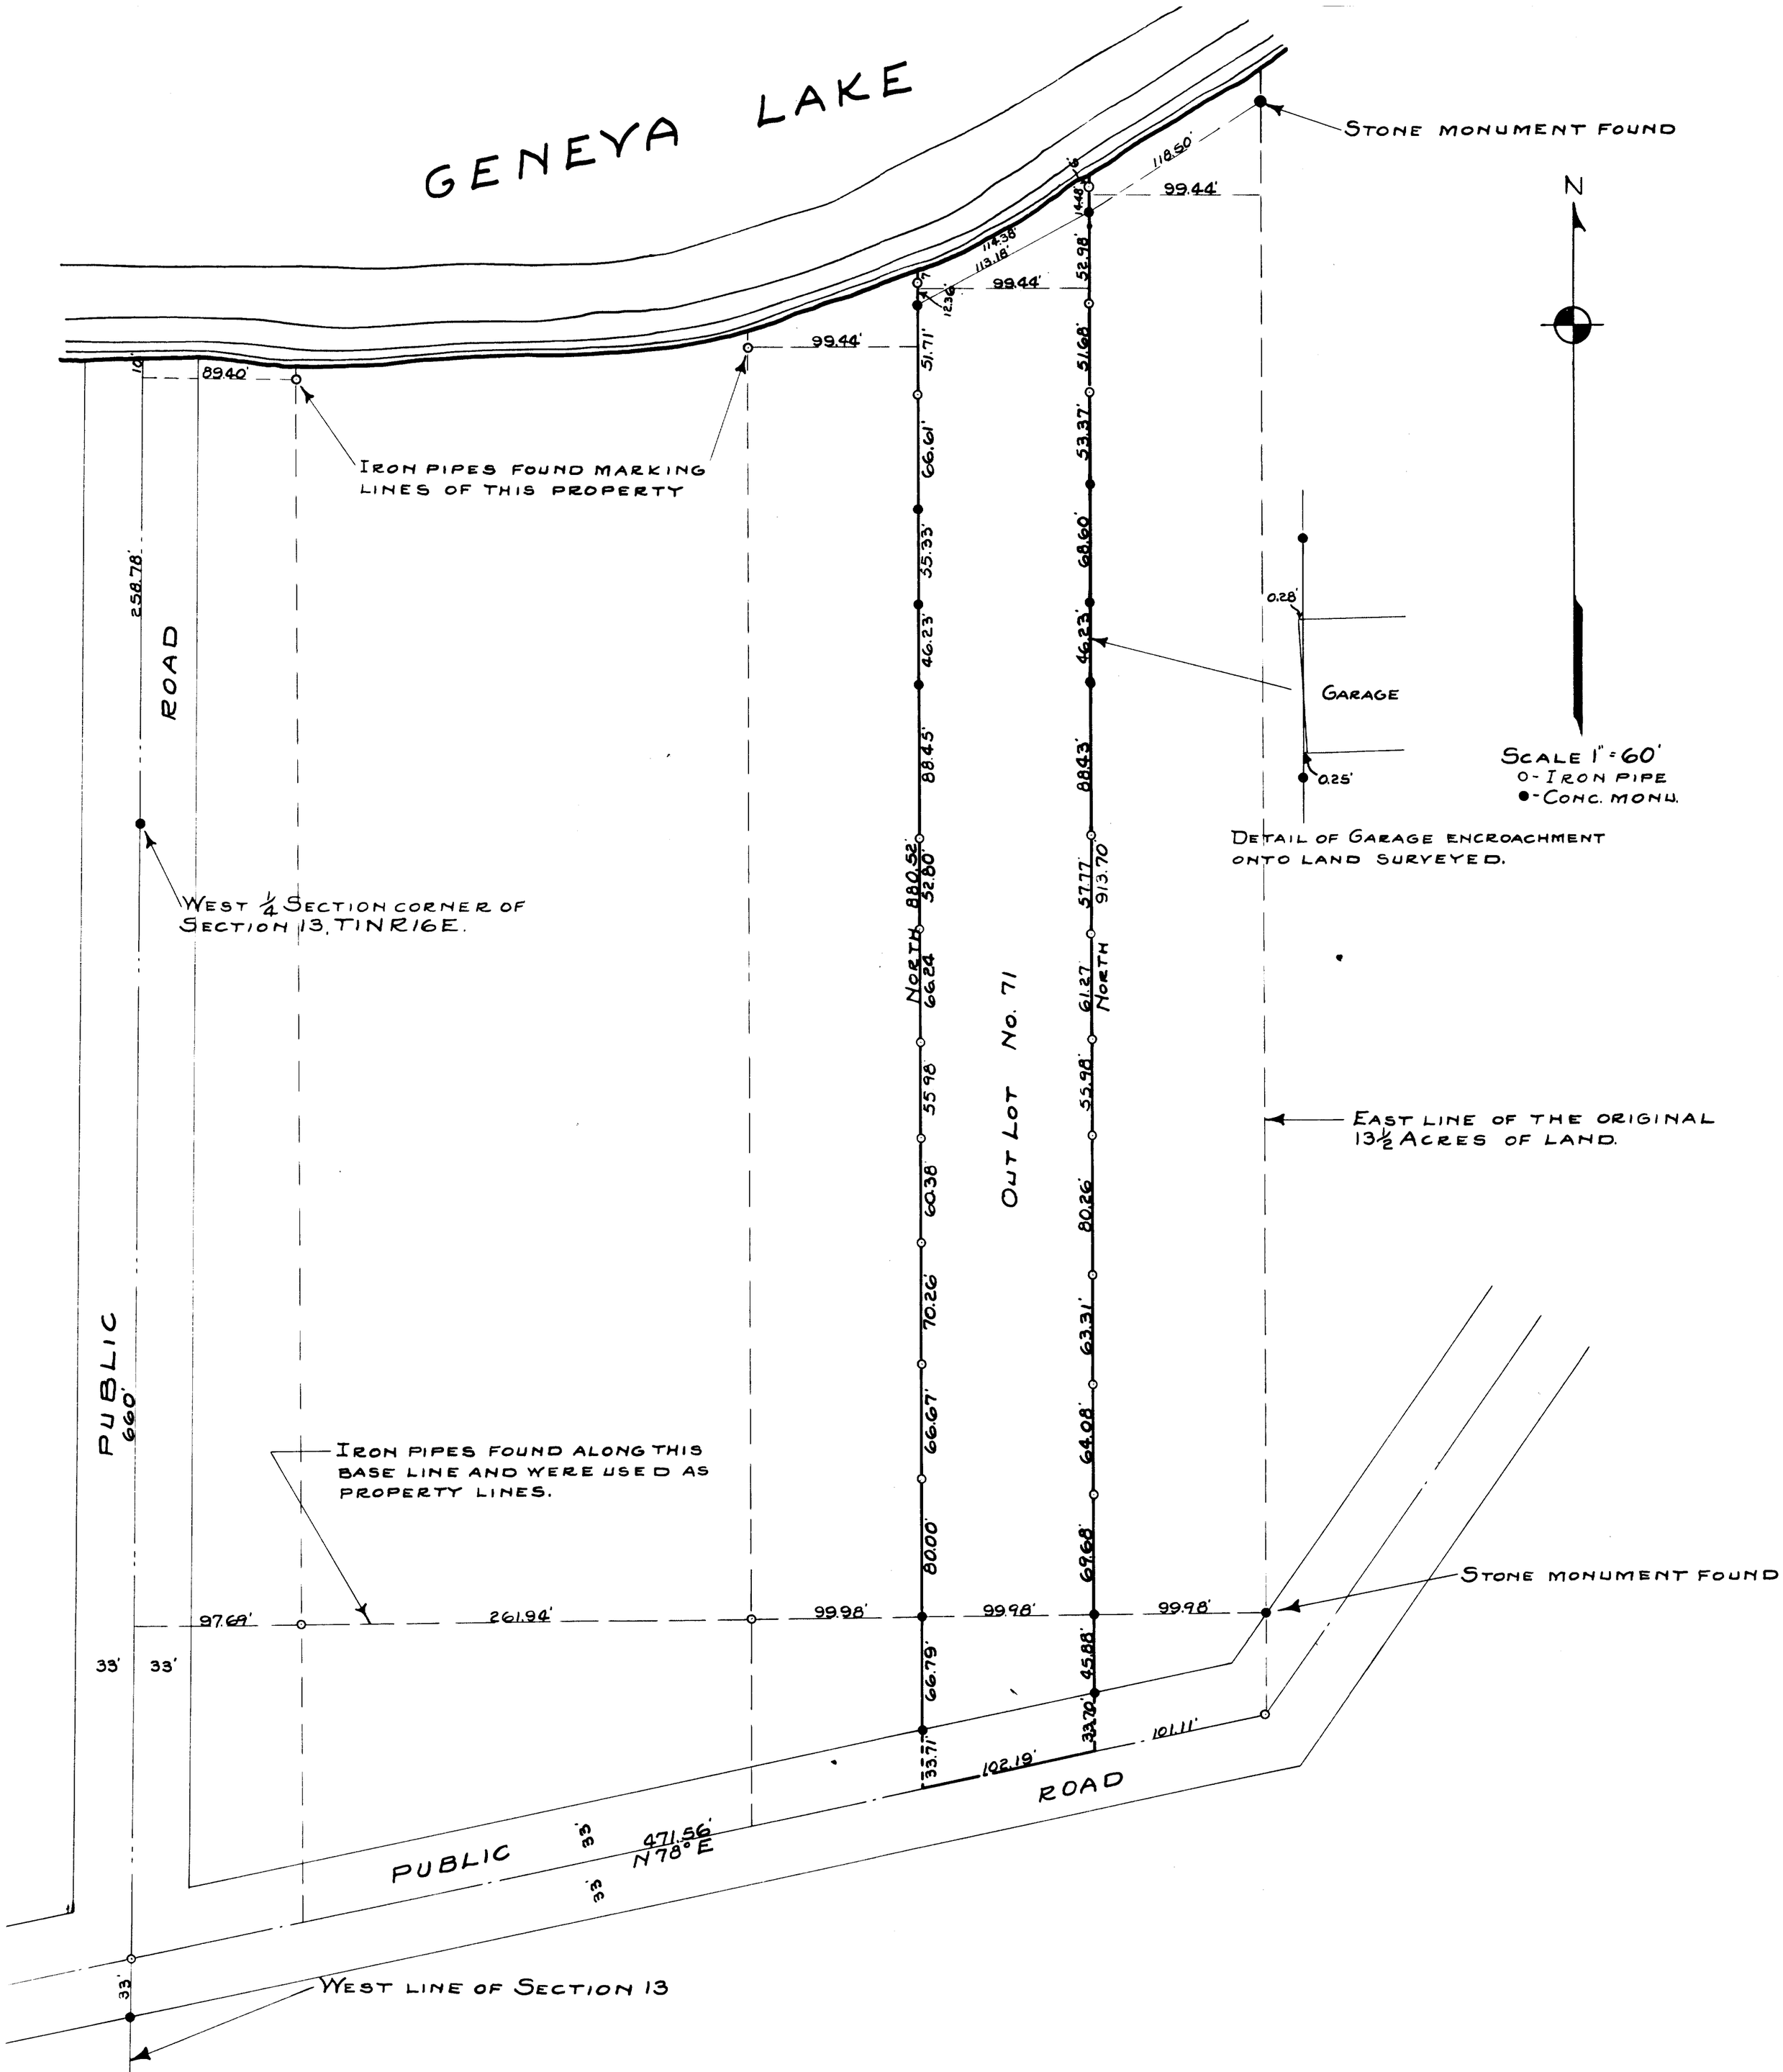

PLAT OF SURVEY OF LAND LOCATED IN THE WEST FRACTIONAL ½ OF SECTION 13, T1N R16E OF WALWORTH COUNTY WISCONSIN: THE WESTERLY 100 FEET OF THE EASTERLY 200 FEET OF THE FOLLOWING DESCRIBED LAND: COMMENCING AT THE ¼ SEC. COR. ON THE WEST LINE OF SEC. 13, T1N R16E; THENCE SOUTH IN THE AFORESAID WEST LINE 10 CHAINS (660 FEET) TO THE CENTER OF THE HIGHWAY; THENCE N 78° E 674.86 FEET IN THE CENTER OF SAID HIGHWAY; THENCE NORTH 15.06 CHAINS TO THE LOW WATER LINE OF GENEVA LAKE; THENCE WEST ALONG SAID LOW WATER LINE TO THE WEST LINE OF SAID SECTION 13; THENCE SOUTH ALONG THE SAID WEST LINE 268.78 FEET TO THE PLACE OF BEGINNING, CONTAINING 13.50 ACRES OF LAND.

SEPT. 1943

Floyd L. Jensen
COUNTY SURVEYOR

ST FV-112

5-14 J