HAROLD H. KOLB

REGISTERED PROFESSIONAL LAND SURVEYOR
LAKE GENEVA, WISCONSIN

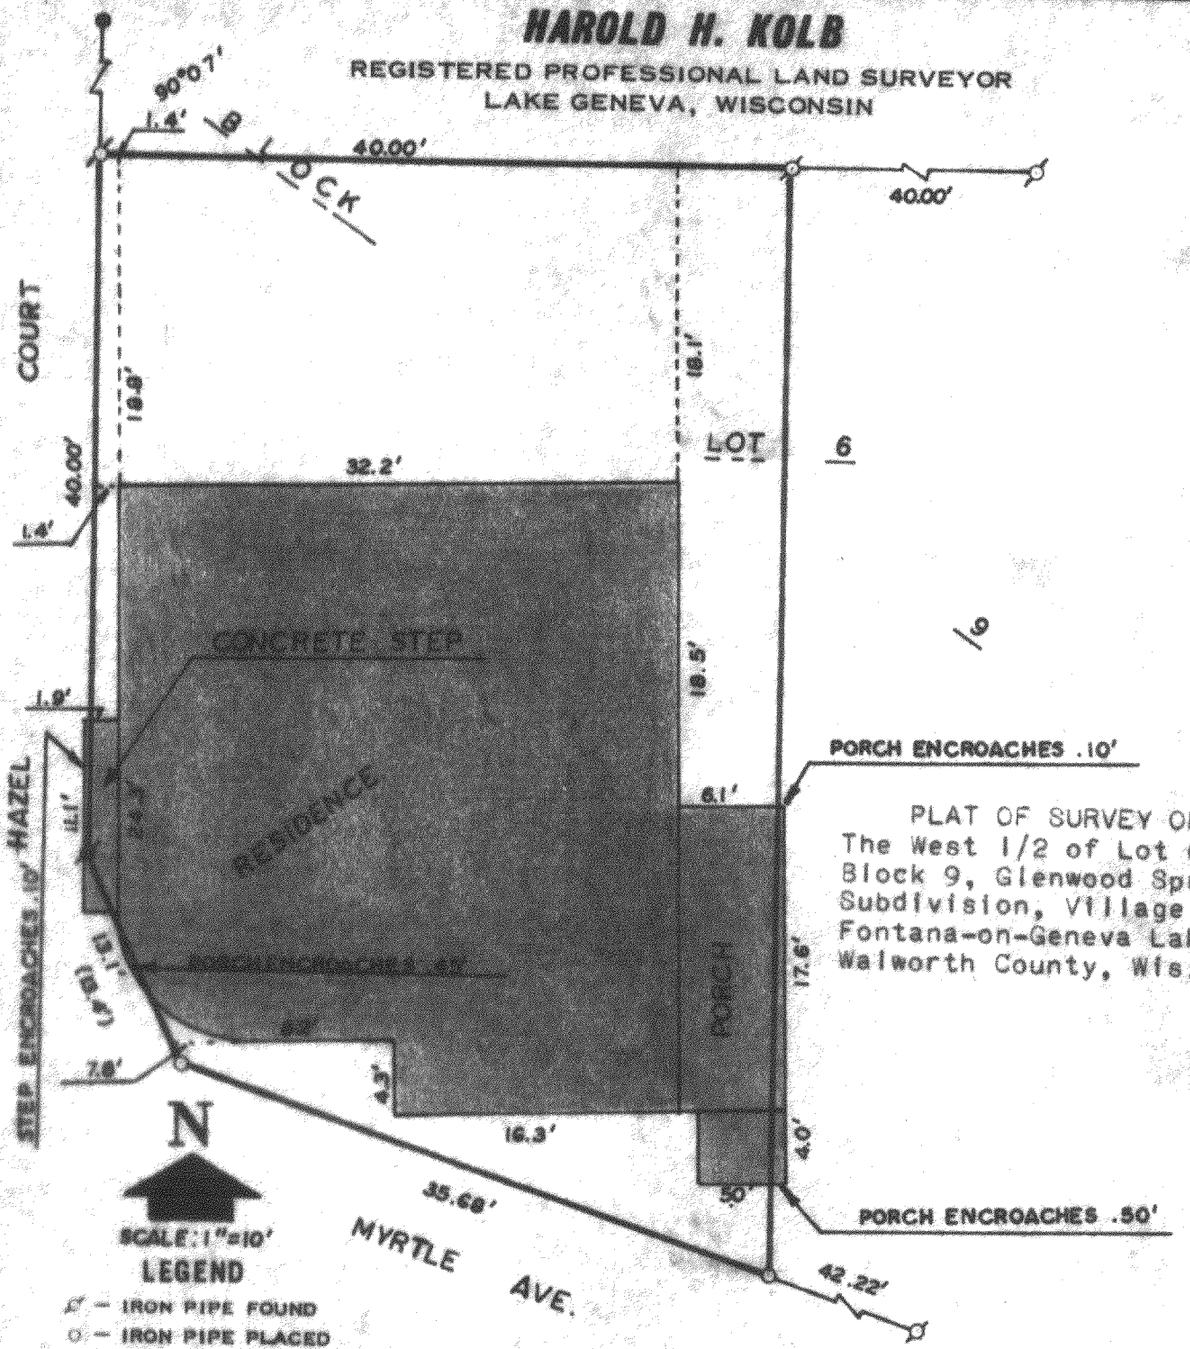

SCALE: 1"=10'

LEGEND

- ⌀ — IRON PIPE FOUND
- ○ — IRON PIPE PLACED
- ● — CONCRETE MONUMENT FOUND
- X — SPIKE
- ( )— AS RECORDED
- ⌀ — IRON ROD FOUND

PLAT OF SURVEY OF
The West 1/2 of Lot 6, Block 9, Glenwood Springs Subdivision, Village of Fontana-on-Geneva Lake, Walworth County, Wis.

I, HAROLD H. KOLB, DO HEREBY CERTIFY THAT I HAVE SURVEYED THE PROPERTY HEREON DESCRIBED ACCORDING TO THE OFFICIAL RECORDS, AND THAT THE PLAT HEREON IS A CORRECT REPRESENTATION OF THE LOT LINES, and the principle lines of the buildings thereon.

Harold H. Kolb

HAROLD H. KOLB
WISCONSIN REGISTERED LAND SURVEYOR, S—187
DATE May 11, 1967

565-48

5-189