LAND-MARK SURVEYING
Mark L. Miritz
Wisconsin Registered Land Surveyor S-2582

N9330 Knuteson Drive
Whitewater, WI 53190
Phone:(262)495-3284
FAX : (262) 495-8421
LAND-MARKSURVEYING.COM

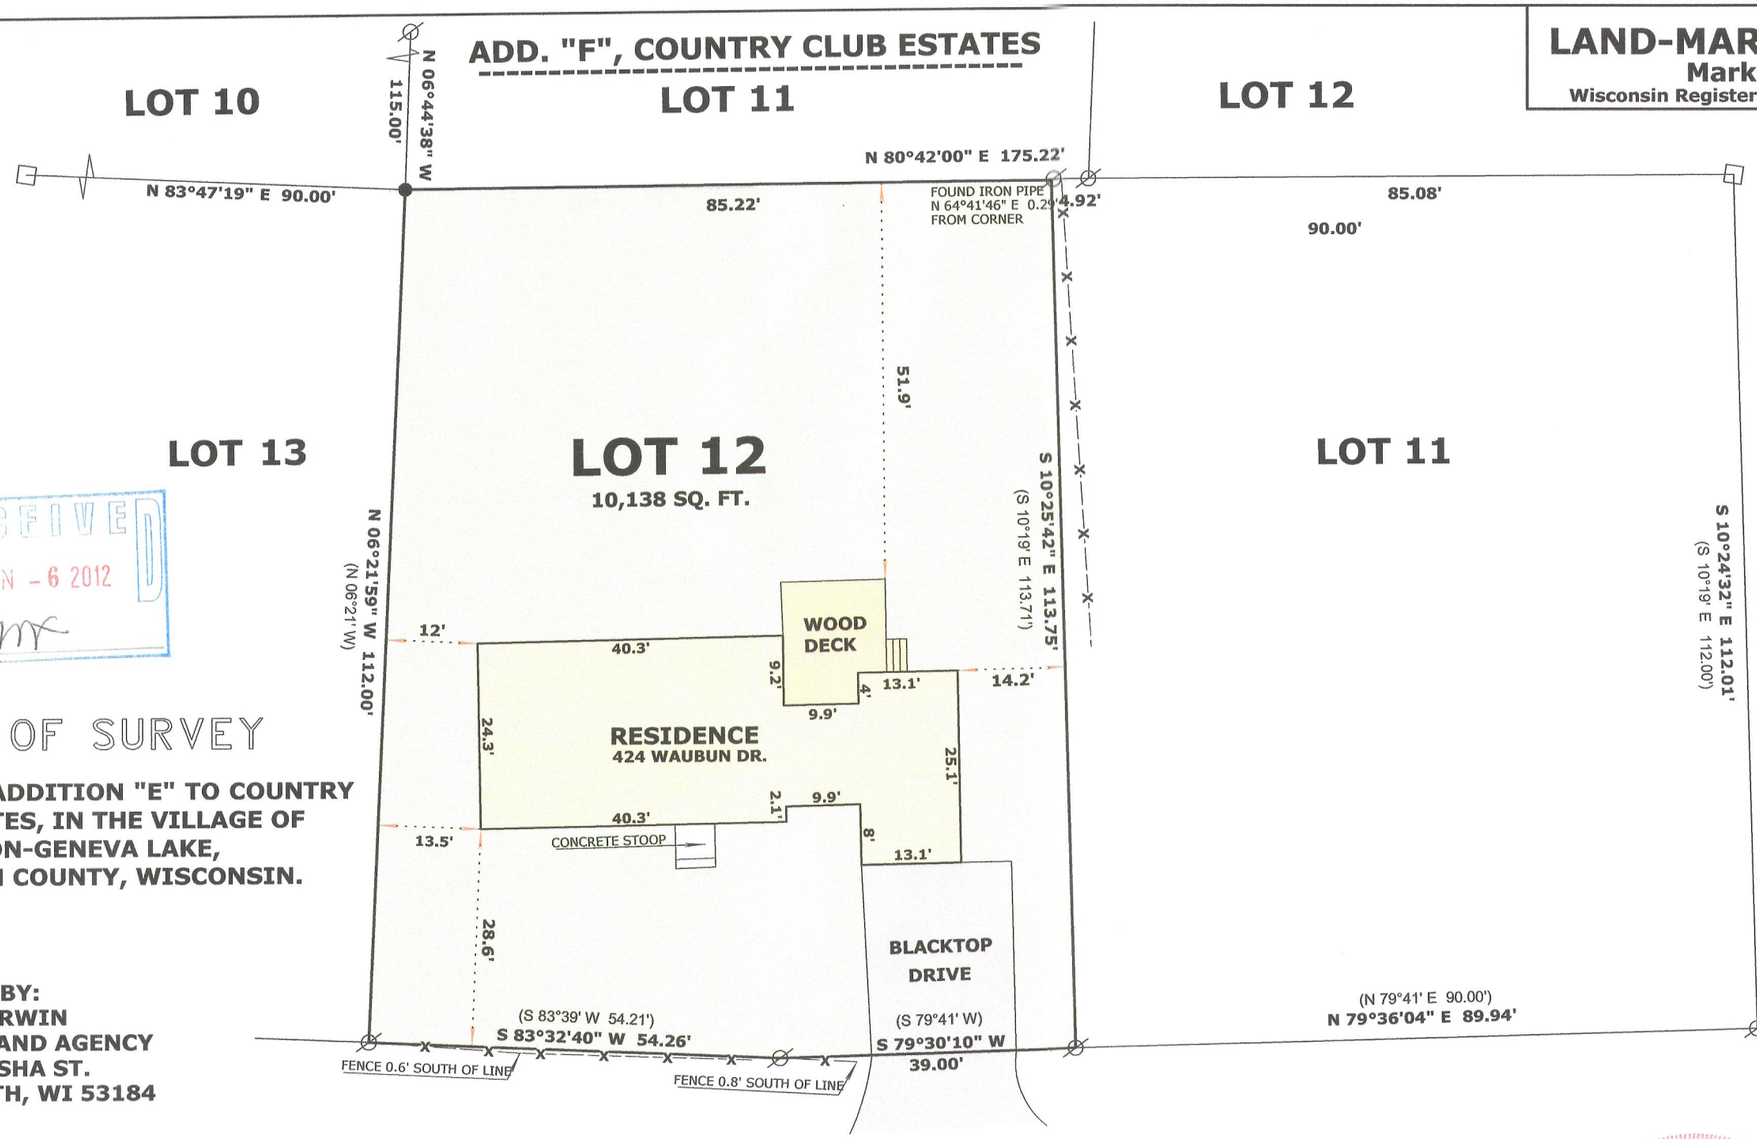

RECEIVED
JUN - 6 2012
By

PLAT OF SURVEY

LOT 12 IN ADDITION "E" TO COUNTRY CLUB ESTATES, IN THE VILLAGE OF FONTANA-ON-GENEVA LAKE, WALWORTH COUNTY, WISCONSIN.

ORDERED BY:
BECKY MERWIN
THE RAULAND AGENCY
118 KENOSHA ST.
WALWORTH, WI 53184

LEGEND

⌀	FOUND IRON PIPE
□	FOUND CONCRETE MONUMENT
●	SET IRON ROD, 18" LONG, WEIGHING 1.5 LBS./LINEAL FT., 3/4" DIA.
(x x)	RECORDED AS DIMENSION
—x—x—	EXISTING FENCE

SCALE: 1 INCH = 20 FEET

"I hereby certify that the above described property has been surveyed by me or under my direction and that the above map is a true representation thereof and shows the size and location of the property, its exterior boundaries, the location of all visible structures and dimensions of all principal buildings thereon, boundary fences, apparent easements, roadways and visible encroachments, if any."
"This survey is made for the use of the present owners of the property, and also those who purchase, mortgage, or guarantee the title thereto within one year from date hereof."

WISCONSIN MARK L. MIRITZ S-2582 WHITEWATER, WI LAND SURVEYOR

Mark L. Miritz
MARK L. MIRITZ
WISCONSIN REGISTERED
LAND SURVEYOR S-2582

DATE: FEB. 1, 2012 JOB NO. 12.104

SCTE - 12

005-2911