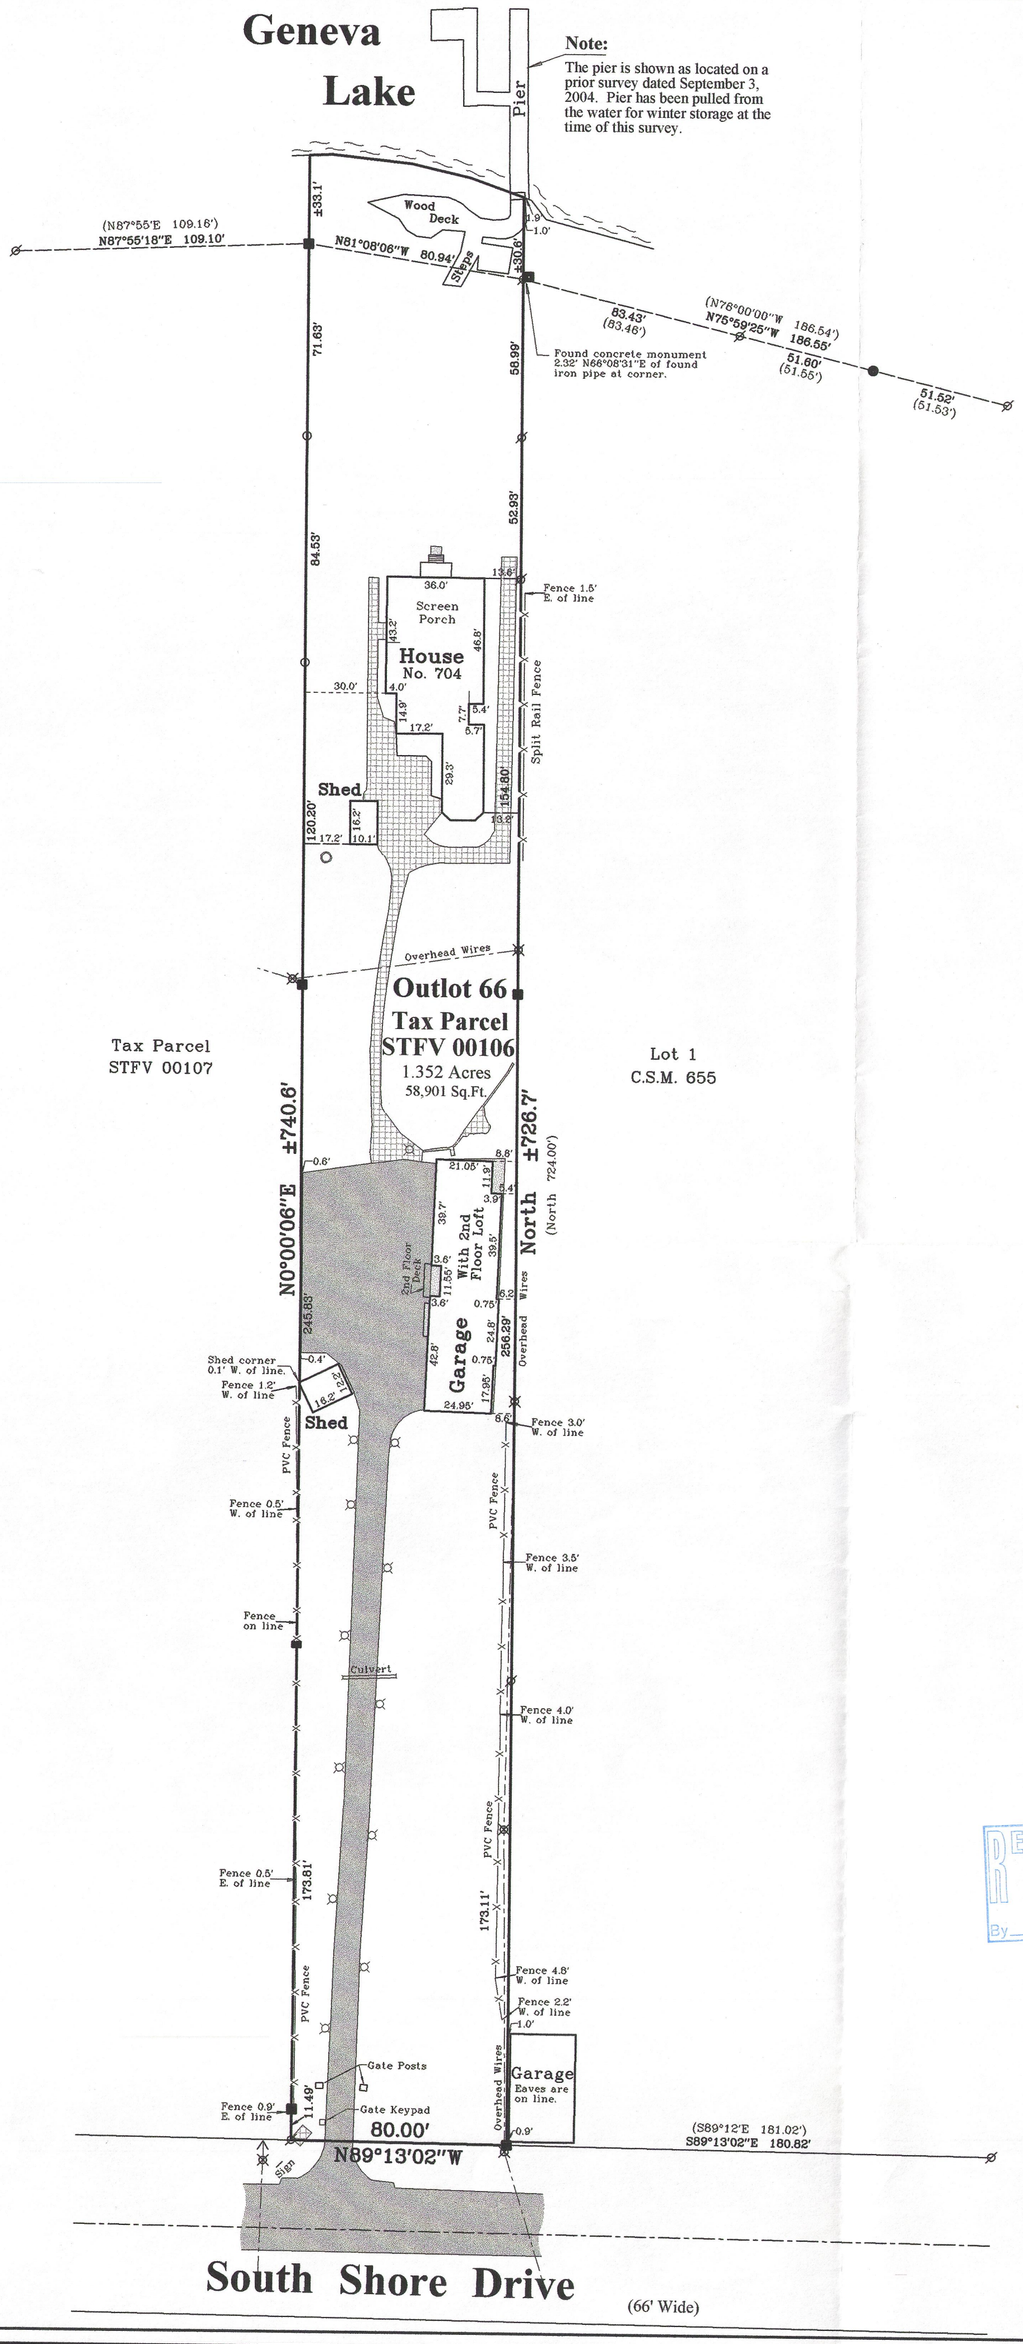

Note:
The pier is shown as located on a prior survey dated September 3, 2004. Pier has been pulled from the water for winter storage at the time of this survey.

Plat of Survey

of

A parcel of land described in a Warranty Deed recorded January 13, 2012 as Document No. 830161 as follows:
The West 60 feet of the East 1 chain and 98 1/2 links of the West 1/2 of the Northwest 1/4 of Section 13, T1N, R16E; also a strip of land 20 feet in width lying West of and adjoining said 1 chain and 98 1/2 links of the West 1/2 of the Northwest 1/4 of Section 13 aforesaid; also known and described as Outlot 66 of the Assessor's Plat of the Village of Fontana-on-Geneva Lake, Walworth County, Wisconsin, as recorded in Volume 11 of Plats at Page 16.

Surveyed for: **Angela Galioto**
6128 North Keating Avenue
Chicago, Illinois. 60645

Bearings reference to Ceritifed Survey Map No. 655.

WISCONSIN
DOUGLAS OLSON
S-2093
ELKHORN, WI
LAND SURVEYOR
Not Certified Unless Stamped in Red.

RECEIVED
APR 16 2013
By

Notes:

1) This survey plat is not certified unless signed and sealed in red ink.
2) This survey is subject to Wisconsin lien laws. This Plat of Survey is the notice of intent to file lien. Lien waiver required.

Copyright 2012 by Jensen & Olson Land Surveying, LLC.

All rights reserved. No part of this survey plat may be reproduced or transmitted in any form by any means - graphic, electronic, or mechanical, including photocopying, tracing, or information storage and retrieval systems - without permission in writing from Douglas G. Olson, Jensen & Olson Land Surveying, LLC.

I hereby certify that I have surveyed the above described property and the map hereon is correct to the best of my professional knowledge and belief and shows the size and location of the property, its exterior boundaries, the location and dimensions of all visible structures thereon, boundary fences, apparent easements and roadways and visible encroachments, if any.
This survey is made for the exclusive use of the present owners of the property, and also those who purchase, mortgage or guarantee title thereto, within one year from the date hereof.

Douglas G. Olson
Wisconsin Registered Land Surveyor - 2093

STFV 00106 005-2969

2012.113

Sheet 1 of 1 Sheets

Drawing Name: t1nr16e-2012113-2012113PlatNEW.sc

Job Reference Number
2012.113

Legend
- Found Concrete Monument
- Found Iron Pipe
- Set Iron Pipe, 1"
- Found Iron Rod
- Recorded Information
- Utility Pole
- Lamp
- Catch Basin
- Asphalt Surface
- Concrete
- Brick Pavers

Jensen & Olson Land Surveying, LLC
45 South Wisconsin Street * P.O. Box 322 * Elkhorn, Wisconsin. 53121
Telephone: (262) 723-3434 * Facsimile: (262) 723-8044
Email: jensen.olson@elknet.net

Scale in Feet
1" = 40'
0' 20' 40' 80'

Survey Date: November 14, 2012.
Revisions: