
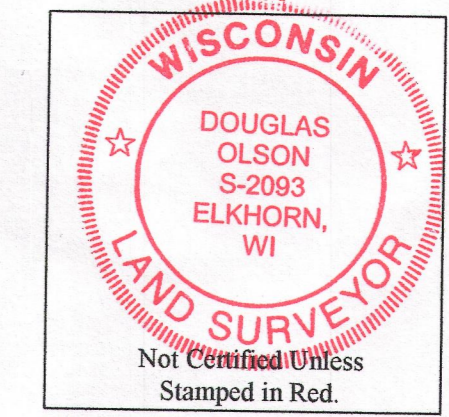
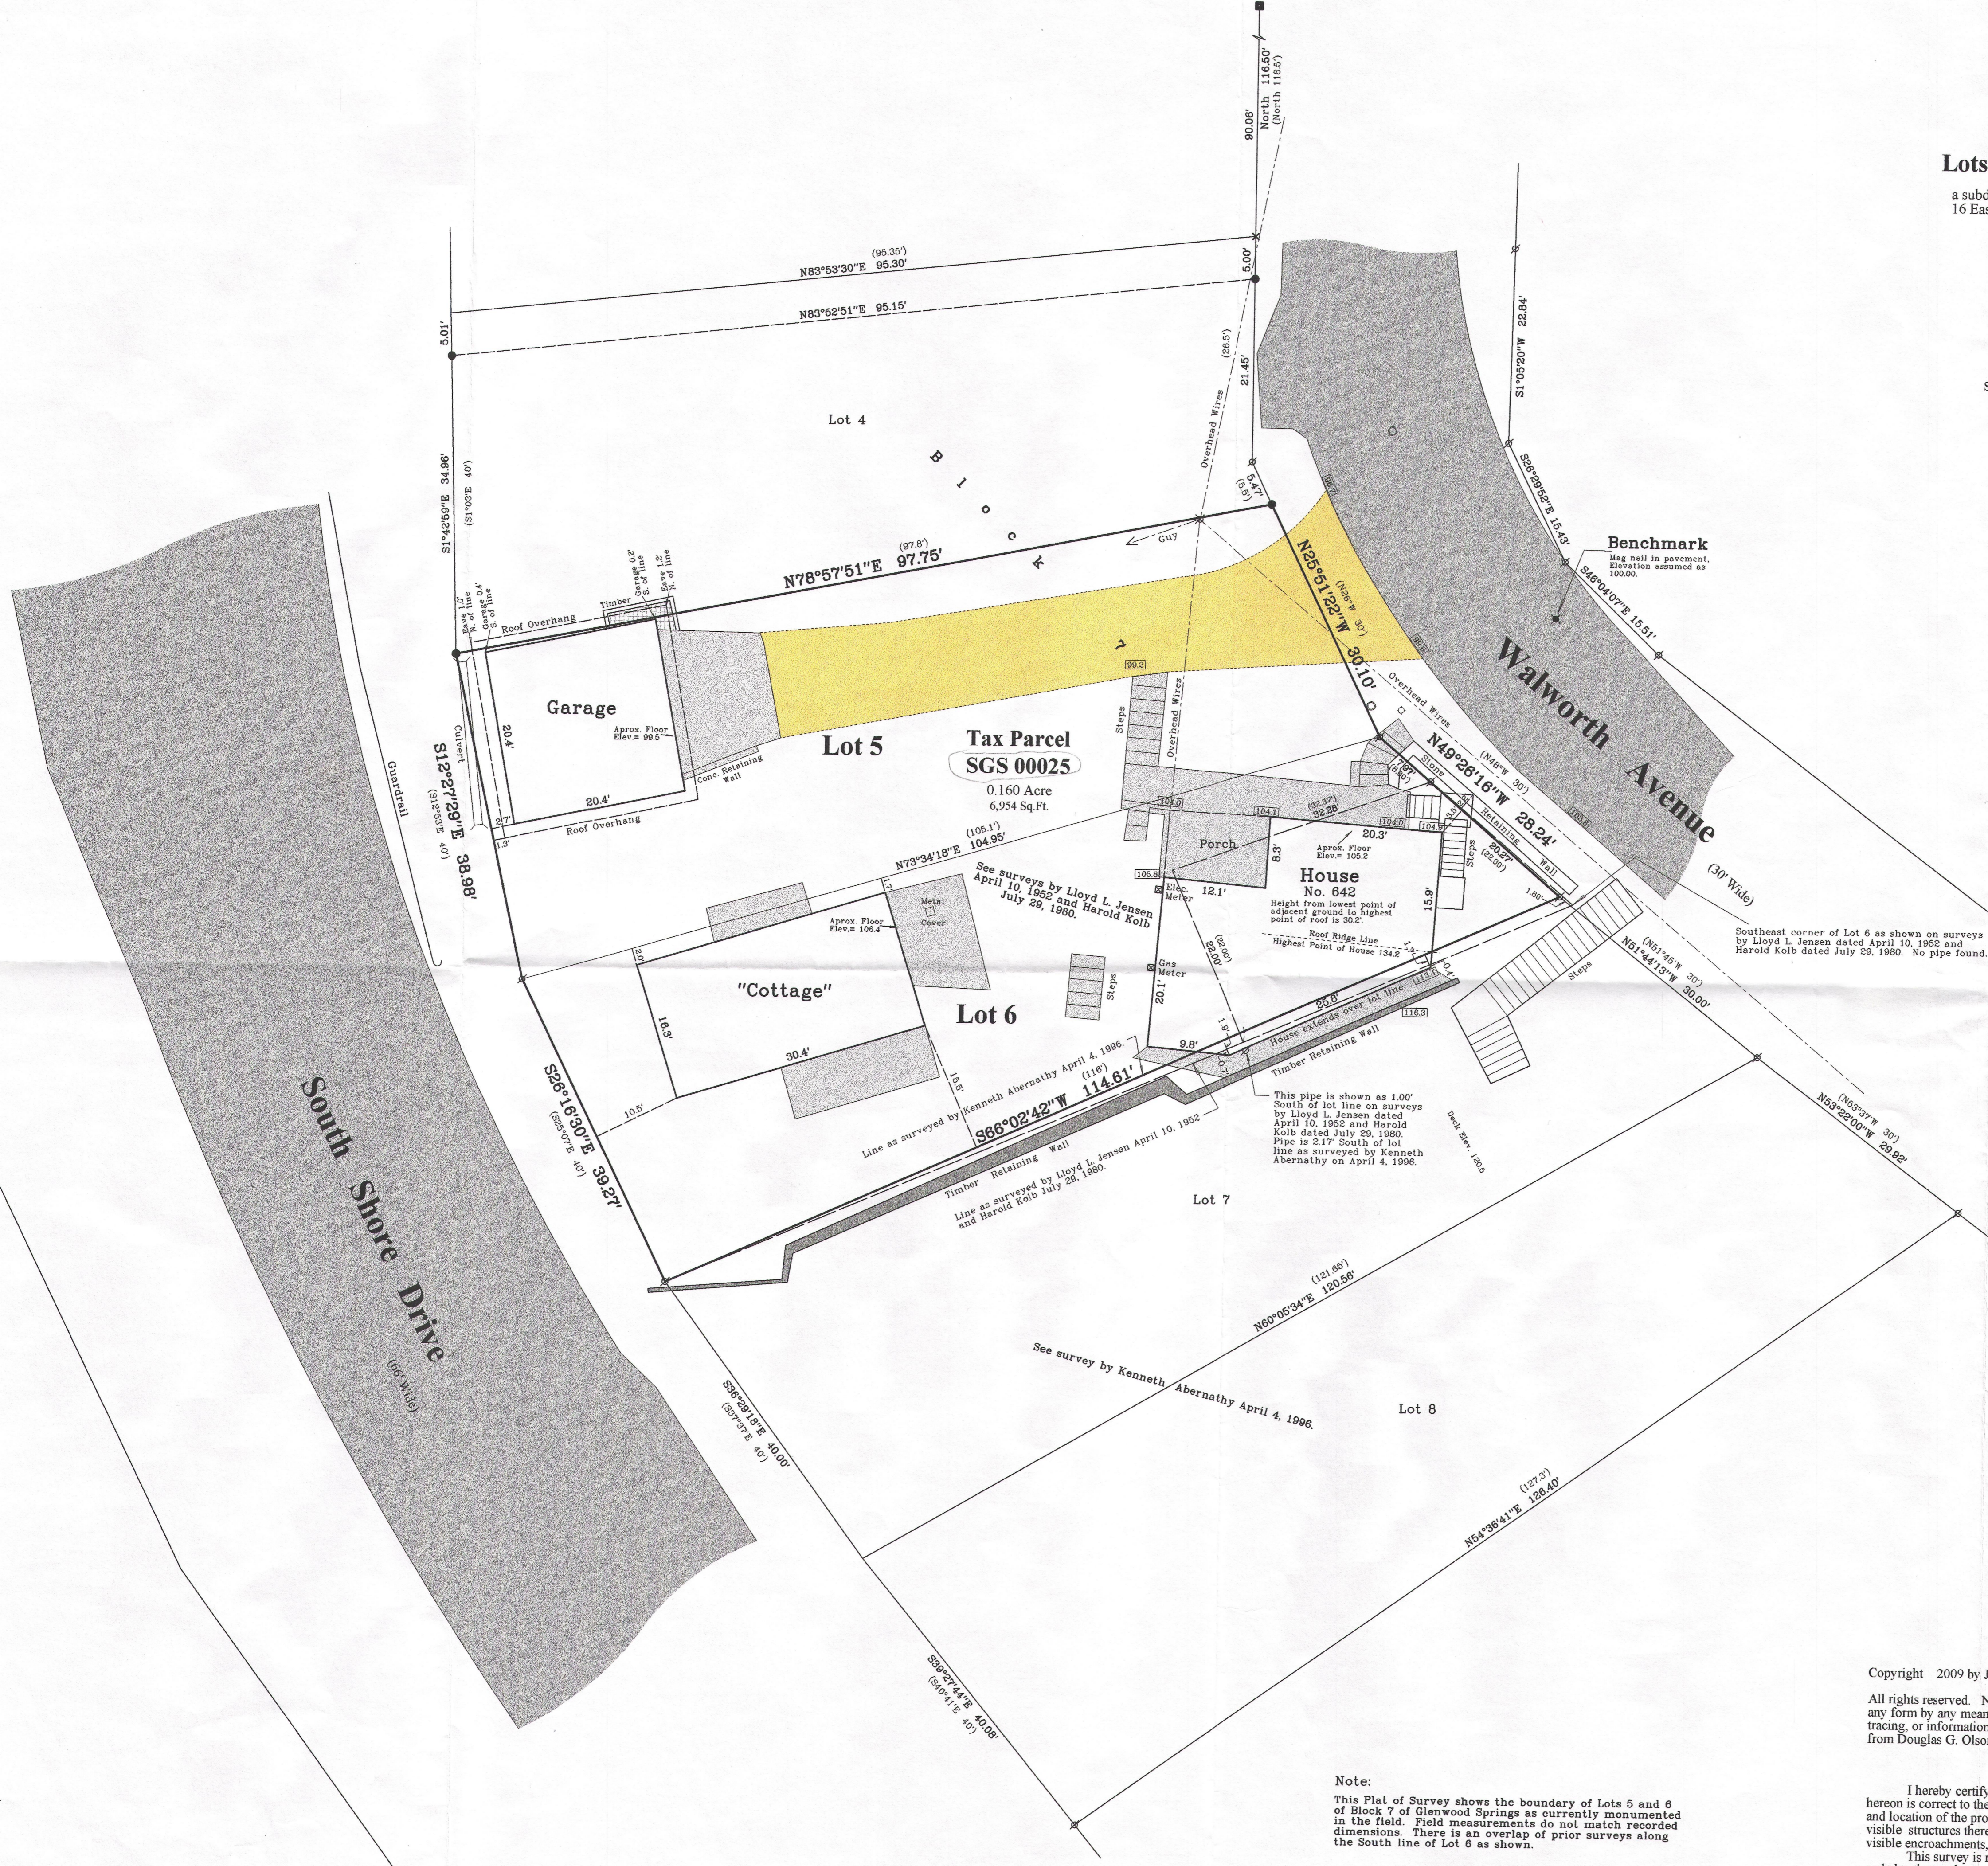


Plat of Survey

of
Lots 5 & 6 of Block 7 of Glenwood Springs,
 a subdivision located in the Southeast 1/4 of Section 14, Town 1 North, Range 16 East, Village of Fontana-on-Geneva Lake, Walworth County, Wisconsin.

Surveyed for: **Marc Jensen**
 646 Linden Drive
 Fontana, Wisconsin, 53125

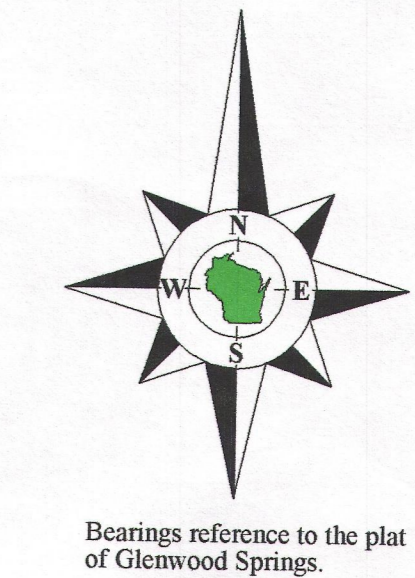


- Notes:**
- 1) This survey plat is not certified unless signed and sealed in red ink.
 - 2) This survey is subject to Wisconsin lien laws. This Plat of Survey is the notice of intent to file lien. Lien waiver required.

Copyright © 2009 by Jensen & Olson Land Surveying, LLC.

All rights reserved. No part of this survey plat may be reproduced or transmitted in any form by any means - graphic, electronic, or mechanical, including photocopying, tracing, or information storage and retrieval systems - without permission in writing from Douglas G. Olson, Jensen & Olson Land Surveying, LLC.

I hereby certify that I have surveyed the above described property and the map hereon is correct to the best of my professional knowledge and belief and shows the size and location of the property, its exterior boundaries, the location and dimensions of all visible structures thereon, boundary fences, apparent easements and roadways and visible encroachments, if any.
 This survey is made for the exclusive use of the present owners of the property, and also those who purchase, mortgage or guarantee title thereto, within one year from the date hereof.

Douglas G. Olson
 Wisconsin Registered Land Surveyor - 2093

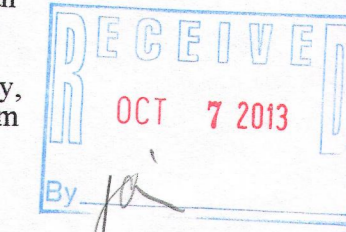

Note:
 This Plat of Survey shows the boundary of Lots 5 and 6 of Block 7 of Glenwood Springs as currently monumented in the field. Field measurements do not match recorded dimensions. There is an overlap of prior surveys along the South line of Lot 6 as shown.
 Total area of onsite impervious surfaces is 3,188 sq.ft. or 46% of parcel.

Survey date: June 9, 2009.
 REVISIONS: No. 1 - Spot Elevations and Impervious area

Scale in Feet
 1" = 10'
 0' 5' 10' 20' 30'

Jensen & Olson Land Surveying, LLC
 45 South Wisconsin Street * P.O. Box 322 * Elkhorn, Wisconsin, 53121
 Telephone: (262) 723-3434 * Facsimile: (262) 723-8044
 Email: jensen.olson@elknet.net

- Legend**
- Found Concrete Monument
 - Found Iron Pipe
 - Found Chiseled cross
 - Recorded Information
 - Spot Elevation
 - Utility Pole
 - Water Valve
 - Spot Surface
 - Concrete Surface
 - Brick Pavers
 - Gravel Surface

Sheet 1 of 1 Sheets
 Drawing Name: Item (62-201309)-2013093 Plat.dwg
 Job Reference Number
2013.093