ROBERS & BOYD, INC.
CONSULTING ENGINEERS & LAND SURVEYORS
PHONE (414) 763-2652 116 E. CHESTNUT ST. BURLINGTON, WIS. 53105

PLAT OF SURVEY & HOUSE LOCATION OF

LOTS 9 AND 10, BLOCK 7, GLENWOOD SPRINGS SUBDIVISION, VILLAGE OF FONTANA-ON-GENEVA LAKE, WALWORTH COUNTY, WISCONSIN

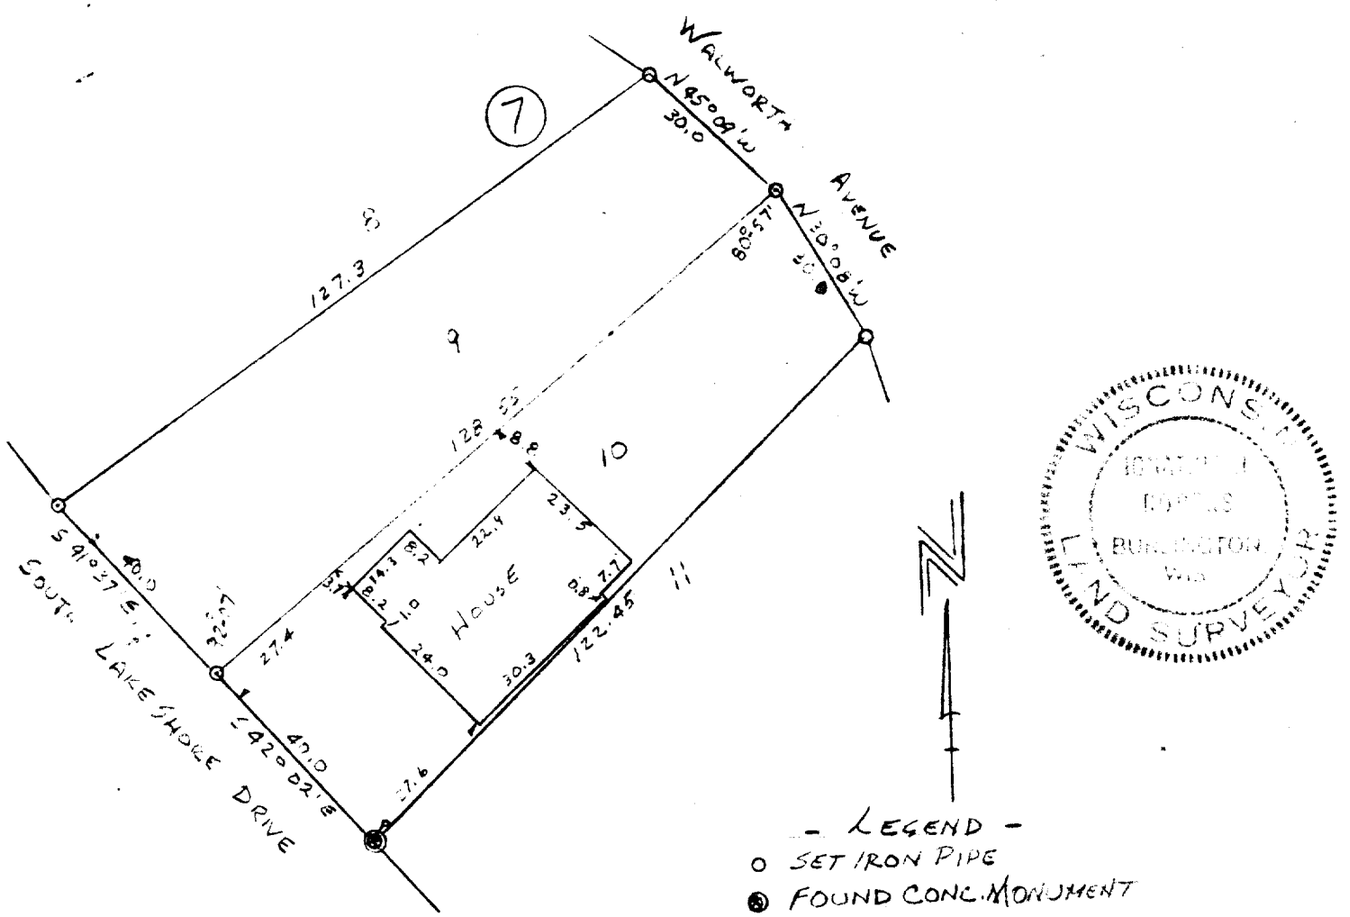

- LEGEND -
o SET IRON PIPE
● FOUND CONC. MONUMENT
SCALE 1" = 30'

WISCONSIN IGNATIUS H. ROBERS BURLINGTON WIS. LAND SURVEYOR

I HEREBY CERTIFY THAT WE HAVE SURVEYED THE LANDS DESCRIBED ABOVE ACCORDING TO OFFICIAL RECORDS AND THAT THE PLAT DRAWN HEREON IS A CORRECT REPRESENTATION OF SAID SURVEY.

Ignatius H. Robers
WIS. REG. LAND SURVEYOR S-00787

DATE 9-20-73

JOB NO. 73172

K & E 10-7155 250-8-72 SGS-29, 30

5-301