PREPARED FOR
TRICIA FORBECK
KEEFE REAL ESTATE
751 GENEVA PARKWAY
LAKE GENEVA WI. 53147

PLAT OF SURVEY OF

LOT 24, OF ADDITION "D" TO COUNTRY CLUB ESTATES, AS PER PLAT RECORDED JULY 25, 1953, IN VOLUME 12 OF PLATS, PAGE 85, AND LOCATED IN SECTION 14, TOWN 1 NORTH, RANGE 16 EAST, VILLAGE OF FONTANA, WALWORTH COUNTY, WISCONSIN.

KROTT SURVEYING INC.
(262) 248-3697
N 3705 WILLOW BEND LANE
LAKE GENEVA WI. 53147

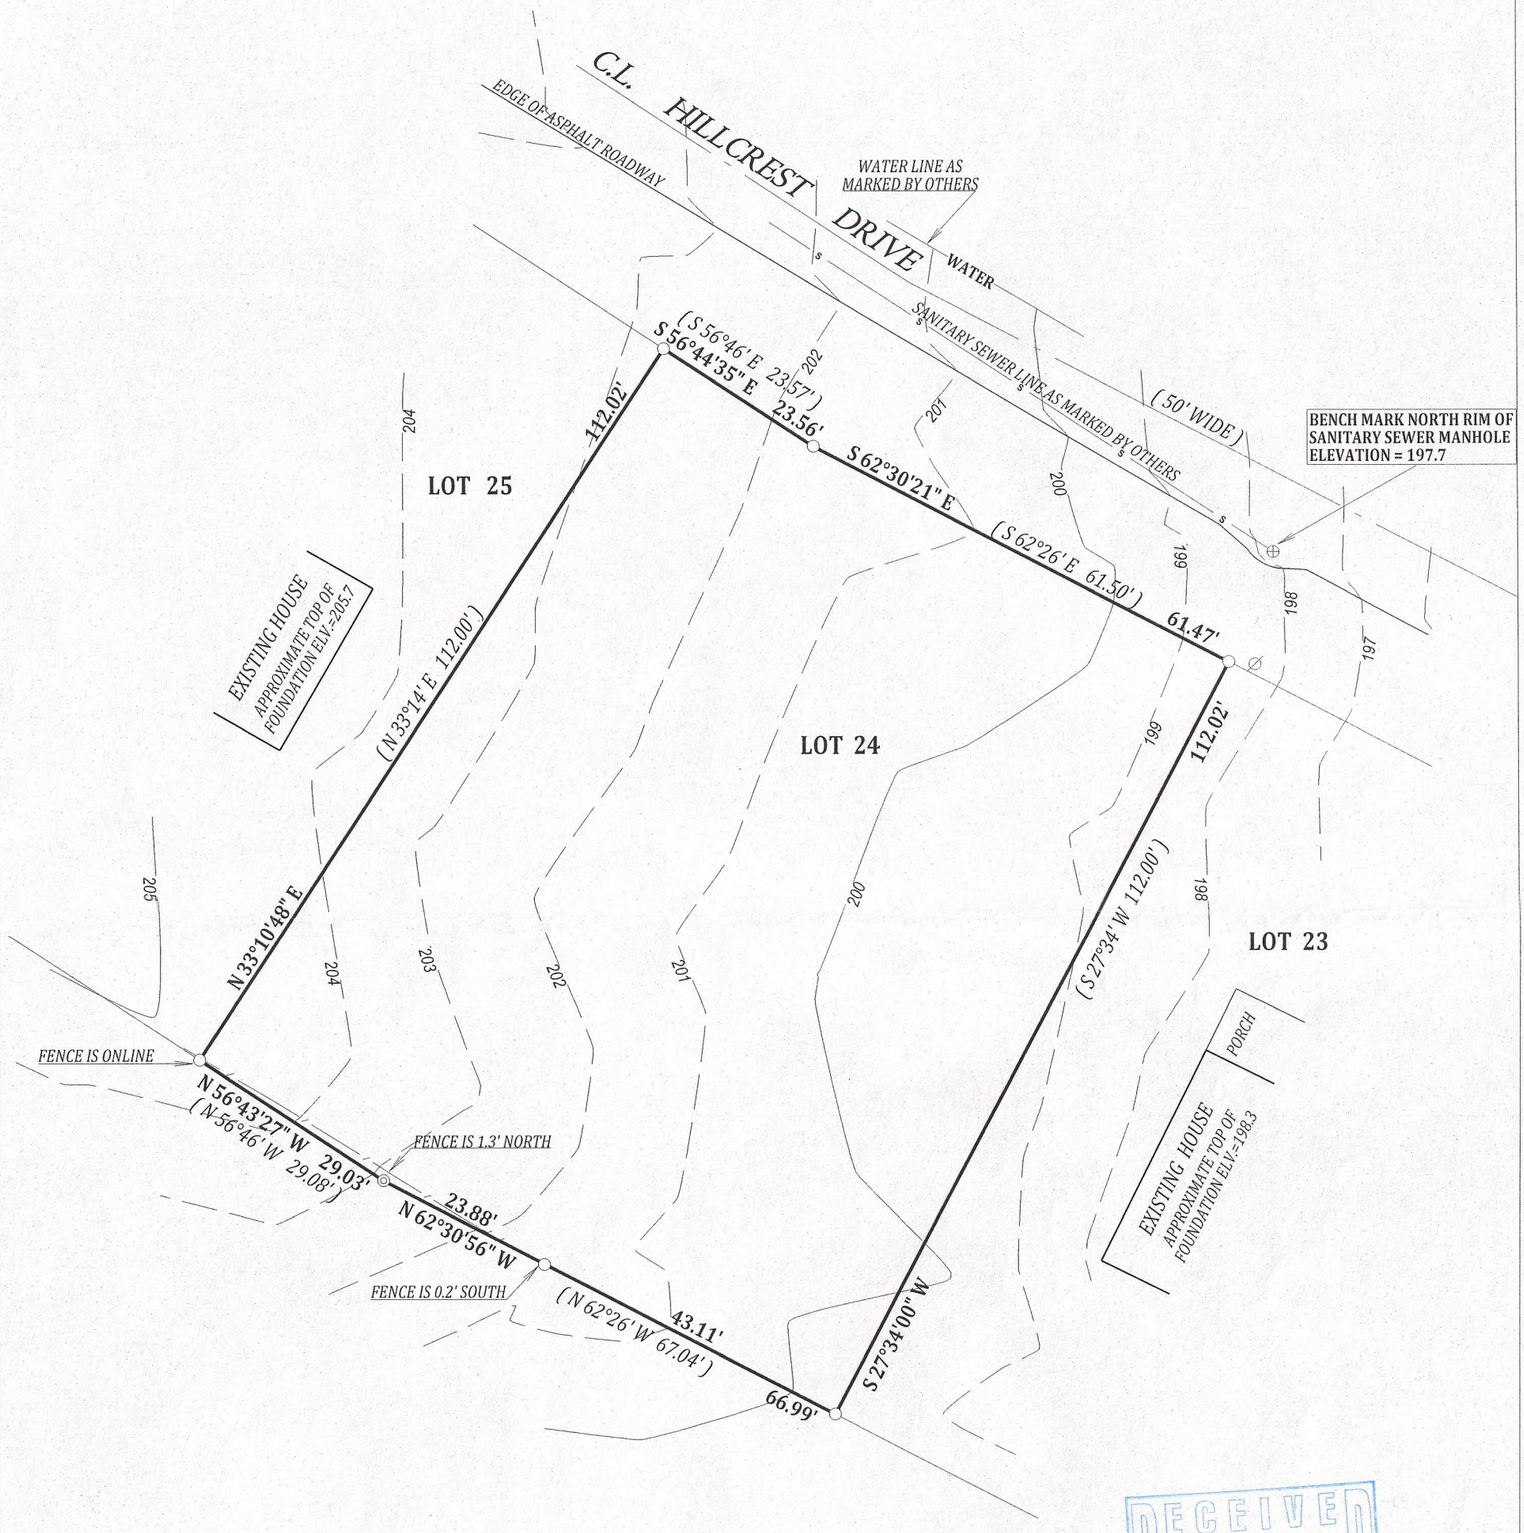

SCALE 1" = 20'

NOTE: BEARINGS ARE REFRENCED TO THE RECORD PLAT.

0 20 40 60

LEGEND

- ○ FOUND 1" DIA. IRON PIPE
- ◎ FOUND 2" DIA. IRON PIPE
- ⊕ SANITARY SEWER MAN HOLE
- ⌀ UTILITY POLE
- —·— WOOD FENCE
- (XX) RECORDED AS

TAX ID # SCTD00025

JOB # 13-151

I have surveyed the above-described property and the above map is a true representation thereof and shows the size and location of the property, its exterior boundaries, the location and dimensions of all structures thereon, fences apparent easements and roadways and visible encroachments. if any.

This survey is made for the exclusive use of the present owners of the property, and also those who puchase, mortgage,or insure the title therto within one (1) year from date hereof; and as to them I warrant the accuracy of said survey map.

RECEIVED
OCT 4 2013
By

WISCONSIN
JOHN P.
KROTT
S-2258
LAKE GENEVA
WIS.
LAND SURVEYOR

DATED THIS 2nd DAY OF OCTOBER 2013

JOHN P. KROTT S-2258
WISCONSIN REGISTERED LAND SURVEYOR
(NOTE: THIS IS NOT A CERTIFIED COPY UNLESS SIGNED IN RED INK)

005-3010