

# Plat of Survey


of  
**Lots 5 & 6 of Block 7 of Glenwood Springs,**  
 a subdivision located in the Southeast 1/4 of Section 14, Town 1 North, Range  
 16 East, Village of Fontana-on-Geneva Lake, Walworth County, Wisconsin.

Surveyed for: **Marc Jensen**  
 646 Linden Drive  
 Fontana, Wisconsin 53125



Bearings reference to the plat  
 of Glenwood Springs.

Survey date: June 9, 2009.  
 REVISIONS:  
 No. 1 - Spot Elevations and  
 Impervious Area  
 No. 2 - Proposed House  
 and Impervious Area  
 No. 3 - Proposed House as  
 shown on previous  
 No. 4 - Proposed House as  
 shown on previous  
 No. 5 - Proposed House as  
 shown on previous  
 No. 6 - Proposed House  
 with different  
 No. 7 - Foundation location  
 No. 8 - Roof Height

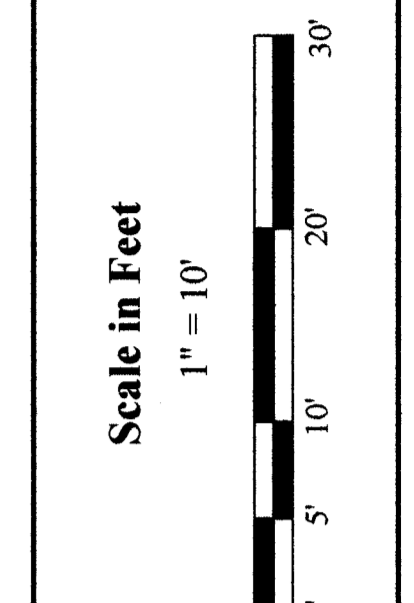


**Jensen & Olson Land Surveying, LLC**  
 45 South Wisconsin Street \* P.O. Box 322 \* Elkhorn, Wisconsin, 53121  
 Telephone: (262) 723-3434 \* Facsimile: (262) 723-8044  
 Email: jensen.olson@elknet.net

**Legend**  
 Found Concrete Monument  
 Found Iron Pipe  
 Found Channeled cross  
 Recorded Information  
 Spot Elevation  
 Utility Pole  
 Water Valve  
 Gravel Surface  
 Concrete Surface

Sheet 1 of 1 Sheets  
 Drawing Name: 1116-201309-2013093 (Plat.sj)  
 Job Reference Number  
**2013.093**  
**2013.093**


2013.093

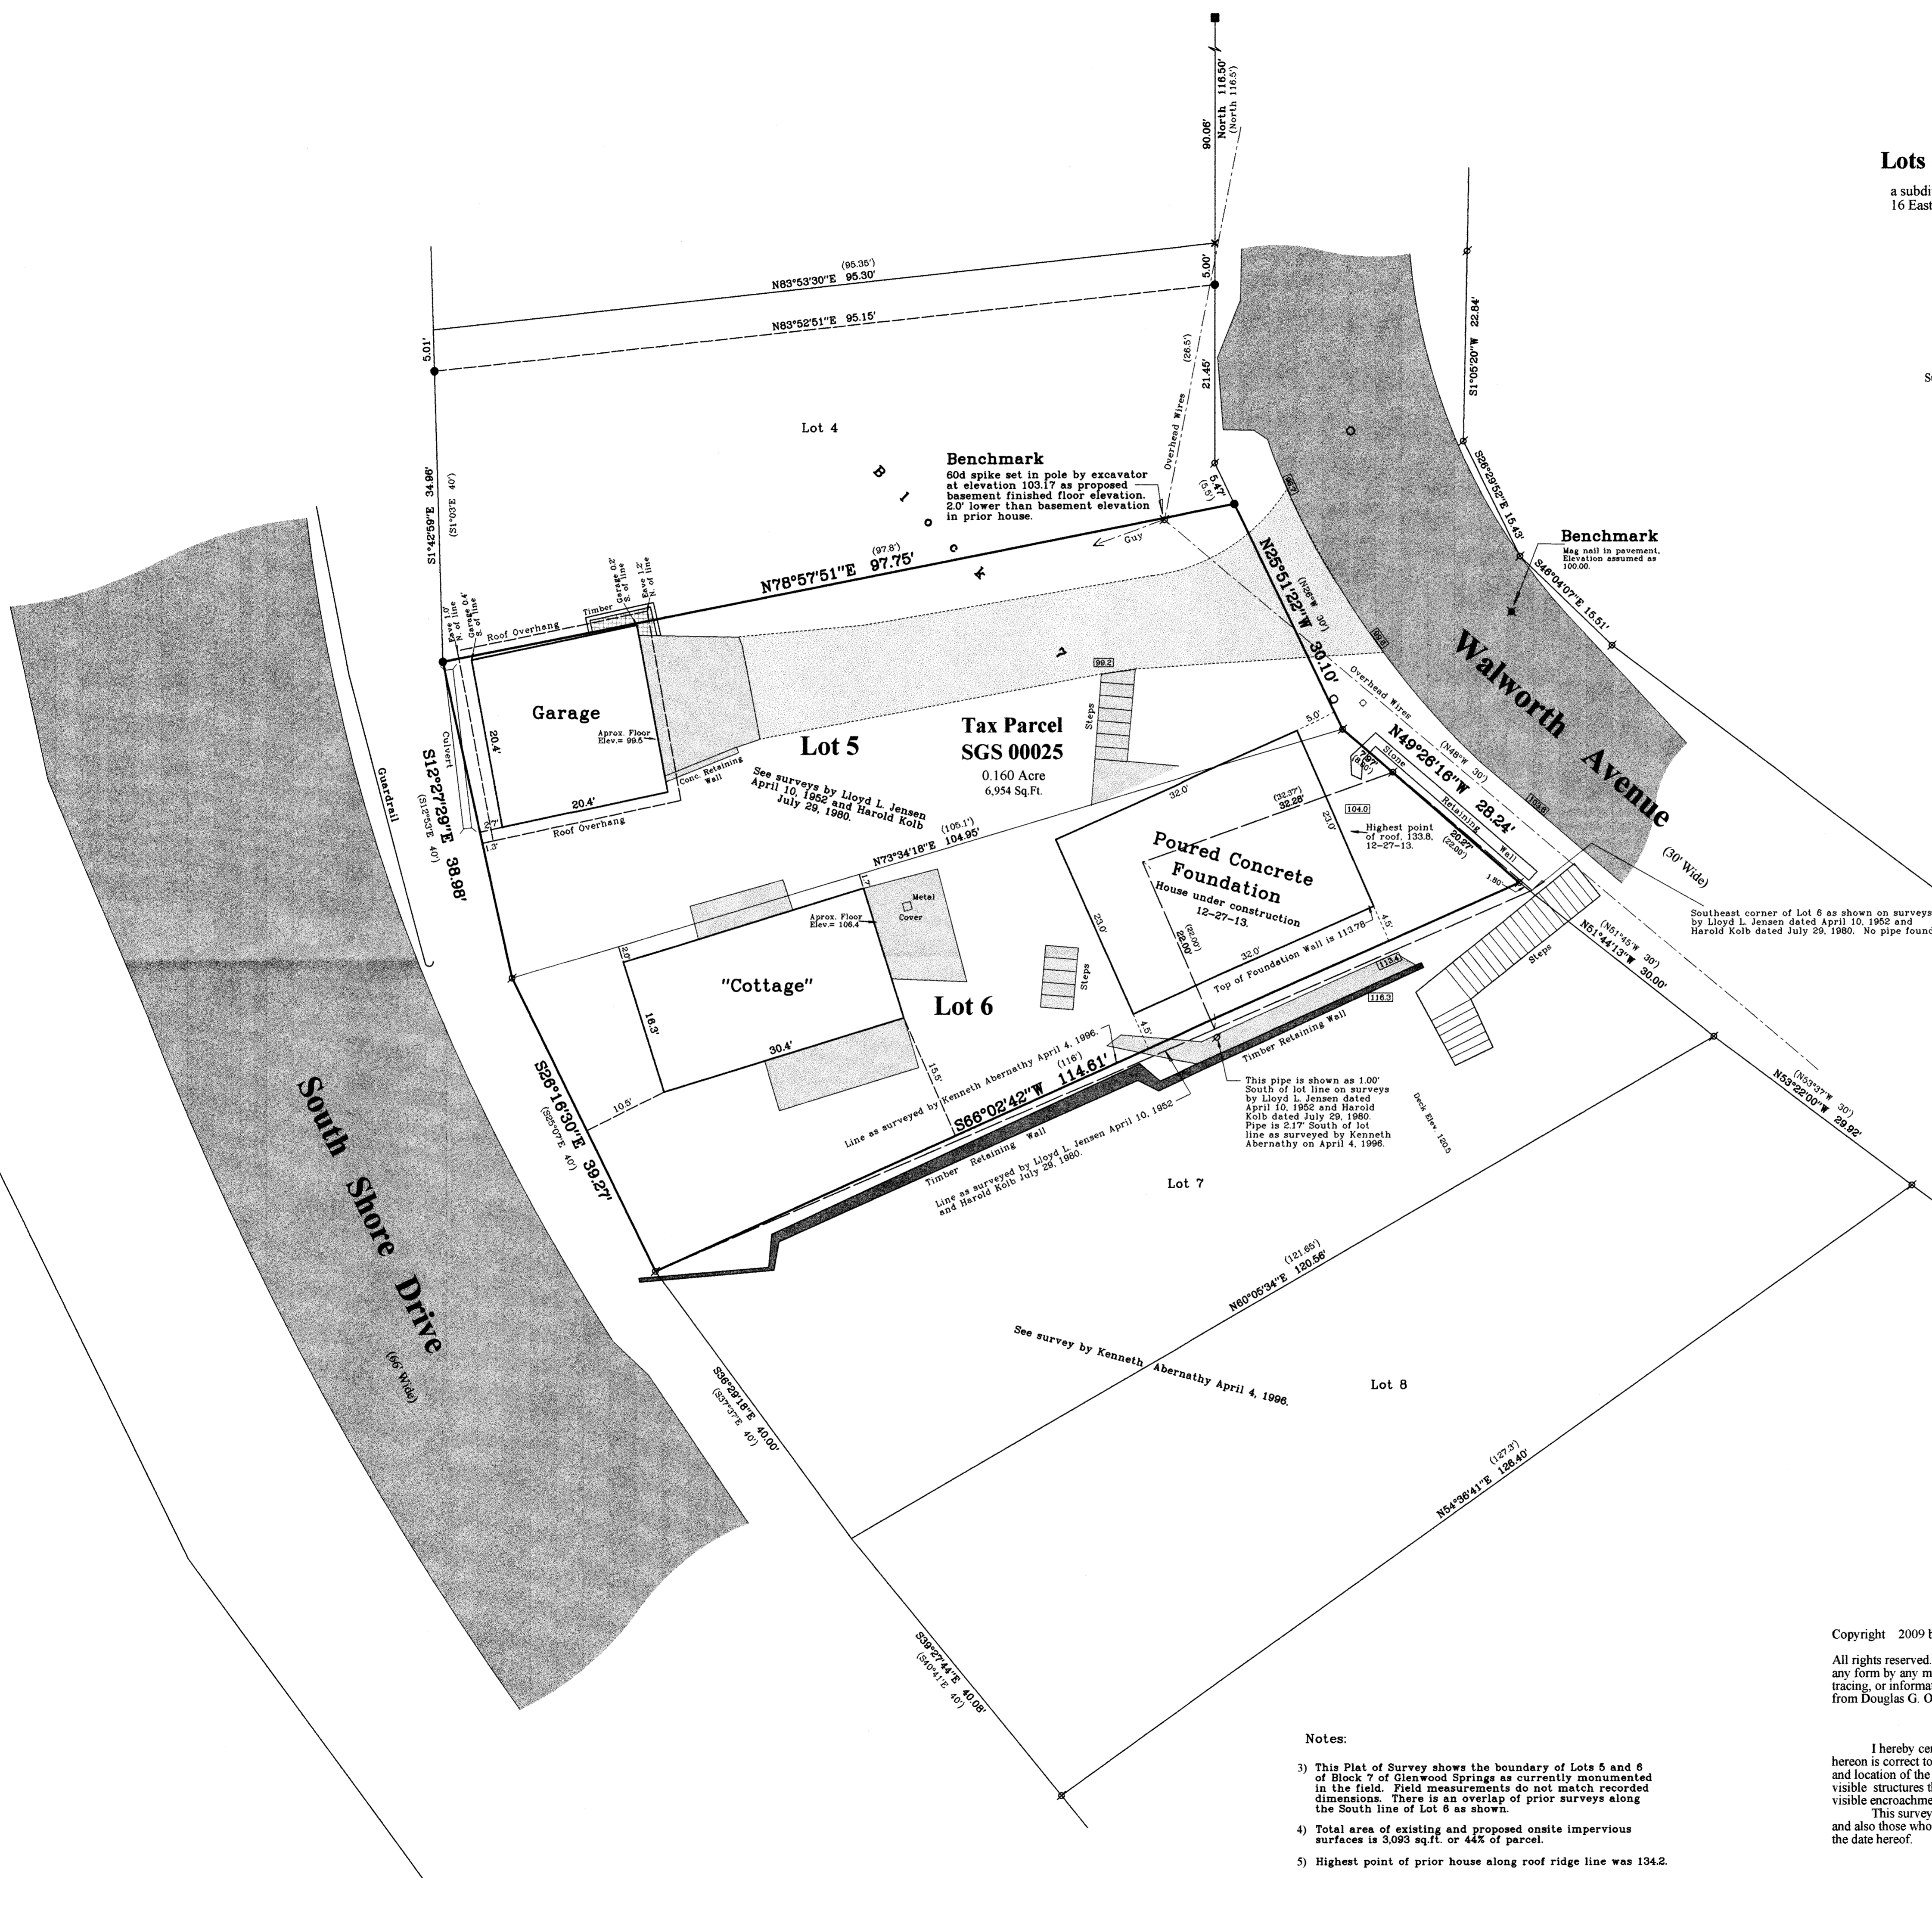


This pipe is shown as 1.00'  
 South of lot line on surveys  
 by Lloyd L. Jensen dated  

- Notes:**
- 1) This survey plat is not certified unless signed and sealed in red ink.
  - 2) This survey is subject to Wisconsin lien laws. This Plat of Survey is the notice of intent to file lien. Lien waiver required.

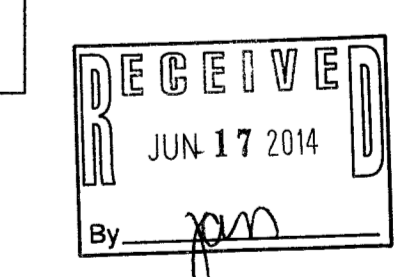

Copyright 2009 by Jensen & Olson Land Surveying, LLC.

All rights reserved. No part of this survey plat may be reproduced or transmitted in any form by any means - graphic, electronic, or mechanical, including photocopying, tracing, or information storage and retrieval systems - without permission in writing from Douglas G. Olson, Jensen & Olson Land Surveying, LLC.

- Notes:**
- 3) This Plat of Survey shows the boundary of Lots 5 and 6 of Block 7 of Glenwood Springs as currently monumented in the field. Field measurements do not match recorded dimensions. There is an overlap of prior surveys along the South line of Lot 8 as shown.
  - 4) Total area of existing and proposed onsite impervious surfaces is 3,093 sq.ft. or 44% of parcel.
  - 5) Highest point of prior house along roof ridge line was 134.2.

Douglas G. Olson  
 Wisconsin Registered Land Surveyor - 2093

862-25 005-3052