
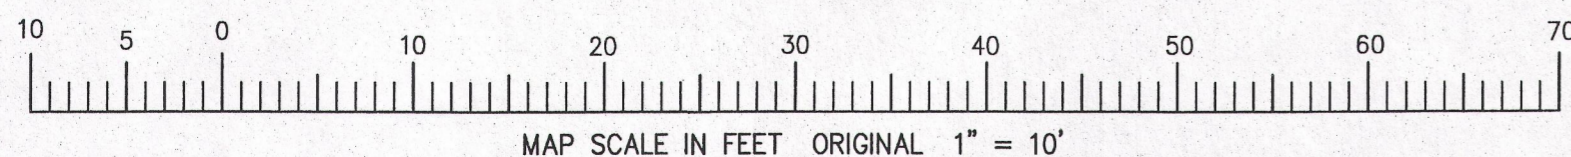
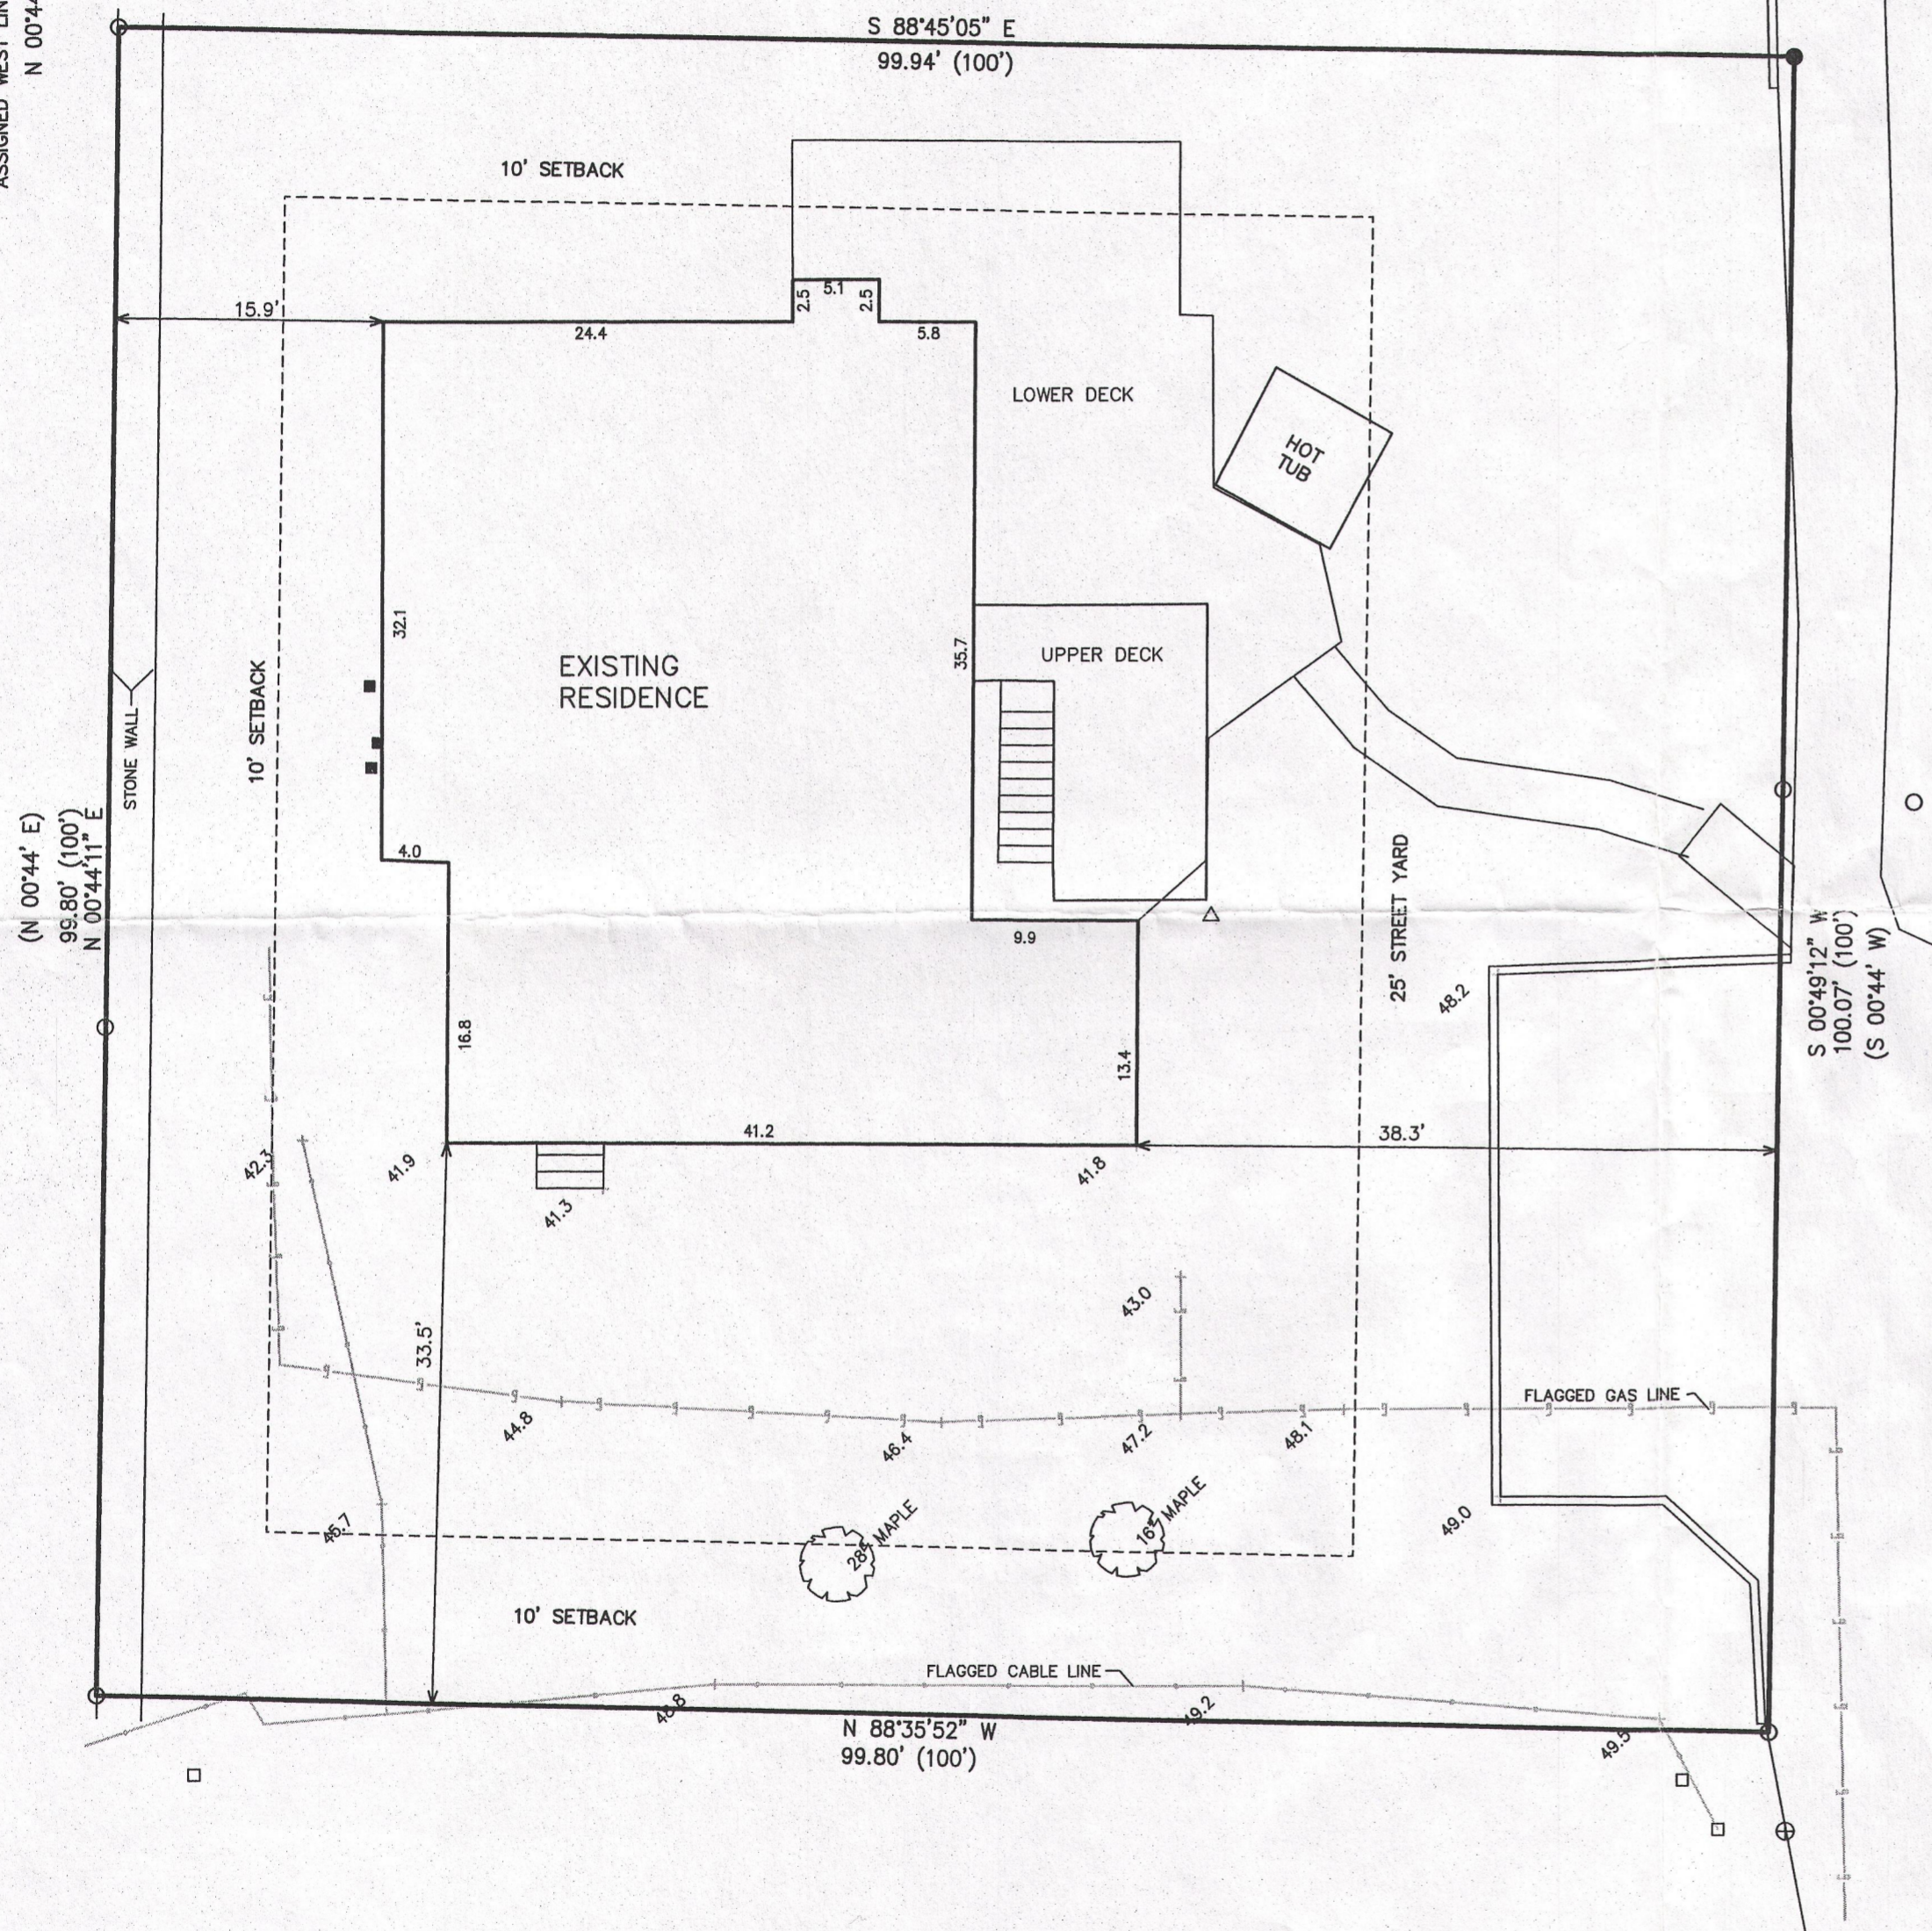


SEP 12 2014

9/12/2014 X:\Projects\9131\load\survey

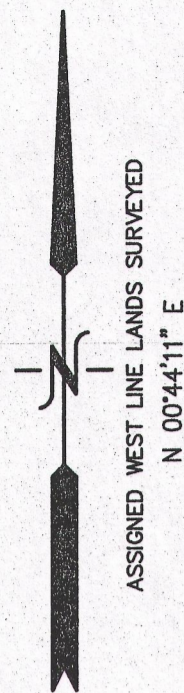

# PLAT OF SURVEY A PARCEL OF LAND LOCATED IN THE NW FRACTIONAL 1/4 SECTION 13 TOWN 1 NORTH, RANGE 16 EAST VILLAGE OF FONTANA-ON-GENEVA LAKE WALWORTH COUNTY, WISCONSIN

A parcel of land located in the Northwest Fractional 1/4 of Section 13, T1N, R16E, Village of Fontana, Walworth County, Wisconsin, described as follows, to-wit: Commencing at the middle 1/4 section corner of said Section 13; thence west along east-west 1/4 Section line of said Section 13 a distance of 664.18 feet; thence North 0 degrees 44' east 162.00 feet to the place of beginning; thence continue North 0 degrees 44' East 100 feet; thence East parallel to said 1/4 Section line 100 feet; thence South 0 degrees 44' West 100 feet; thence West 100 feet to the place of beginning.

Also, a non-exclusive right of ingress and egress over the road as now travelled from the above described property to the public road on the East-West 1/4 line of said Section 13.



- LEGEND
- = FOUND IRON PIPE STAKE
  - = SET IRON REBAR STAKE
  - (XXX) = RECORDED AS

NOTE: COPIES OF THIS MAP TO WHICH THE FOLLOWING CERTIFICATE WILL APPLY SHOW THE SURVEYOR'S ORIGINAL SEAL AND SIGNATURE IN RED INK. COPIES BY ANY OTHER MEANS MAY HAVE ALTERATIONS WHICH DO NOT REPRESENT THE SURVEYOR'S WORK PRODUCT.

I HEREBY CERTIFY THAT THE ABOVE DESCRIBED PROPERTY HAS BEEN SURVEYED UNDER MY DIRECTION AND THAT THE ABOVE MAP IS A TRUE REPRESENTATION THEREOF AND SHOWS THE SIZE AND LOCATION OF THE PROPERTY AND ITS EXTERIOR BOUNDARIES. THIS SURVEY IS MADE FOR THE USE OF THE PRESENT OWNERS OF THE PROPERTY, AND ALSO THOSE WHO PURCHASE, MORTGAGE, OR GUARANTEE THE TITLE THERETO WITHIN ONE YEAR FROM THE DATE HEREOF.

DATED: SEPTEMBER 12, 2014

*Peter S. Gordon*  
PETER S. GORDON R.L.S. 2101

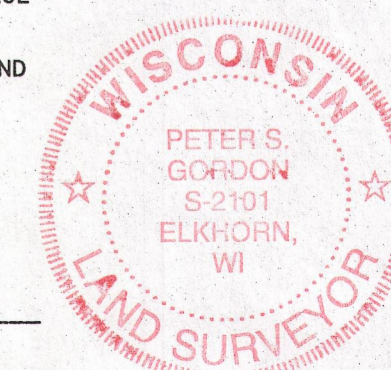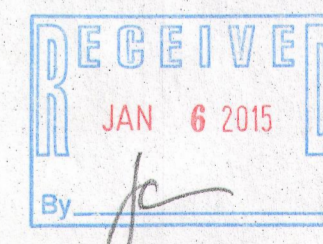

WORK ORDERED BY:  
THE TRACY GROUP  
525 KENOSHA STREET, SUITE D  
WAALWORTH, WI. 53184

FARRIS, HANSEN & ASSOCIATES, INC.  
ENGINEERING - ARCHITECTURE - SURVEYING  
7 RIDGWAY COURT P.O. BOX 437  
ELKHORN, WISCONSIN 53121  
OFFICE: (262) 723-2098 FAX: (262) 723-5886

REVISIONS

PROJECT NO.  
9131  
DATE:  
09-04-2014  
SHEET NO.  
1 OF 1

8+FV-99 005-3097