




PREPARED FOR
GLENWOOD SPRINGS

PLAT OF SURVEY

- OF -

BLOCK 11, GLENWOOD SPRINGS, A SUBDIVISION OF PART OF LOTS 3 AND 4
OF THE SOUTHEAST FRACTIONAL 1/4 OF SECTION 14, TOWN 1, NORTH, RANGE
EAST OF THE FOURTH PRINCIPAL MERIDIAN, VILLAGE OF FONTANA-ON-GENEVA-
LAKE, WALWORTH COUNTY, WISCONSIN.

PATHFINDER SURVEYING INC.
(formerly)
J.K. SURVEYING INC.
P.O BOX 322
LAKE GENEVA, WI. 53147
WWW.PATHFINDERSURVEYING.NET
262-248-8303

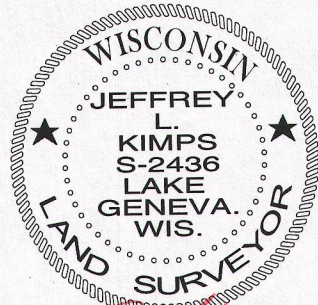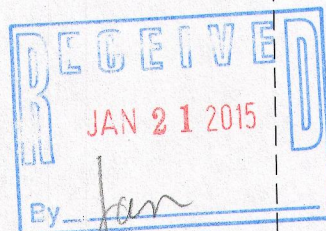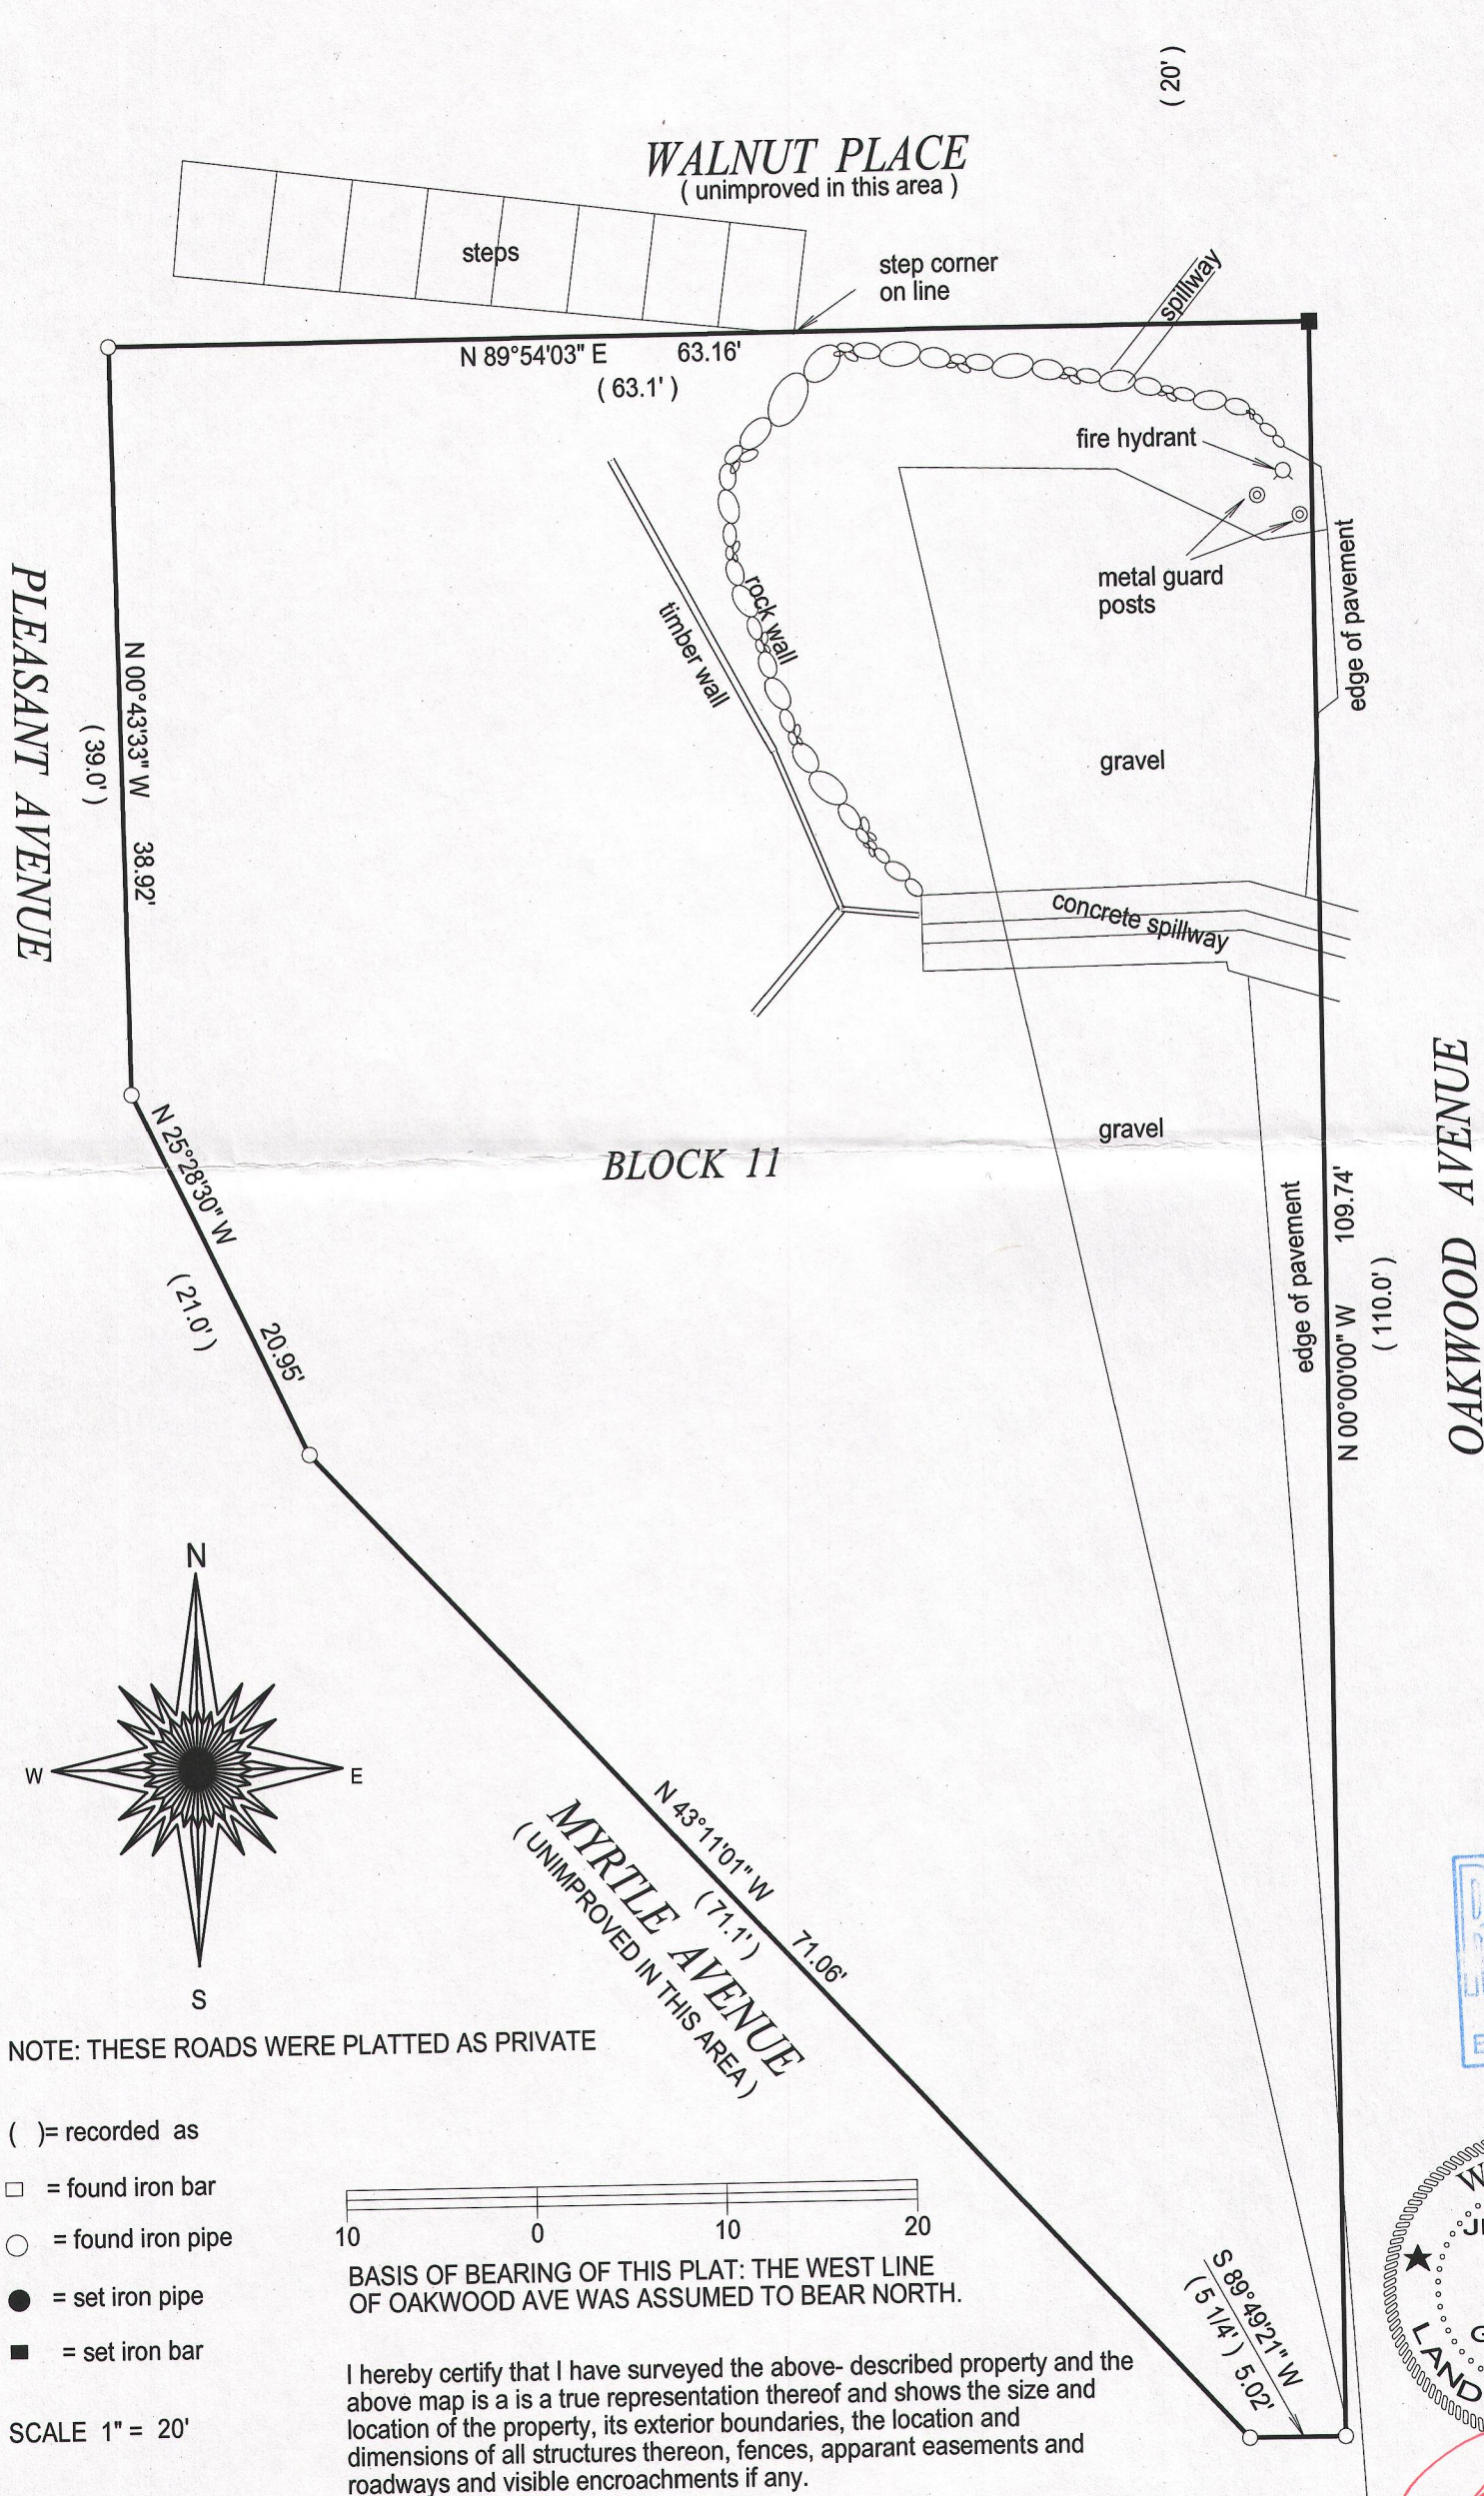

JEFFREY L. KIMPS S-2436
Wisconsin Registered Land Surveyor
(original if signed in red)

818-128

005-3107