


HAROLD H. KOLB
 REGISTERED PROFESSIONAL LAND SURVEYOR
 LAKE GENEVA, WISCONSIN

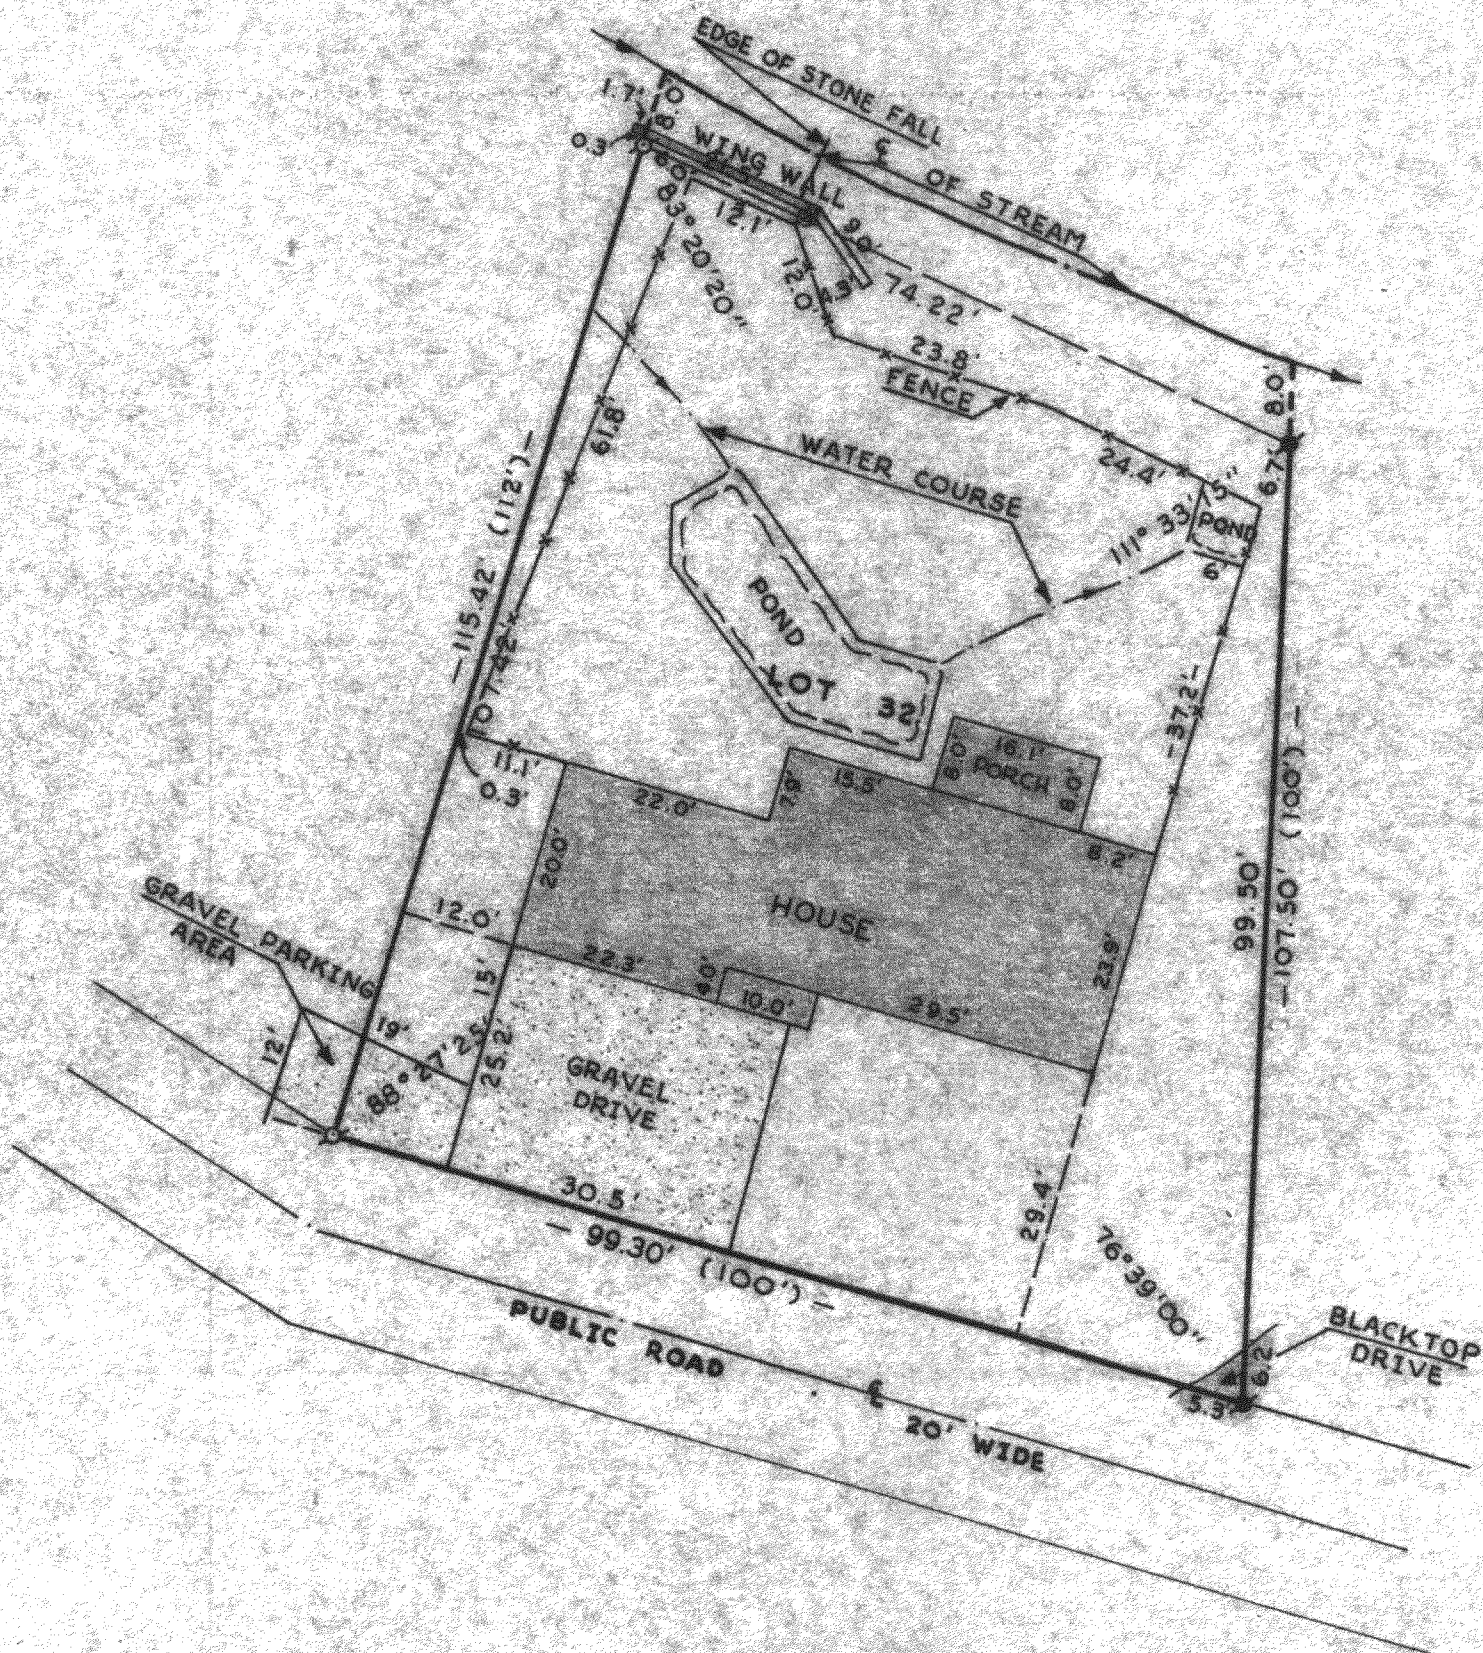

PLAT OF SURVEY OF

Lot 32, The Gardens Subdivision, Village of Fontana-
 on-Geneva Lake, Walworth County, Wisconsin.


OWNER: Russell L. Chester

ACCURACY: Distances $\pm 0.01'$
 Angles $\pm 05''$
 Error of closure-
 less than $1/3000$

N

 SCALE: 1"=20'
 LEGEND

- φ - IRON PIPE FOUND
- - IRON PIPE PLACED
- # - CONCRETE MONUMENT FOUND
- x - SPIKE
- () - Platted As

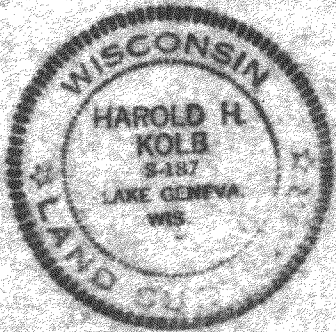

I, HAROLD H. KOLB, DO HEREBY CERTIFY THAT I HAVE
 SURVEYED THE PROPERTY HEREON DESCRIBED ACCORDING
 TO THE OFFICIAL RECORDS, AND THAT THE PLAT HEREON
 IS A CORRECT REPRESENTATION OF THE LOT LINES.

Harold H. Kolb
 HAROLD H. KOLB
 WISCONSIN REGISTERED LAND SURVEYOR, 5-187
 DATE October 24, 1974