PLAT OF SURVEY

OF LOTS 4 & 9, BLOCK 4,
ORIGINAL PLAT VILLAGE OF FONTANA,
BEING PART OF THE NW 1/4 OF THE
NW 1/4 OF SECTION 14,
TOWNSHIP 1 NORTH, RANGE 16 EAST,
OF THE 4TH P.M.,
VILLAGE OF FONTANA-ON-GENEVA
LAKE, WALWORTH COUNTY,
WISCONSIN.

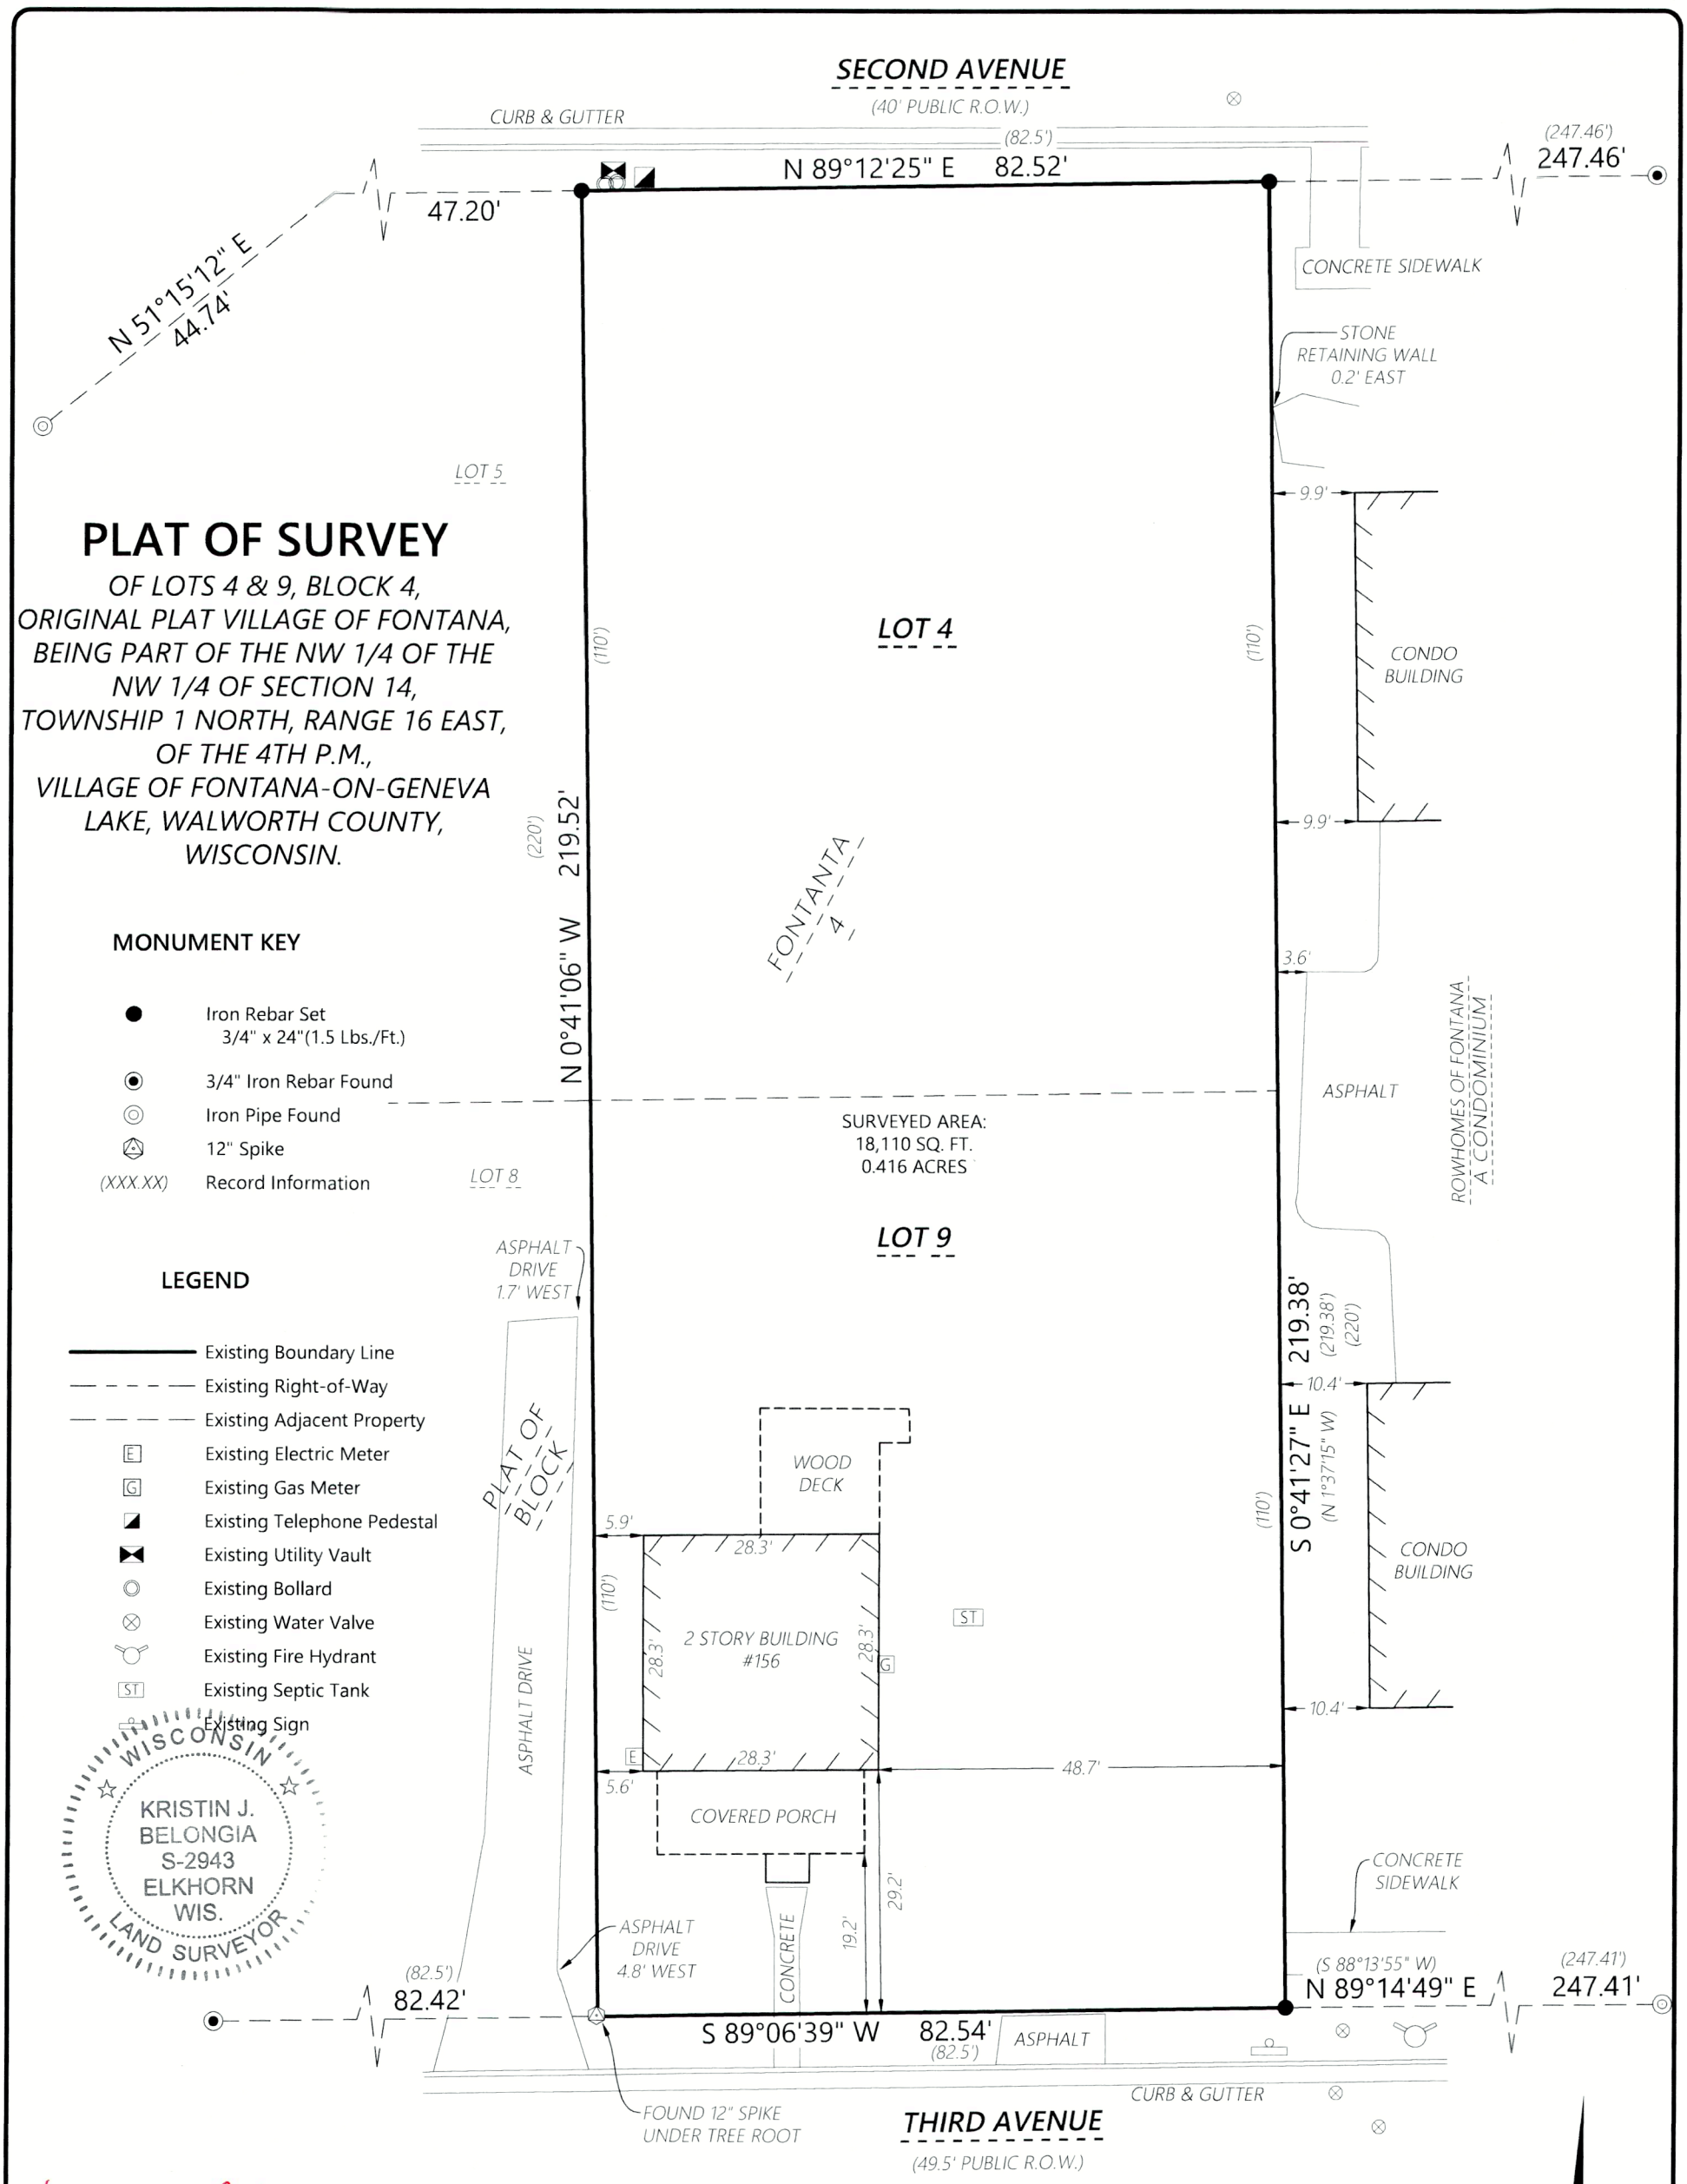

MONUMENT KEY

- Iron Rebar Set 3/4" x 24"(1.5 Lbs./Ft.)
- 3/4" Iron Rebar Found
- Iron Pipe Found
- 12" Spike
- (XXX.XX) Record Information

LEGEND

- Existing Boundary Line
- Existing Right-of-Way
- Existing Adjacent Property
- Existing Electric Meter
- Existing Gas Meter
- Existing Telephone Pedestal
- Existing Utility Vault
- Existing Bollard
- Existing Water Valve
- Existing Fire Hydrant
- Existing Septic Tank
- Existing Sign

WISCONSIN
KRISTIN J. BELONGIA
S-2943
ELKHORN WIS.
LAND SURVEYOR

Kristin J Belongia

Kristin J. Belongia, P.L.S.
Wisconsin Professional Land Surveyor S-2943

State of Wisconsin
County of Walworth } ss

If the surveyor's signature is not red in color, the plan is a copy that should be assumed to contain unauthorized alterations.
The certification contained on this document shall not apply to any copies.

I hereby certify that I have supervised the survey of the property described above and to the best my knowledge and belief, the plat drawn hereon complies with Chapter A-E 7 of the State of Wisconsin Administrative Code, Minimum Standards for Property Surveys and correctly represents said survey and its location.
Given under my hand and seal this 12th day of July, 2023 at Beloit, Wisconsin.
Last day of field work July 6th, 2023

FEB 13 2024

Scale: 1" = 20'
0 10 20 40

DISTANCE UNITS BASED ON THE UNITED STATES SURVEY FOOT

BEARINGS BASED ON THE WISCONSIN COORDINATE REFERENCE SYSTEM, WALWORTH ZONE. THE NORTH RIGHT-OF-WAY OF THIRD AVENUE BEARING S 89°06'39" W

ORDER NO: 34714	FOR THE EXCLUSIVE USE OF:	PLAT OF SURVEY	Batterman
FIELD CREW: BMR DRAWN BY: BMR SHEET 1 OF 1	Linda Blake 156 3rd Avenue Fontana, WI 53125		engineers surveyors planners 2857 Bartells Drive, Beloit, Wisconsin 53511, 608.365.4464 1040 N Wisconsin Street, Elkhorn, Wisconsin 53121, 262.379.2250

File Name: J:\34700-34799\34714 - Linda Blake\SURVEY\RHB DRAWING FILES

SOP-21

005-3774