HAROLD H. KOLB

REGISTERED PROFESSIONAL LAND SURVEYOR
LAKE GENEVA, WISCONSIN

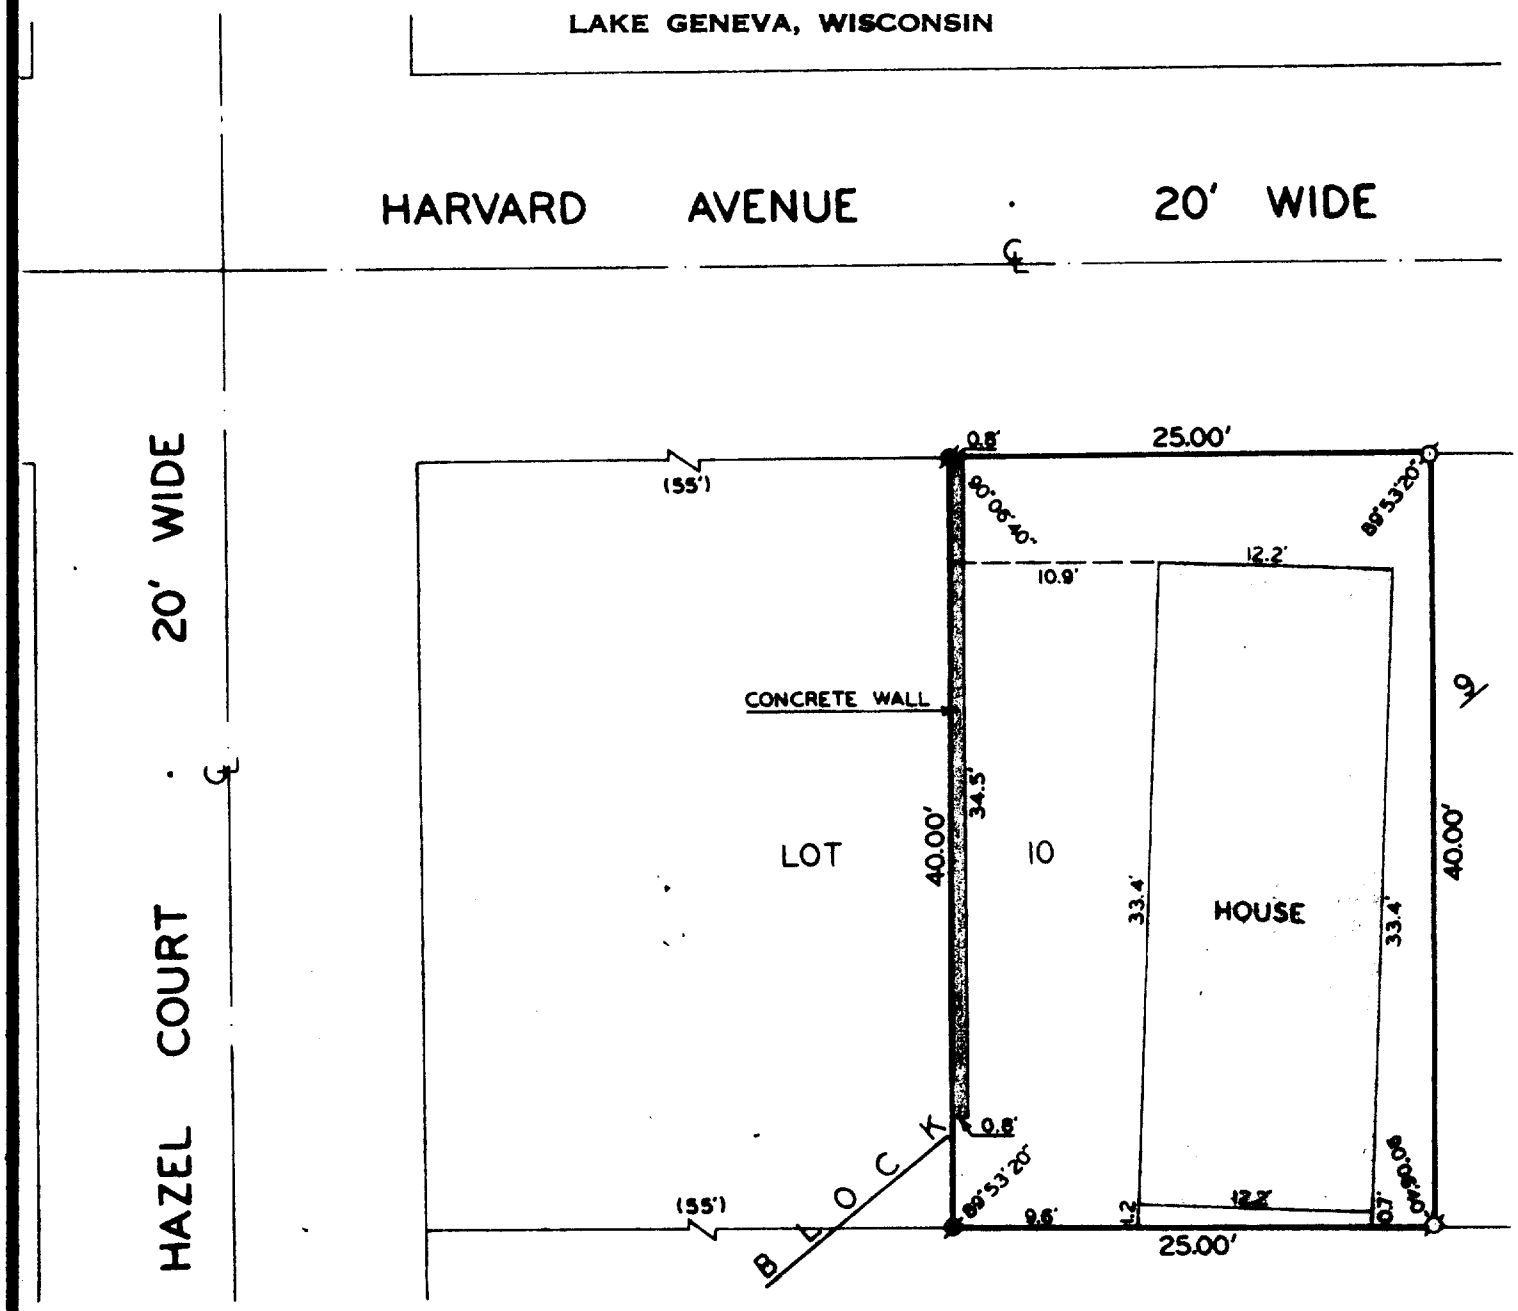

PLAT OF SURVEY OF

THE EAST 25 FEET OF LOT 10, BLOCK 9, GLENWOOD SPRINGS SUBDIVISION, VILLAGE OF FONTANA-ON-GENEVA LAKE, WALWORTH COUNTY, WISCONSIN.

ORDERED BY: CONROYD REALTY

OWNER: LAWRENCE GOSCHI

WISCONSIN HAROLD H. KOLB S-187 LAKE GENEVA, WIS. LAND SURVEYOR

Parcel S G S - 00052

I, HAROLD H. KOLB, DO HEREBY CERTIFY THAT I HAVE SURVEYED THE PROPERTY HEREON DESCRIBED ACCORDING TO THE OFFICIAL RECORDS, AND THAT THE PLAT HEREON IS A CORRECT REPRESENTATION OF THE LOT LINES.

Harold H. Kolb

HAROLD H. KOLB
WISCONSIN REGISTERED LAND SURVEYOR, S-187
DATE Sept. 6, 1977

N

SCALE : 1" = 10'

LEGEND

- ø — IRON PIPE FOUND
- ø — CONCRETE MONUMENT FOUND
- ( ) — AS PLATTED

5-500

BRUNING 40-108 1M-6-71