WALWORTH COUNTY
SURVEYING & MAPPING
LAKE GENEVA, WISCONSIN

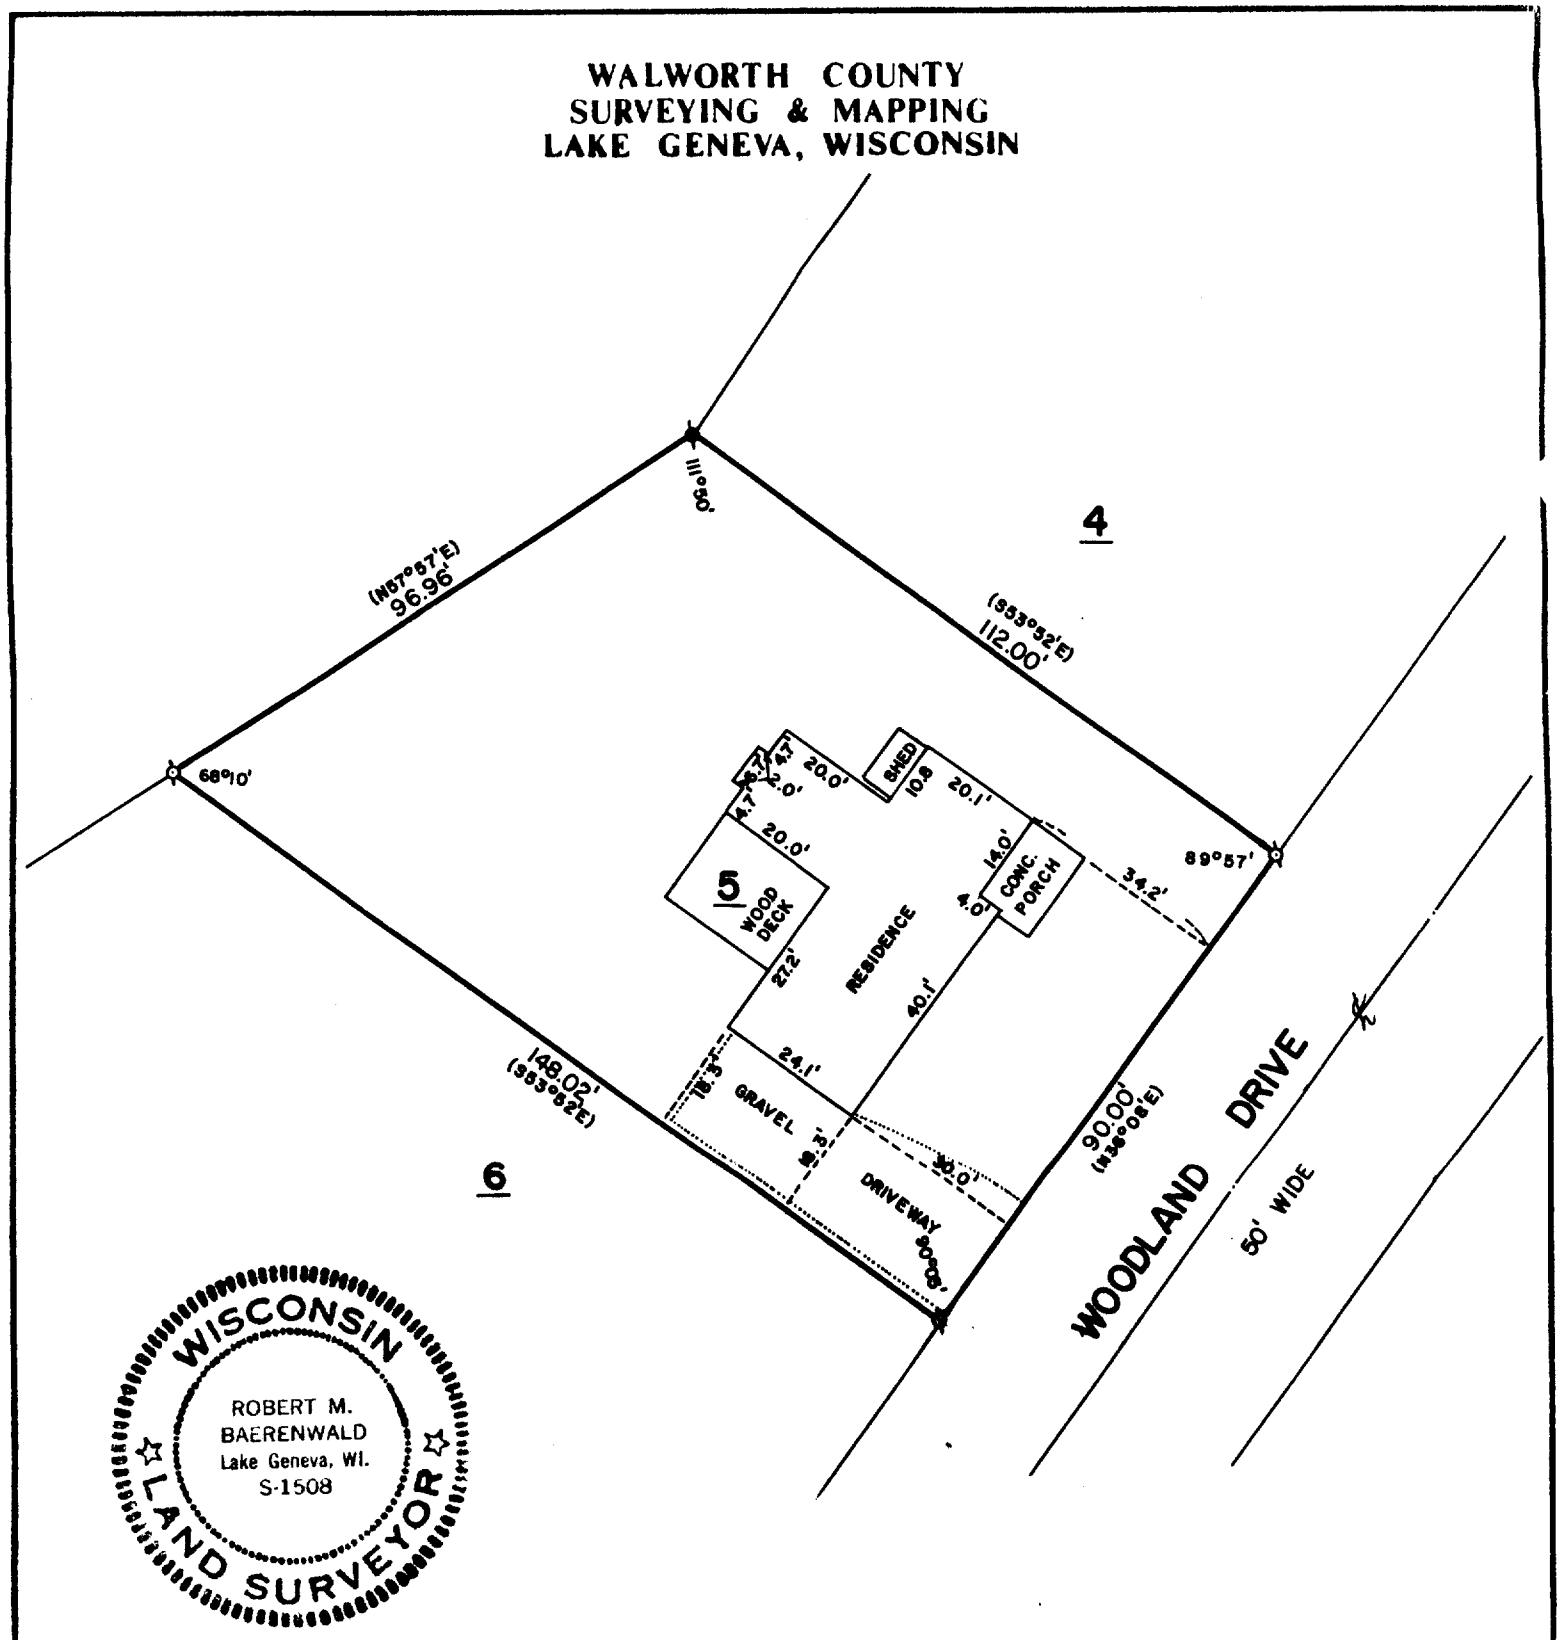

WISCONSIN
ROBERT M.
BAERENWALD
Lake Geneva, WI.
S-1508
LAND SURVEYOR

PLAT OF SURVEY OR

RECEIVED
JUL 1985
W. L.

LOT 5 OF COUNTRY CLUB ESTATES, ADDITION "E", A SUBDIVISION LOCATED IN SECTIONS 14 AND 23, T 1 N, R 16 E, VILLAGE OF FONTANA-ON-GENEVA LAKE, WALWORTH COUNTY, WISCONSIN.

ORDERED BY: KEEFE REAL ESTATE
P. O. BOX 268
WALWORTH, WISCONSIN 53184

SCALE: 1"=30'

●-IRON PIPE FOUND
o-CONCRETE MONUMENT FOUND
()-RECORDED AS

I, ROBERT M. BAERENWALD, DO HEREBY CERTIFY THAT I HAVE SURVEYED THE PROPERTY HEREON DESCRIBED ACCORDING TO THE OFFICIAL RECORDS AND THAT THE PLAT HEREON IS A CORRECT REPRESENTATION OF THE PROPERTY LINES TO THE BEST OF MY KNOWLEDGE AND BELIEF.

Robert M. Baerenwald
ROBERT M. BAERENWALD
WISCONSIN REGISTERED LAND SURVEYOR, S-1508

July 30, 1984
DATE

JOB NO. 0101

SCT E-5

5-622-B