PLAT OF SURVEY OF LOT 8, BLOCK 14, GLENWOOD SPRINGS SUBDIVISION

VILLAGE OF FONTANA, WALWORTH COUNTY, WISCONSIN

WORK ORDERED BY: DR. CHARLES PETERSEN

RECEIVED
OCT 30 1985
Jr. P.

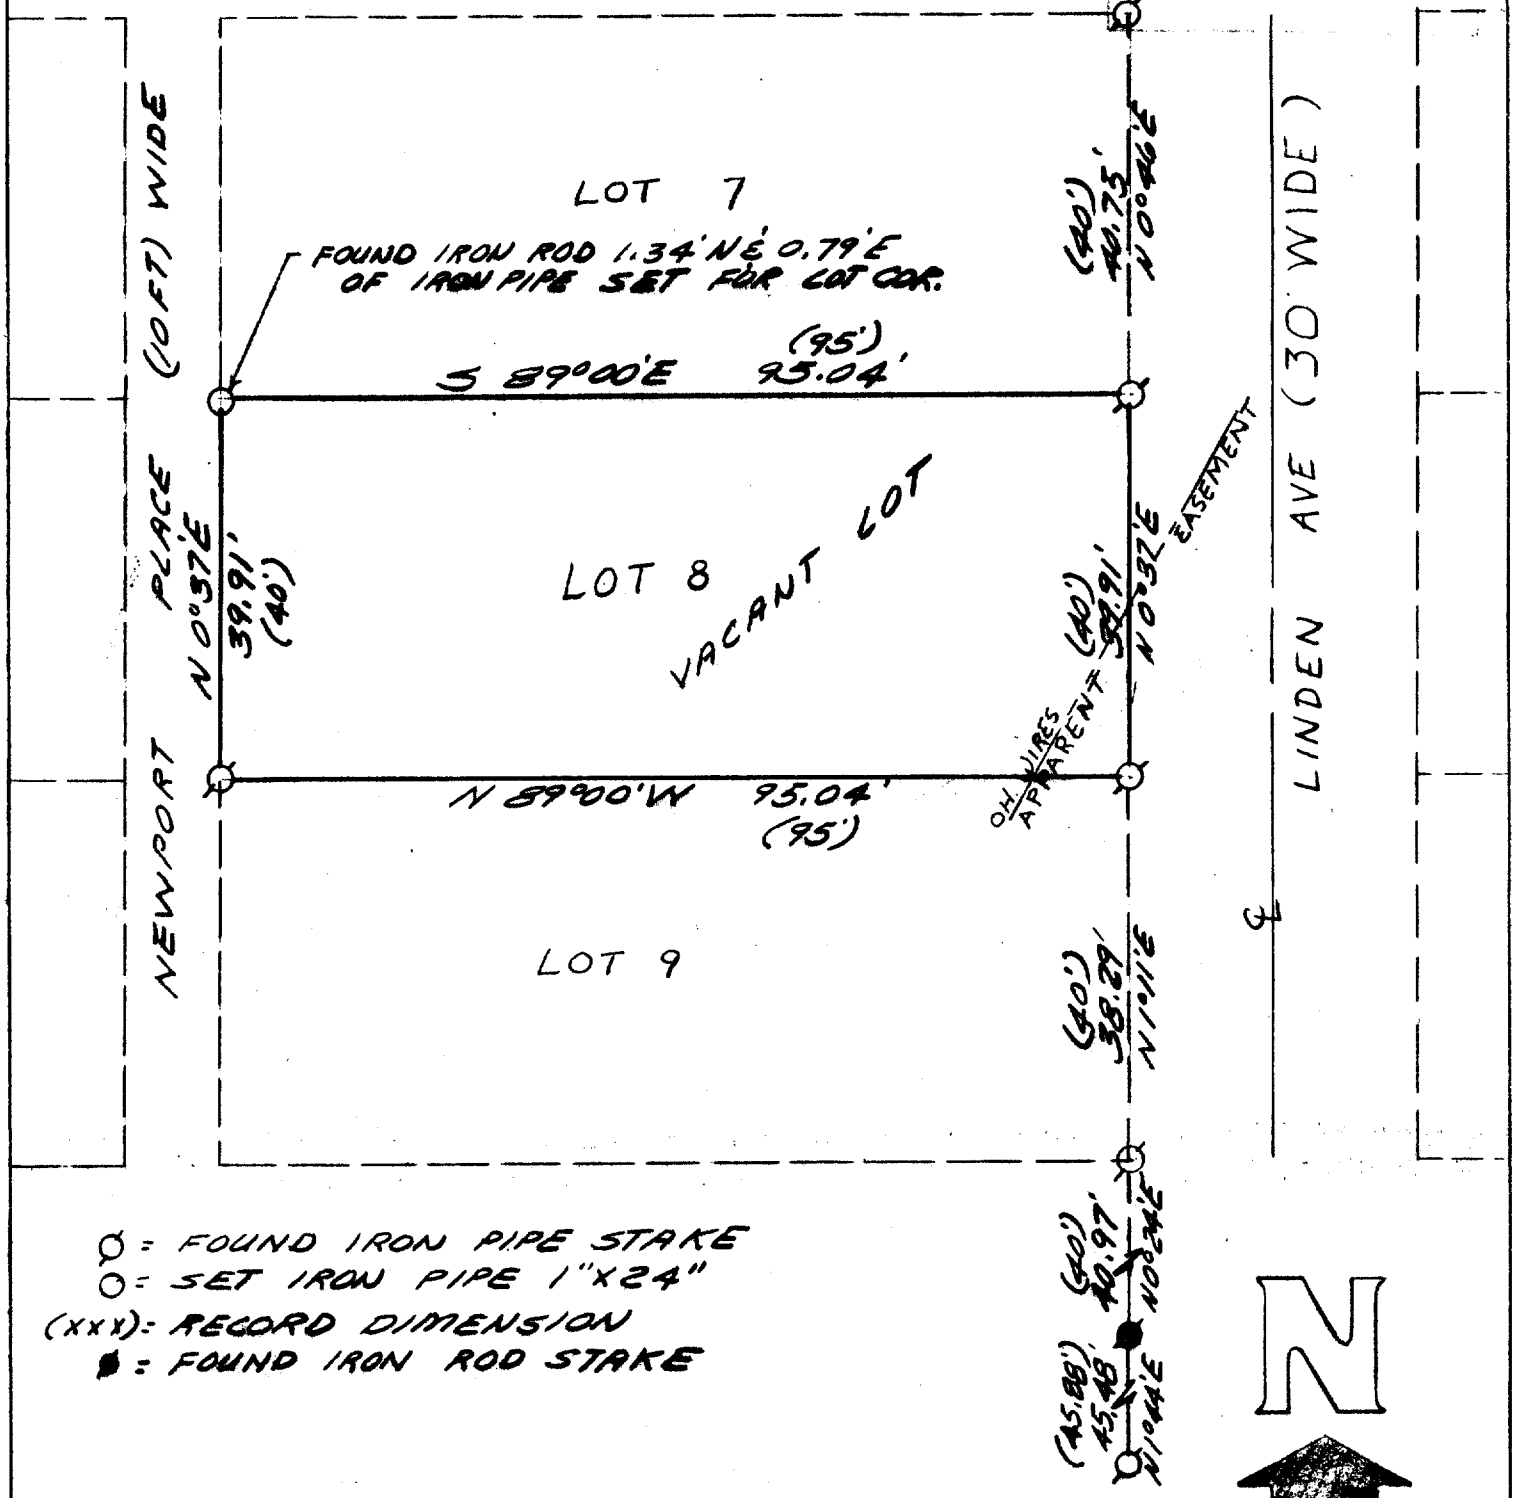

○ = FOUND IRON PIPE STAKE
○ = SET IRON PIPE 1"X24"
(XXX): RECORD DIMENSION
● = FOUND IRON ROD STAKE

MAP SCALE
1" = 20'
BEARINGS REF. TO S. LINE LOT 8 ASSIGNED N89°00'W

I hereby certify that I have surveyed the above described property and that the above map is a true representation thereof and shows the size and location of the property, its exterior boundaries, the location of all visible structures and dimensions of all principal buildings thereon, boundary fences, apparent easements, roadways and visible encroachments, if any.
This survey is made for the use of the present owners of the property, and also those who purchase, mortgage, or guarantee the title thereto within one (1) year from the date hereof.

Robert A. Farris

Robert A. Farris RLS
FARRIS HANSEN & ASASOCIATES, INC.
7 RIDGEWAY COURT, ELKHORN, WI. 53121
TELE 414-723-2098

9/20/85

WISCONSIN
ROBERT A FARRIS
S-1267
ELKHORN WIS
REGISTERED LAND SURVEYOR

PROJECT NO. 2465

SGS-00087

5-625-F