RECEIVED
AUG 5 1985

WALWORTH COUNTY
SURVEYING & MAPPING
LAKE GENEVA, WISCONSIN

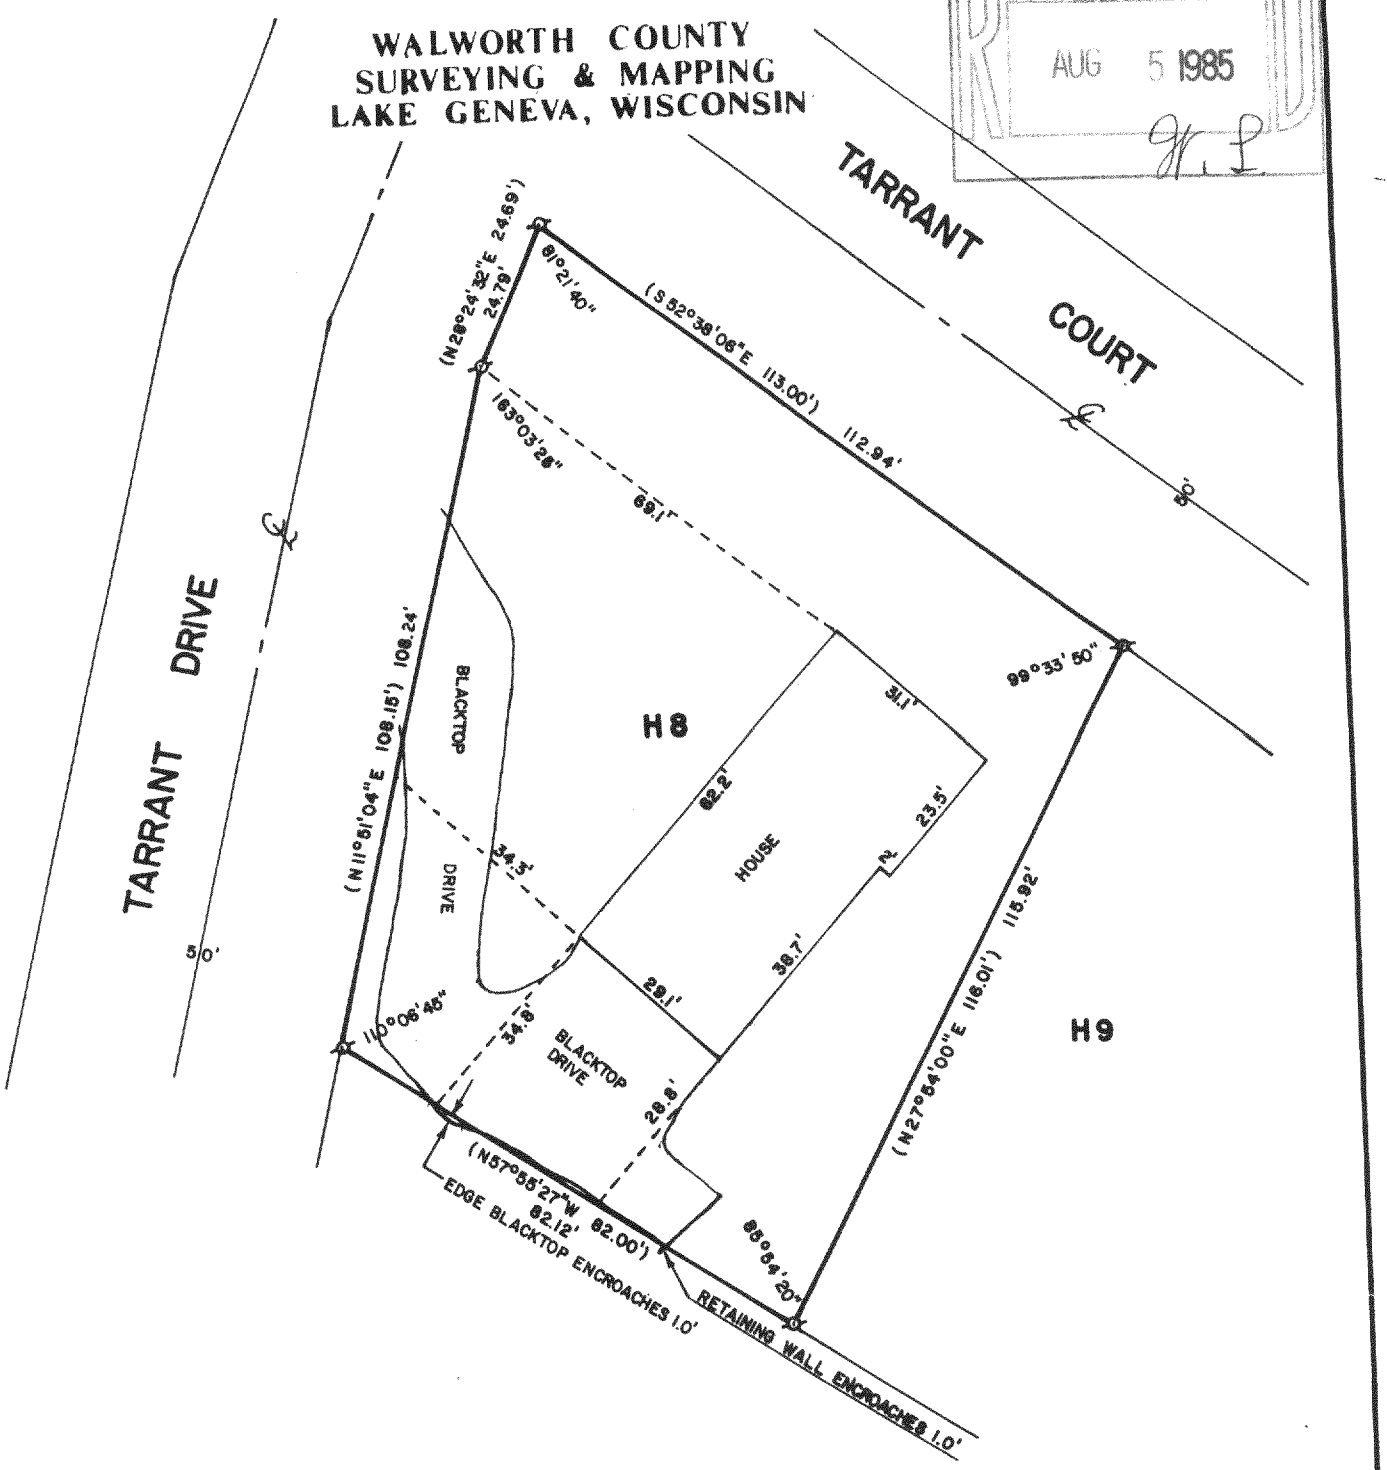

PLAT OF SURVEY OF

LOT H8, COUNTRY CLUB ESTATES ADDITION H,
VILLAGE OF FONTANA-ON-GENEVA LAKE,
WALWORTH COUNTY, WISCONSIN.

ORDERED BY: KEEFE REAL ESTATE
P.O. BOX 268
WALWORTH, WI 53184

WISCONSIN
DAVID F. ABELL S-1596 Delavan, Wis.
LAND SURVEYOR

SCALE - 1"=30'

LEGEND
ø - IRON PIPE FOUND
( )- RECORDED AS

I, DAVID F. ABELL, DO HEREBY CERTIFY THAT I HAVE SURVEYED THE PROPERTY HEREON DESCRIBED ACCORDING TO THE OFFICIAL RECORDS, AND THAT THE PLAT HEREON IS A CORRECT REPRESENTATION OF THE LOT LINES TO THE BEST OF MY KNOWLEDGE AND BELIEF.

David F. Abell
DAVID F. ABELL
WISCONSIN REGISTERED LAND SURVEYOR, S-1596

May 20, 1985
DATE JOB NUMBER 0273

SCT H-8

5-626-A