WALWORTH COUNTY
SURVEYING & MAPPING
LAKE GENEVA, WISCONSIN

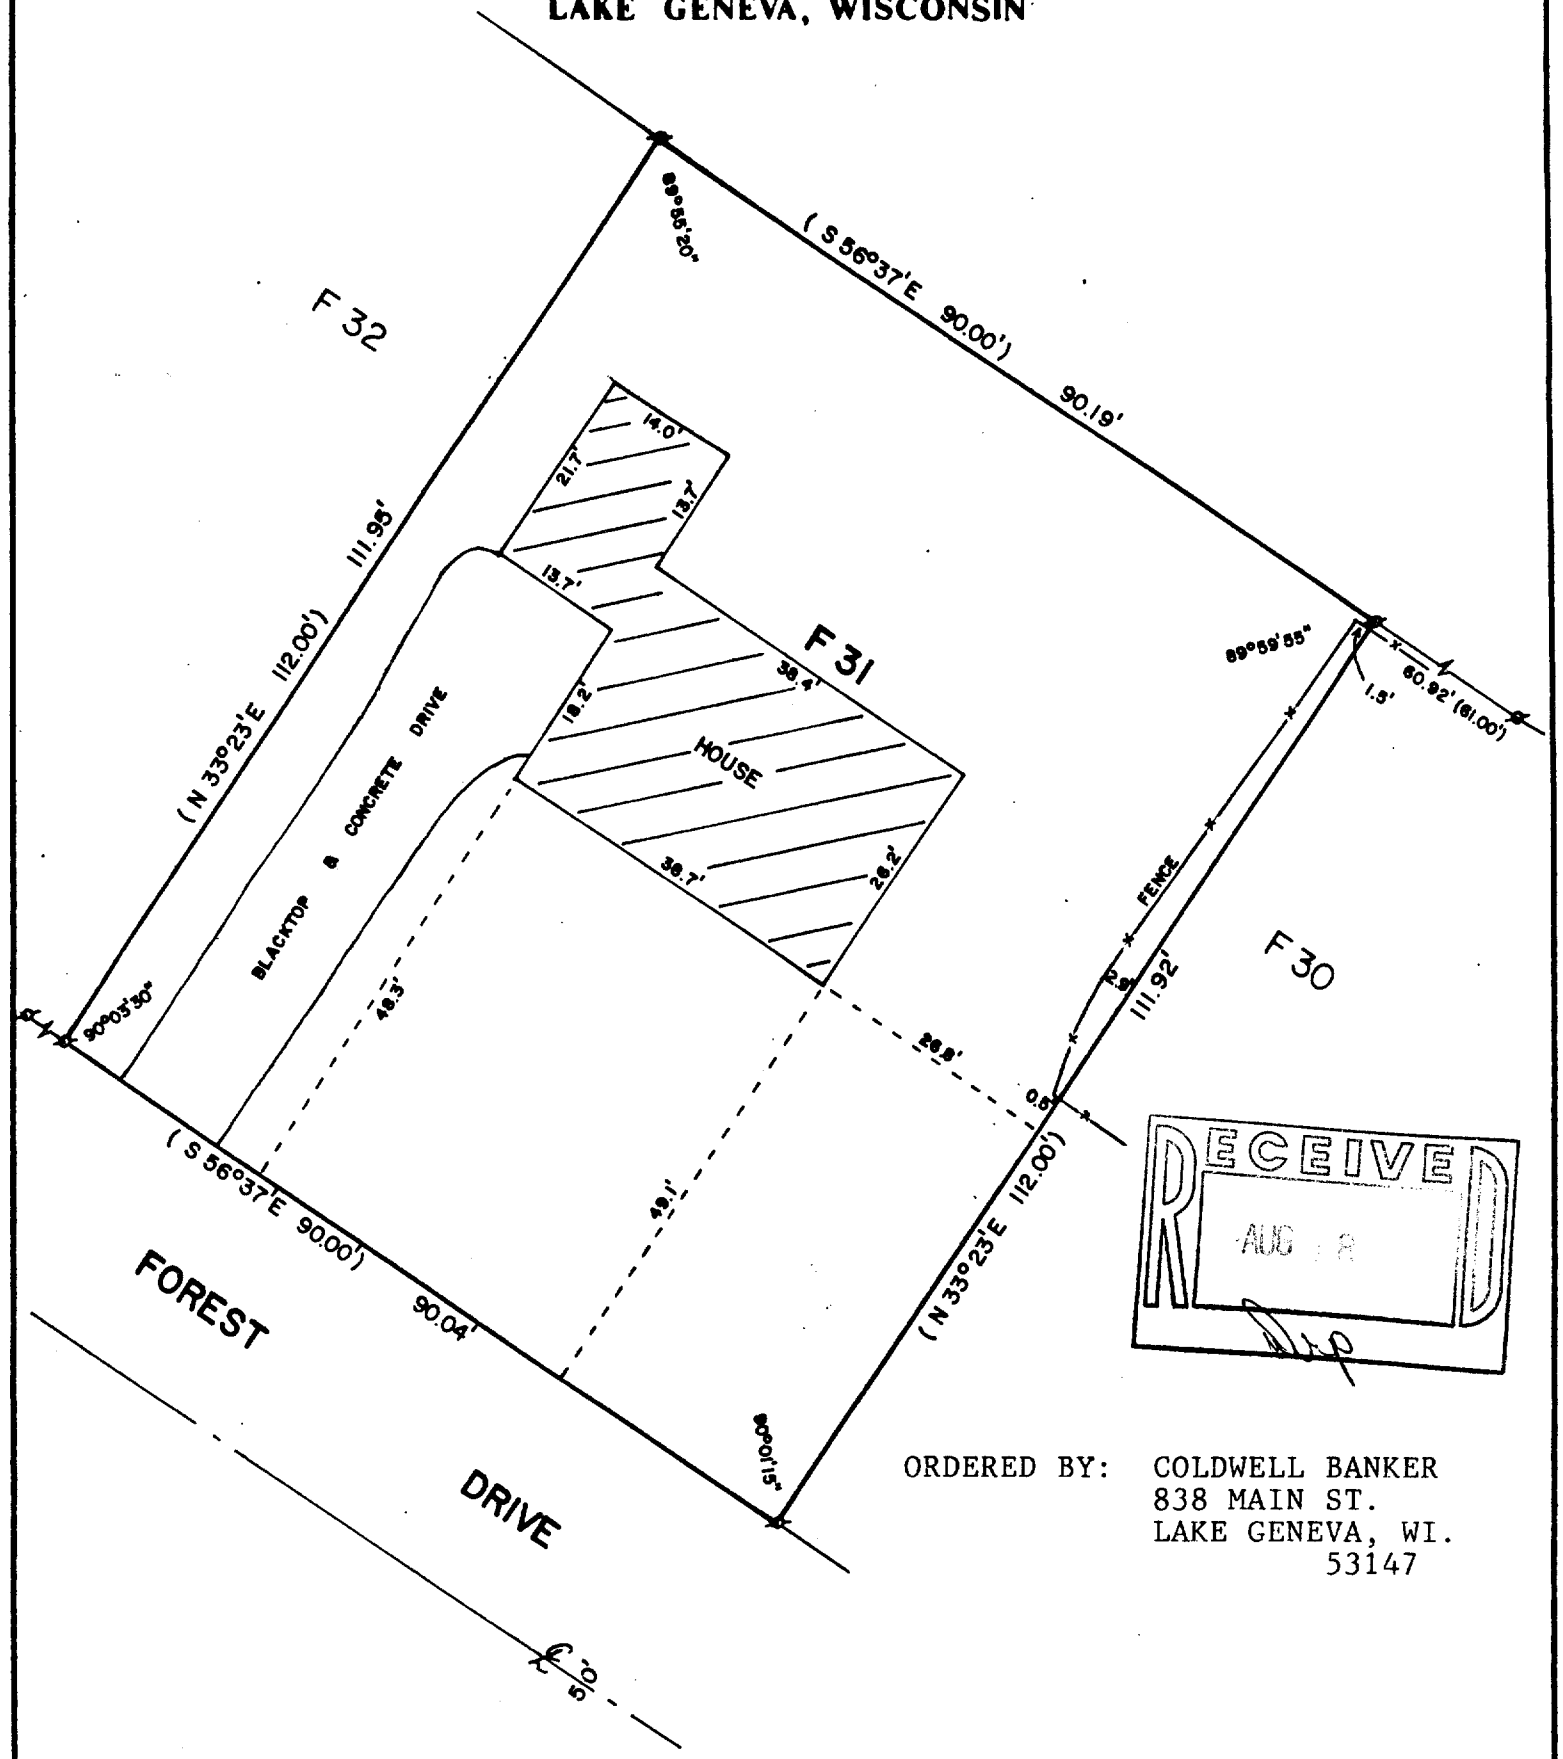

RECEIVED
AUG

ORDERED BY: COLDWELL BANKER
838 MAIN ST.
LAKE GENEVA, WI.
53147

PLAT OF SURVEY OF

LOT F31 OF COUNTRY CLUB ESTATES ADDITION F, VILLAGE OF FONTANA-ON-GENEVA LAKE, WALWORTH COUNTY, WISCONSIN.

SCALE - 1"=20'

LEGEND
ø - IRON PIPE FOUND
( )- RECORDED AS

I, ROBERT M. BAERENWALD, DO HEREBY CERTIFY THAT I HAVE SURVEYED THE PROPERTY HEREON DESCRIBED ACCORDING TO THE OFFICIAL RECORDS AND THAT THE PLAT HEREON IS A CORRECT REPRESENTATION OF THE PROPERTY LINES TO THE BEST OF MY KNOWLEDGE AND BELIEF.

Robert M. Baerenwald
ROBERT M. BAERENWALD
WISCONSIN REGISTERED LAND SURVEYOR, S-1508

July 15, 1987
DATE JOB NO. 1149

NOTE: THIS IS NOT A CERTIFIED COPY UNLESS SEALED.

SCT F-31

5-742