AMBIT LAND SURVEYING
P. O. Box 42
Bassett, Wisconsin 53101-0042

PLAT OF SURVEY
OF

PHONE: 262-537-4874
FAX: 262-537-4221

Lot 4, Block 1 of GIFFORD'S ADDITION TO THE GENOA JUNCTION, being a subdivision of part of the Northeast Quarter of Section 35, Township 1 North, Range 18 East of the 4th Principal Meridian, now the Village of Genoa City, Walworth County, Wisconsin.

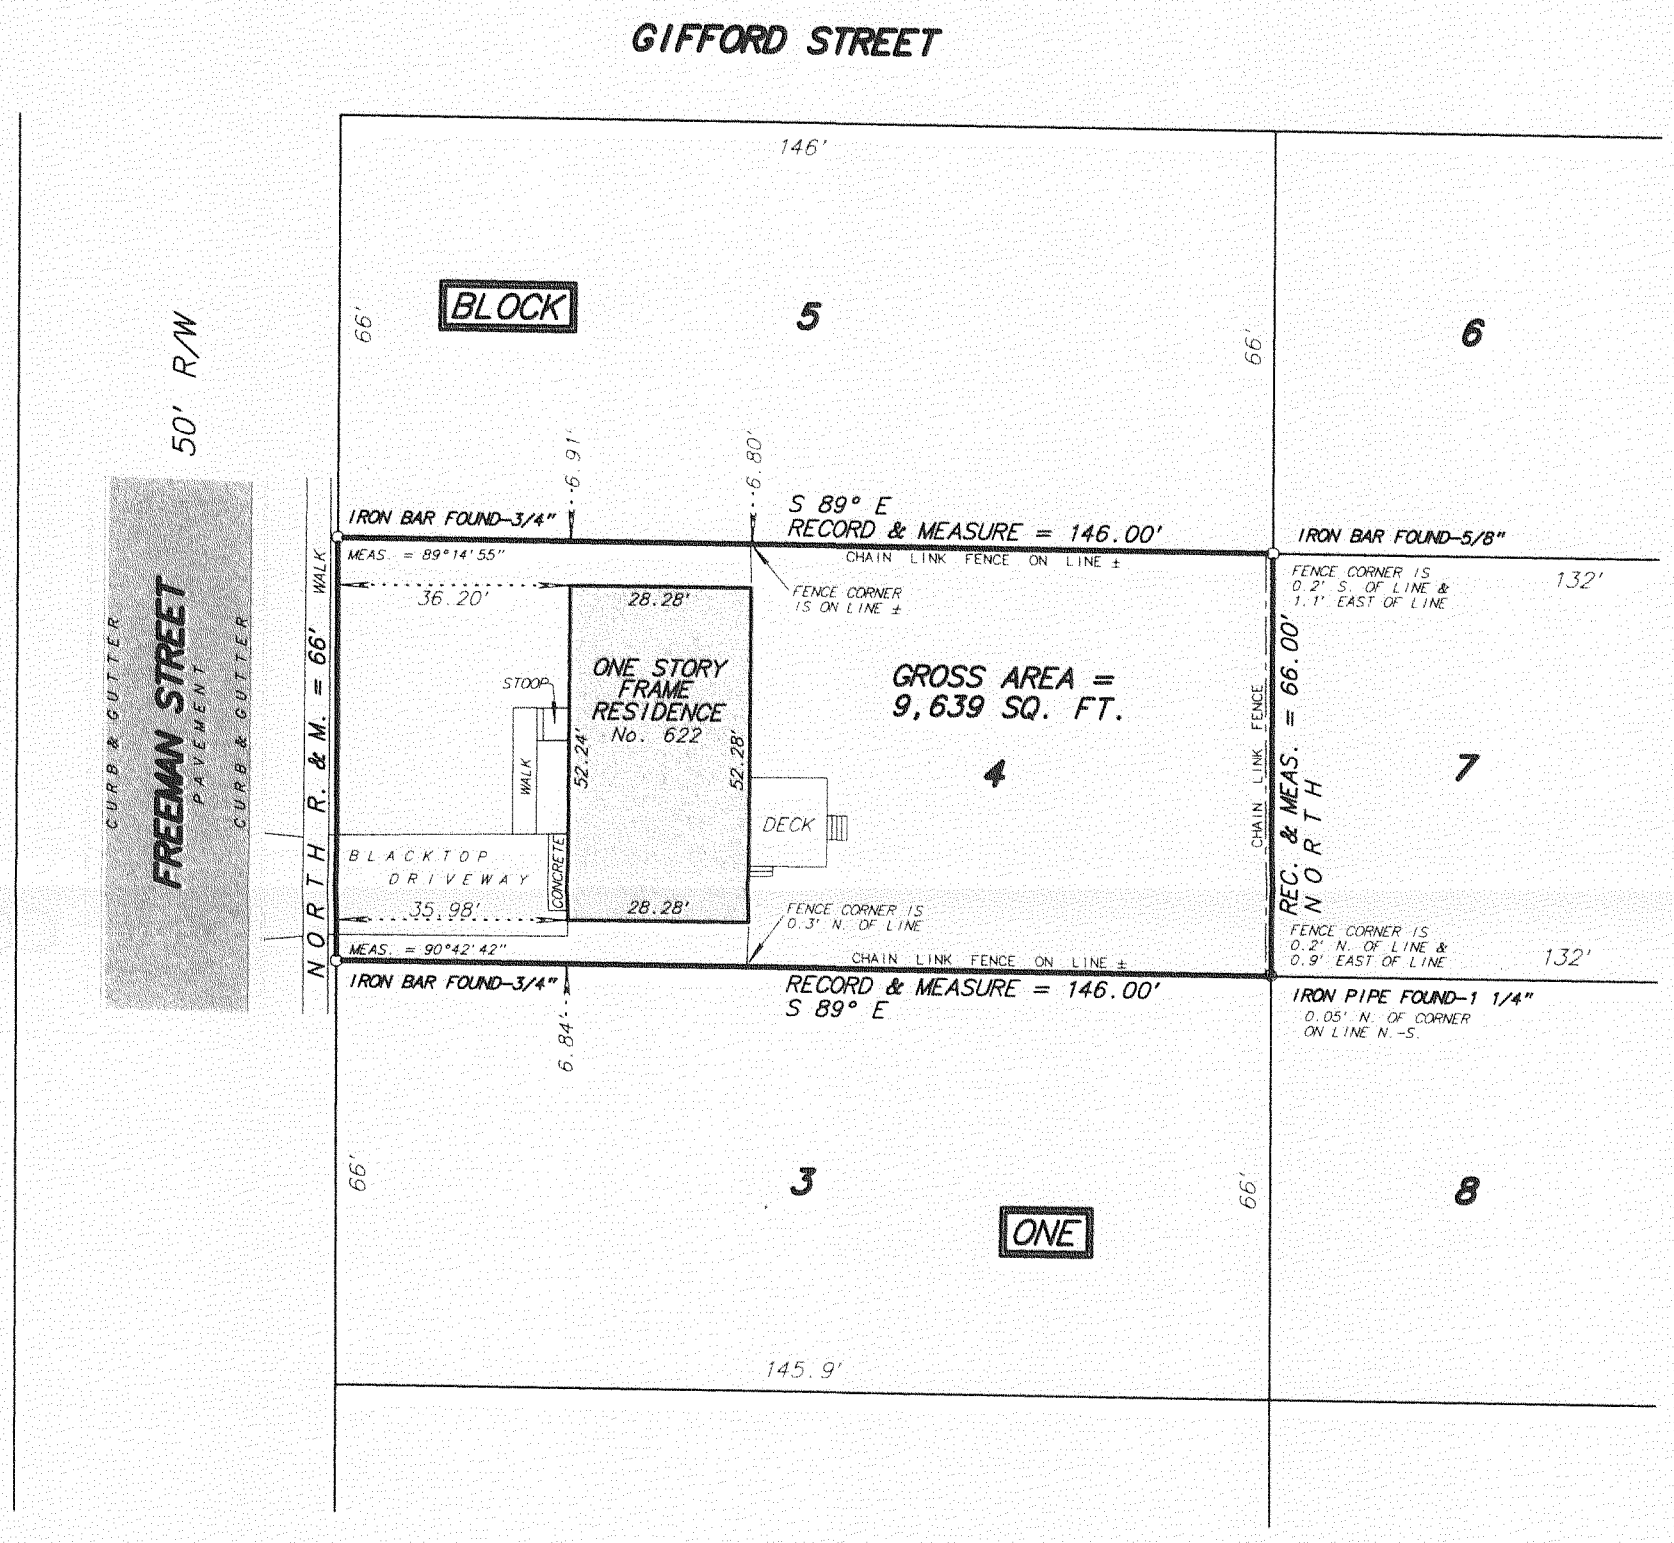

RECEIVED
FEB 19 2007
SMF

SCALE: 1 inch = 30 feet
ORDERED BY: L. King-Krause / Prudential First Realty
JOB NO. 0 6 1 9 7

I hereby certify that I have surveyed the above described property and the above plat is a true representation thereof and shows the size and location of the property, its exterior boundaries, the location and dimensions of all visible structures thereon, boundary fences, apparent easements and roadways and visible encroachments, if any.

This survey is made for the exclusive use of the present owners of the property, and also those who purchase, mortgage or guarantee the title thereto within ONE YEAR from the date hereof.

Dated at Bassett, Wisconsin this _____ day of _____ 2006.

Mark A. Bolender
Wisconsin Registered Land Surveyor S - 1784

TG-4

006-1247