

PLAT OF SURVEY OF



LOT 1, EXCEPT THE NORTH 50 FEET THEREOF, LOT 2, LOT 3 AND LOT 4, EXCEPT THE SOUTH 22 FEET THEREOF, ALL IN BLOCK 2 OF FREEMAN'S 2ND ADDITION TO THE VILLAGE OF GENOA, LOCATED IN THE WEST PART OF THE NE 1/4 OF THE SE 1/4 OF SECTION 35, T. 1 N., R. 18 E. OF THE 4TH P.M., VILLAGE OF GENOA CITY, WALWORTH COUNTY, WISCONSIN.

FOR: KATZENBERG AND SCHUREN

SCALE 1" = 30'

BEARINGS RELATE TO SUMNER ST. WHICH WAS USED AS PLATTED AS N. 0°05' E.

- = IRON ROD FOUND.
- = IRON PIPE STAKE FOUND.
- = IRON PIPE STAKE SET.
- = CONCRETE MONUMENT FOUND.
- X = CROSS CUT IN CONCRETE.
- () DENOTES RECORD DATA
- = UNDERGROUND UTILITY JUNCTION

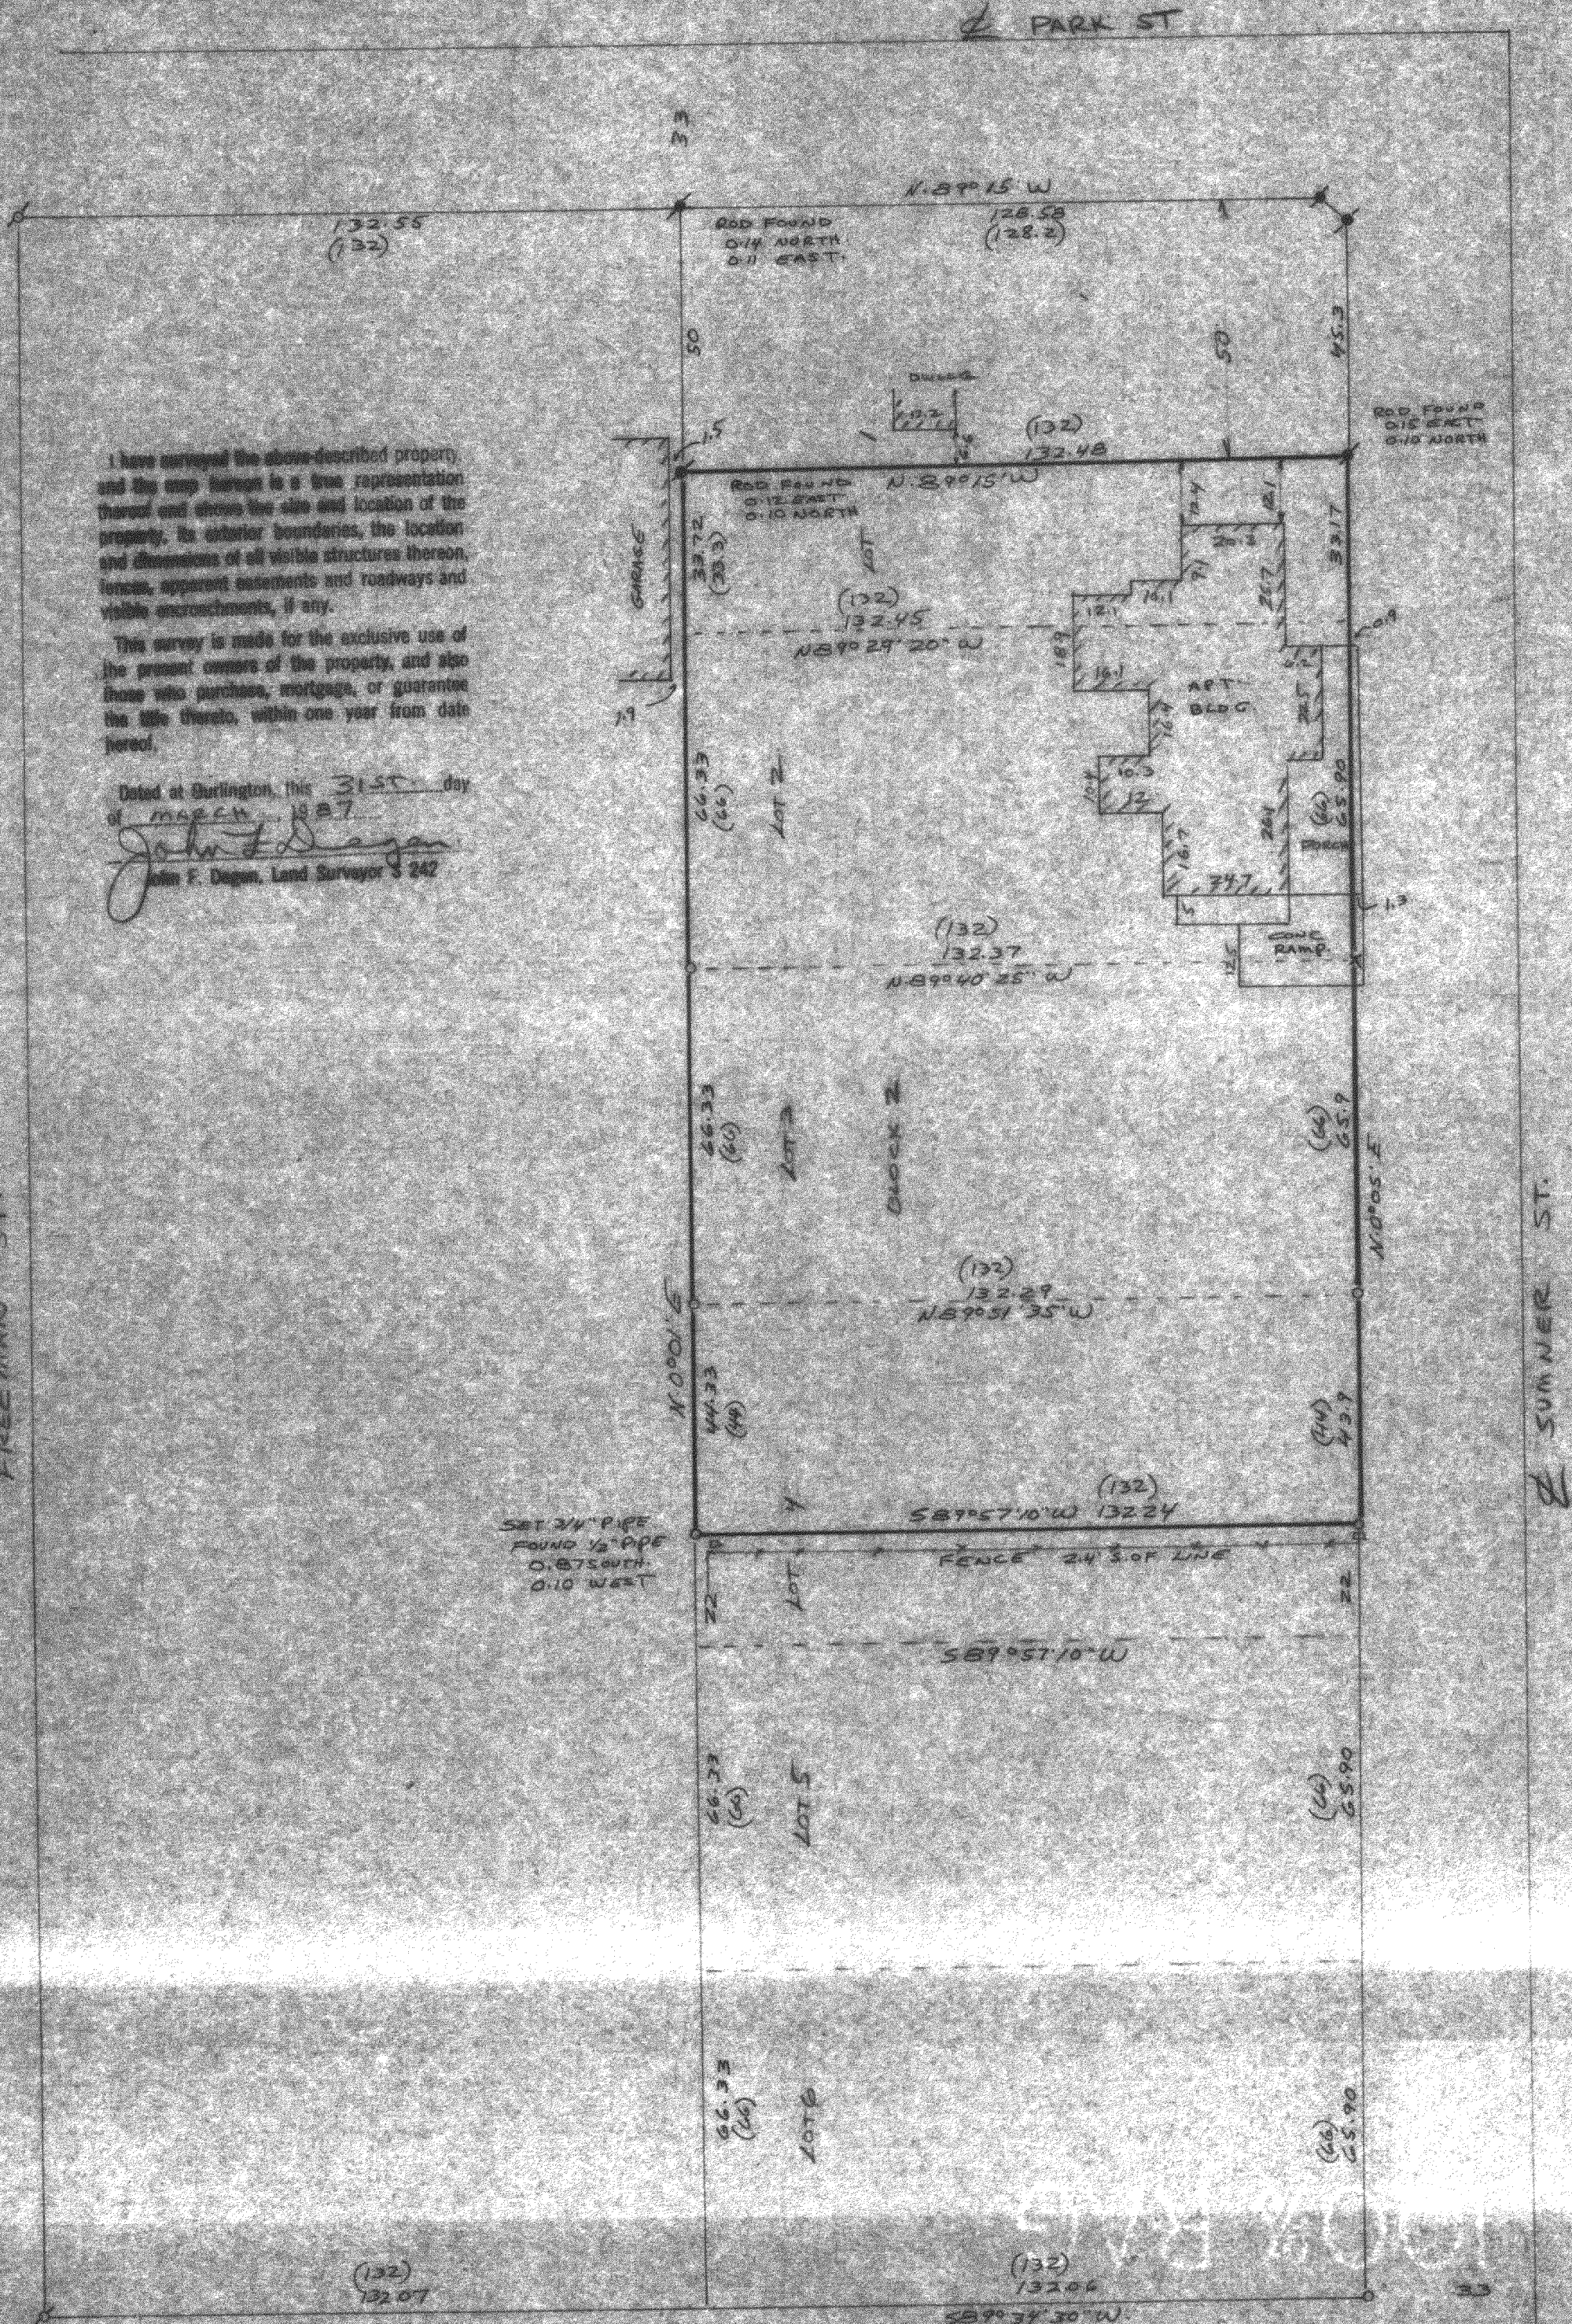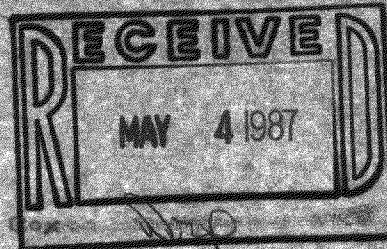

I have surveyed the above-described property, and the map herein is a true representation thereof and shows the size and location of the property, its exterior boundaries, the location and dimensions of all visible structures thereon, fences, apparent easements and roadways and visible encroachments, if any.

This survey is made for the exclusive use of the present owners of the property, and also those who purchase, mortgage, or guarantee the title thereto, within one year from date hereof.

Dated at Burlington, this 31st day of MARCH, 1987.

John F. Degen, Land Surveyor S 242