PLAT OF SURVEY
-OF-

BEGIN AT THE NORTHWEST CORNER OF SECTION 36, TOWN 1 NORTH, RANGE 18 EAST, GO THENCE SOUTH ALONG THE WEST LINE OF SAID SECTION 227.15 FEET TO A POINT AND THE PLACE OF BEGINNING, GO THENCE EAST 230 FEET, GO THENCE SOUTH 100 FEET, GO THENCE WEST 230 FEET, GO THENCE NORTH ALONG THE WEST LINE OF SAID SECTION, 100 FEET TO A POINT AND THE PLACE OF BEGINNING, SAID LAND BEING SITUATED IN THE VILLAGE OF GENOA CITY, WALWORTH COUNTY, STATE OF WISCONSIN.

SURVEY FOR: COLDWELL BANKER-CERTARE REALTY
SURVEY LOCATION: 928 CARTER STREET

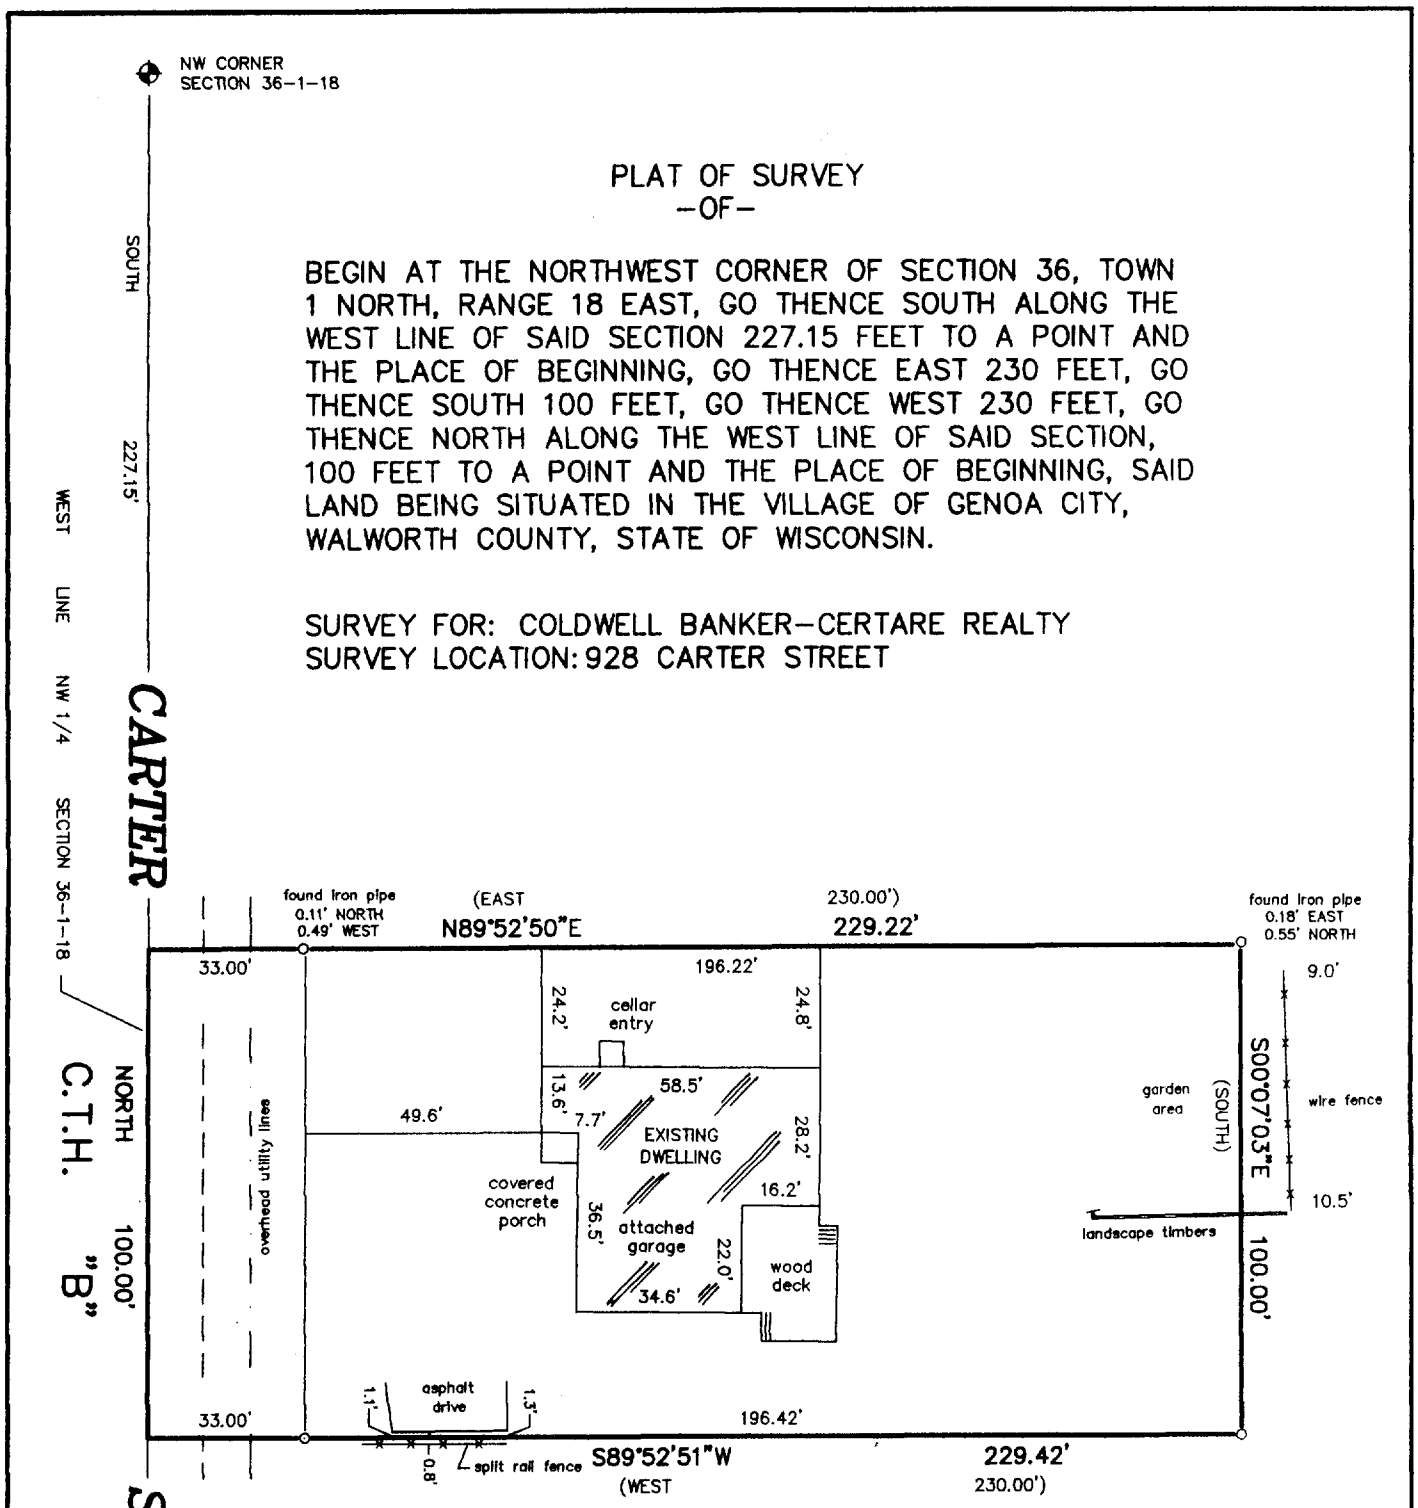

NOTE: RIGHT OF WAY LINE PER PREVIOUS SURVEYS OF RECORD BY DEGEN AND BOLANDER SHOW RIGHT OF WAY LINE FOR CARTER STREET TO BE 33' EAST OF SECTION LINE.

RECEIVED
FEB 2 9 2000

WEST 1/4 CORNER
SECTION 36-1-18

LEGEND

o FOUND IRON PIPE

FOUND CONCRETE MONUMENT WITH BRASS CAP

( ) RECORDED AS

SCALE: 1" = 40'

WISCONSIN
ROBERT J. WETZEL
S-1778
BURLINGTON
WIS.
LAND SURVEYOR

"I hereby certify that I have surveyed the above described property and that the above map is a correct representation thereof and shows the size and location of the property, its exterior boundaries, the location of all visible structures and dimensions of all principal buildings thereon, boundary fences, apparent easements, roadways and encroachments, if any."

"This survey is made for the use of the present owners of the property, and those who purchase, mortgage, or guarantee the title thereto within one year from date hereof."

THIS IS NOT AN ORIGINAL PRINT UNLESS THIS SEAL IS RED.

B.W. SURVEYING
412 N. PINE STREET
BURLINGTON, WI 53105
(414)-767-0225

Robert J. Wetzel
ROBERT J. WETZEL S-1778

REVISED: OCTOBER 4, 1999
SEPTEMBER 20, 1999 — DATE
4181 — JOB NUMBER

TVGC-85D

0006-715