KOLB LAND CONSULTING, INC.

LAND SURVEYING · SUBDIVIDING · LAND PLANNING

LAKE GENEVA, WISCONSIN 53147 WHITEWATER, WISCONSIN 53190

PLAT OF SURVEY OF

LOTS 8,9,10 AND THE SOUTH 66 FEET OF LOT 11, MANOR'S ADDITION, VILLAGE OF GENOA CITY, WALWORTH COUNTY, WISCONSIN.

ORDERED BY: JOHN WEST OF THE VILLAGE OF GENOA CITY

NOTE: OUTLOT 3 OF ANDERS ADDITION IS FOR VEHICULAR ACCESS.

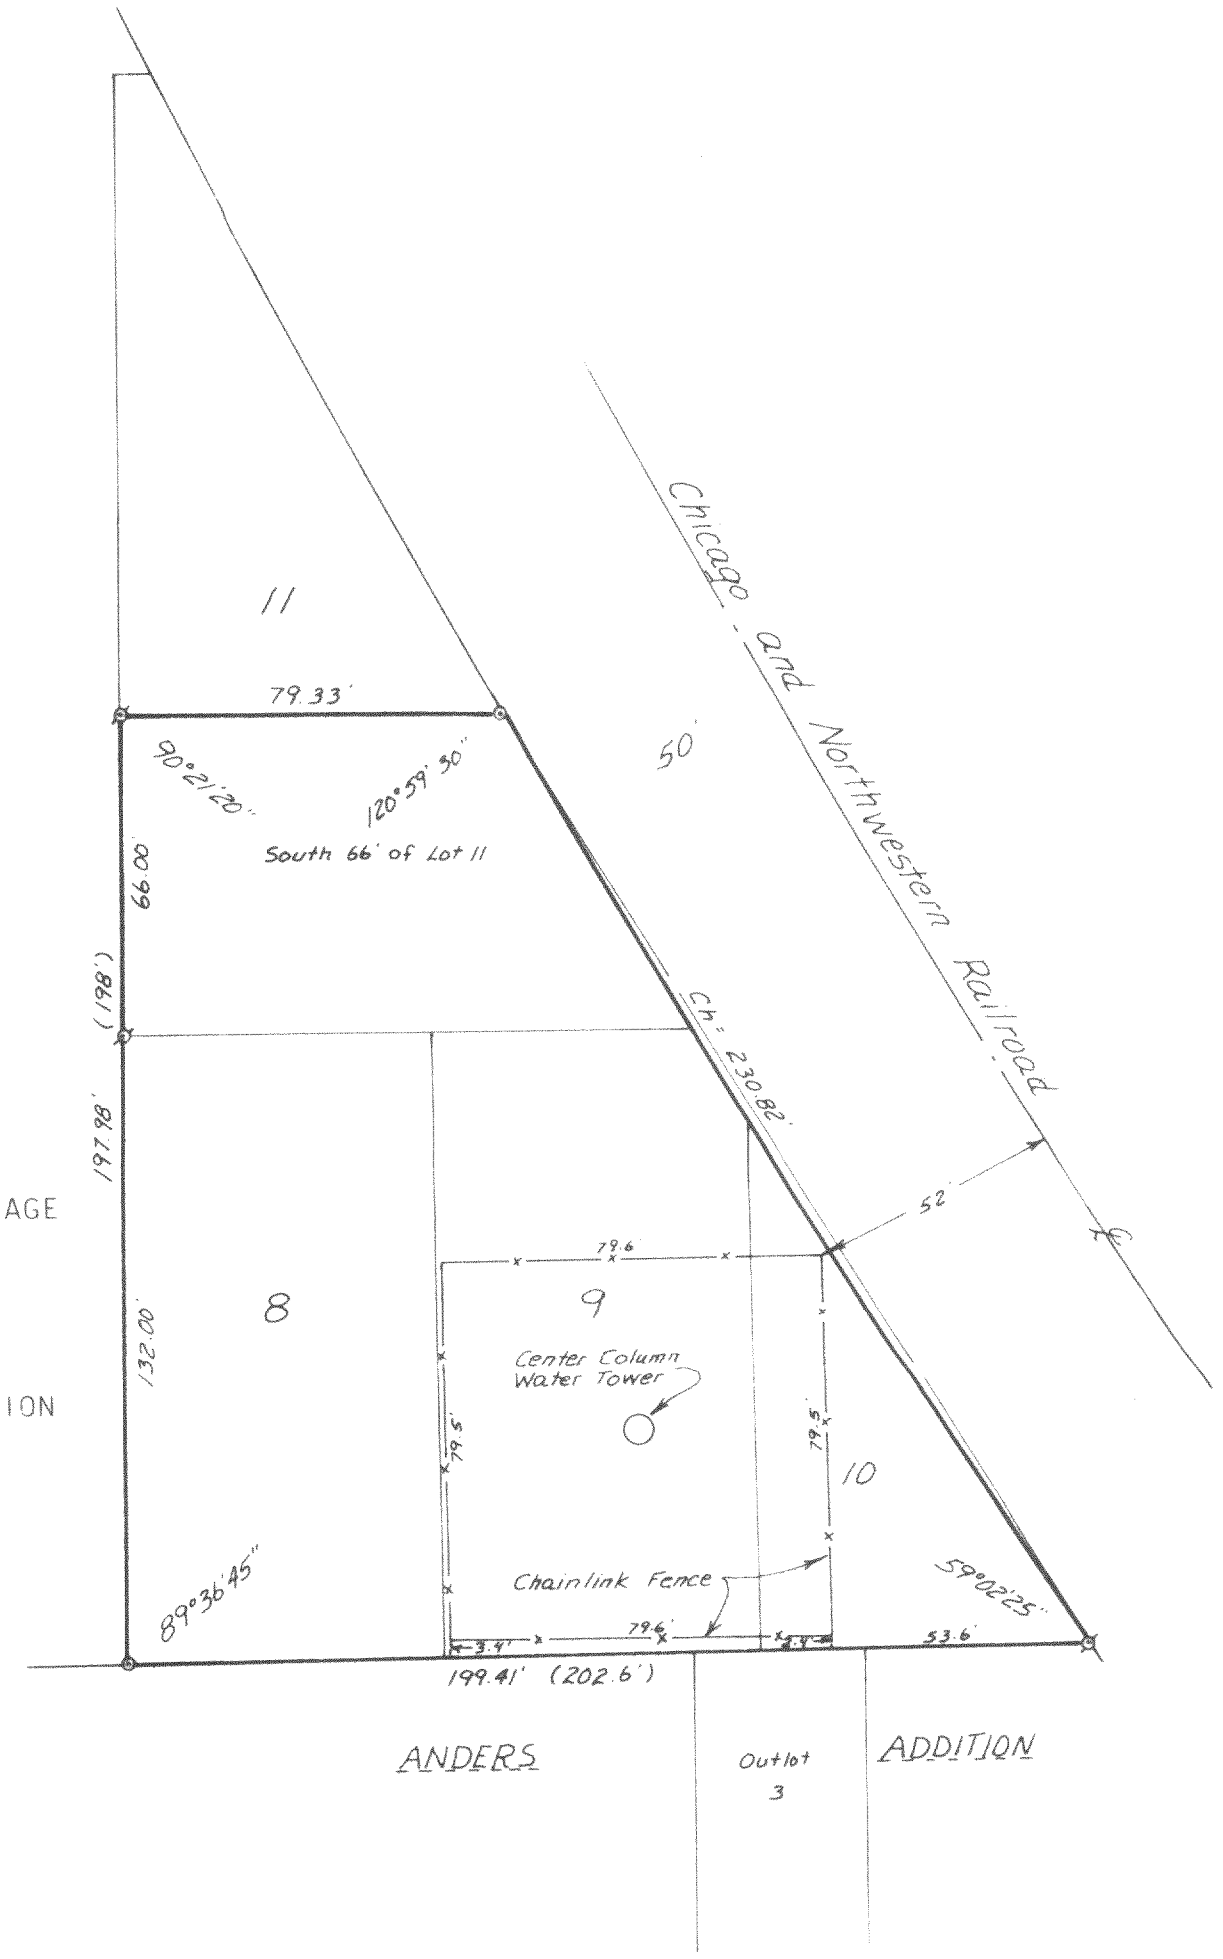

SCALE · 1"=40'

LEGEND

⌀ - IRON PIPE FOUND
o - IRON PIPE SET
( ) - RECORDED AS

WISCONSIN HAROLD H. KOLB S-127 LAKE GENEVA, WIS. REGISTERED LAND SURVEYOR

I, HAROLD H. KOLB, DO HEREBY CERTIFY THAT I HAVE SURVEYED THE PROPERTY HEREON DESCRIBED ACCORDING TO THE OFFICIAL RECORDS, AND THAT THE PLAT HEREON IS A CORRECT REPRESENTATION OF THE LOT LINES TO THE BEST OF MY KNOWLEDGE AND BELIEF.

Harold H. Kolb

WISCONSIN REGISTERED LAND SURVEYOR, S-127

DATE April 13, 1981

TM-8

6-141