
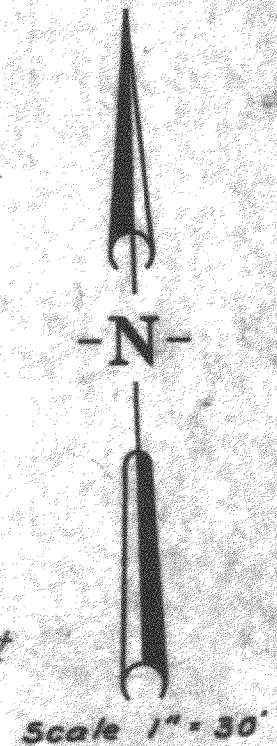


REGISTERED PROFESSIONAL LAND SURVEYOR
LAKE GENEVA, WISCONSIN

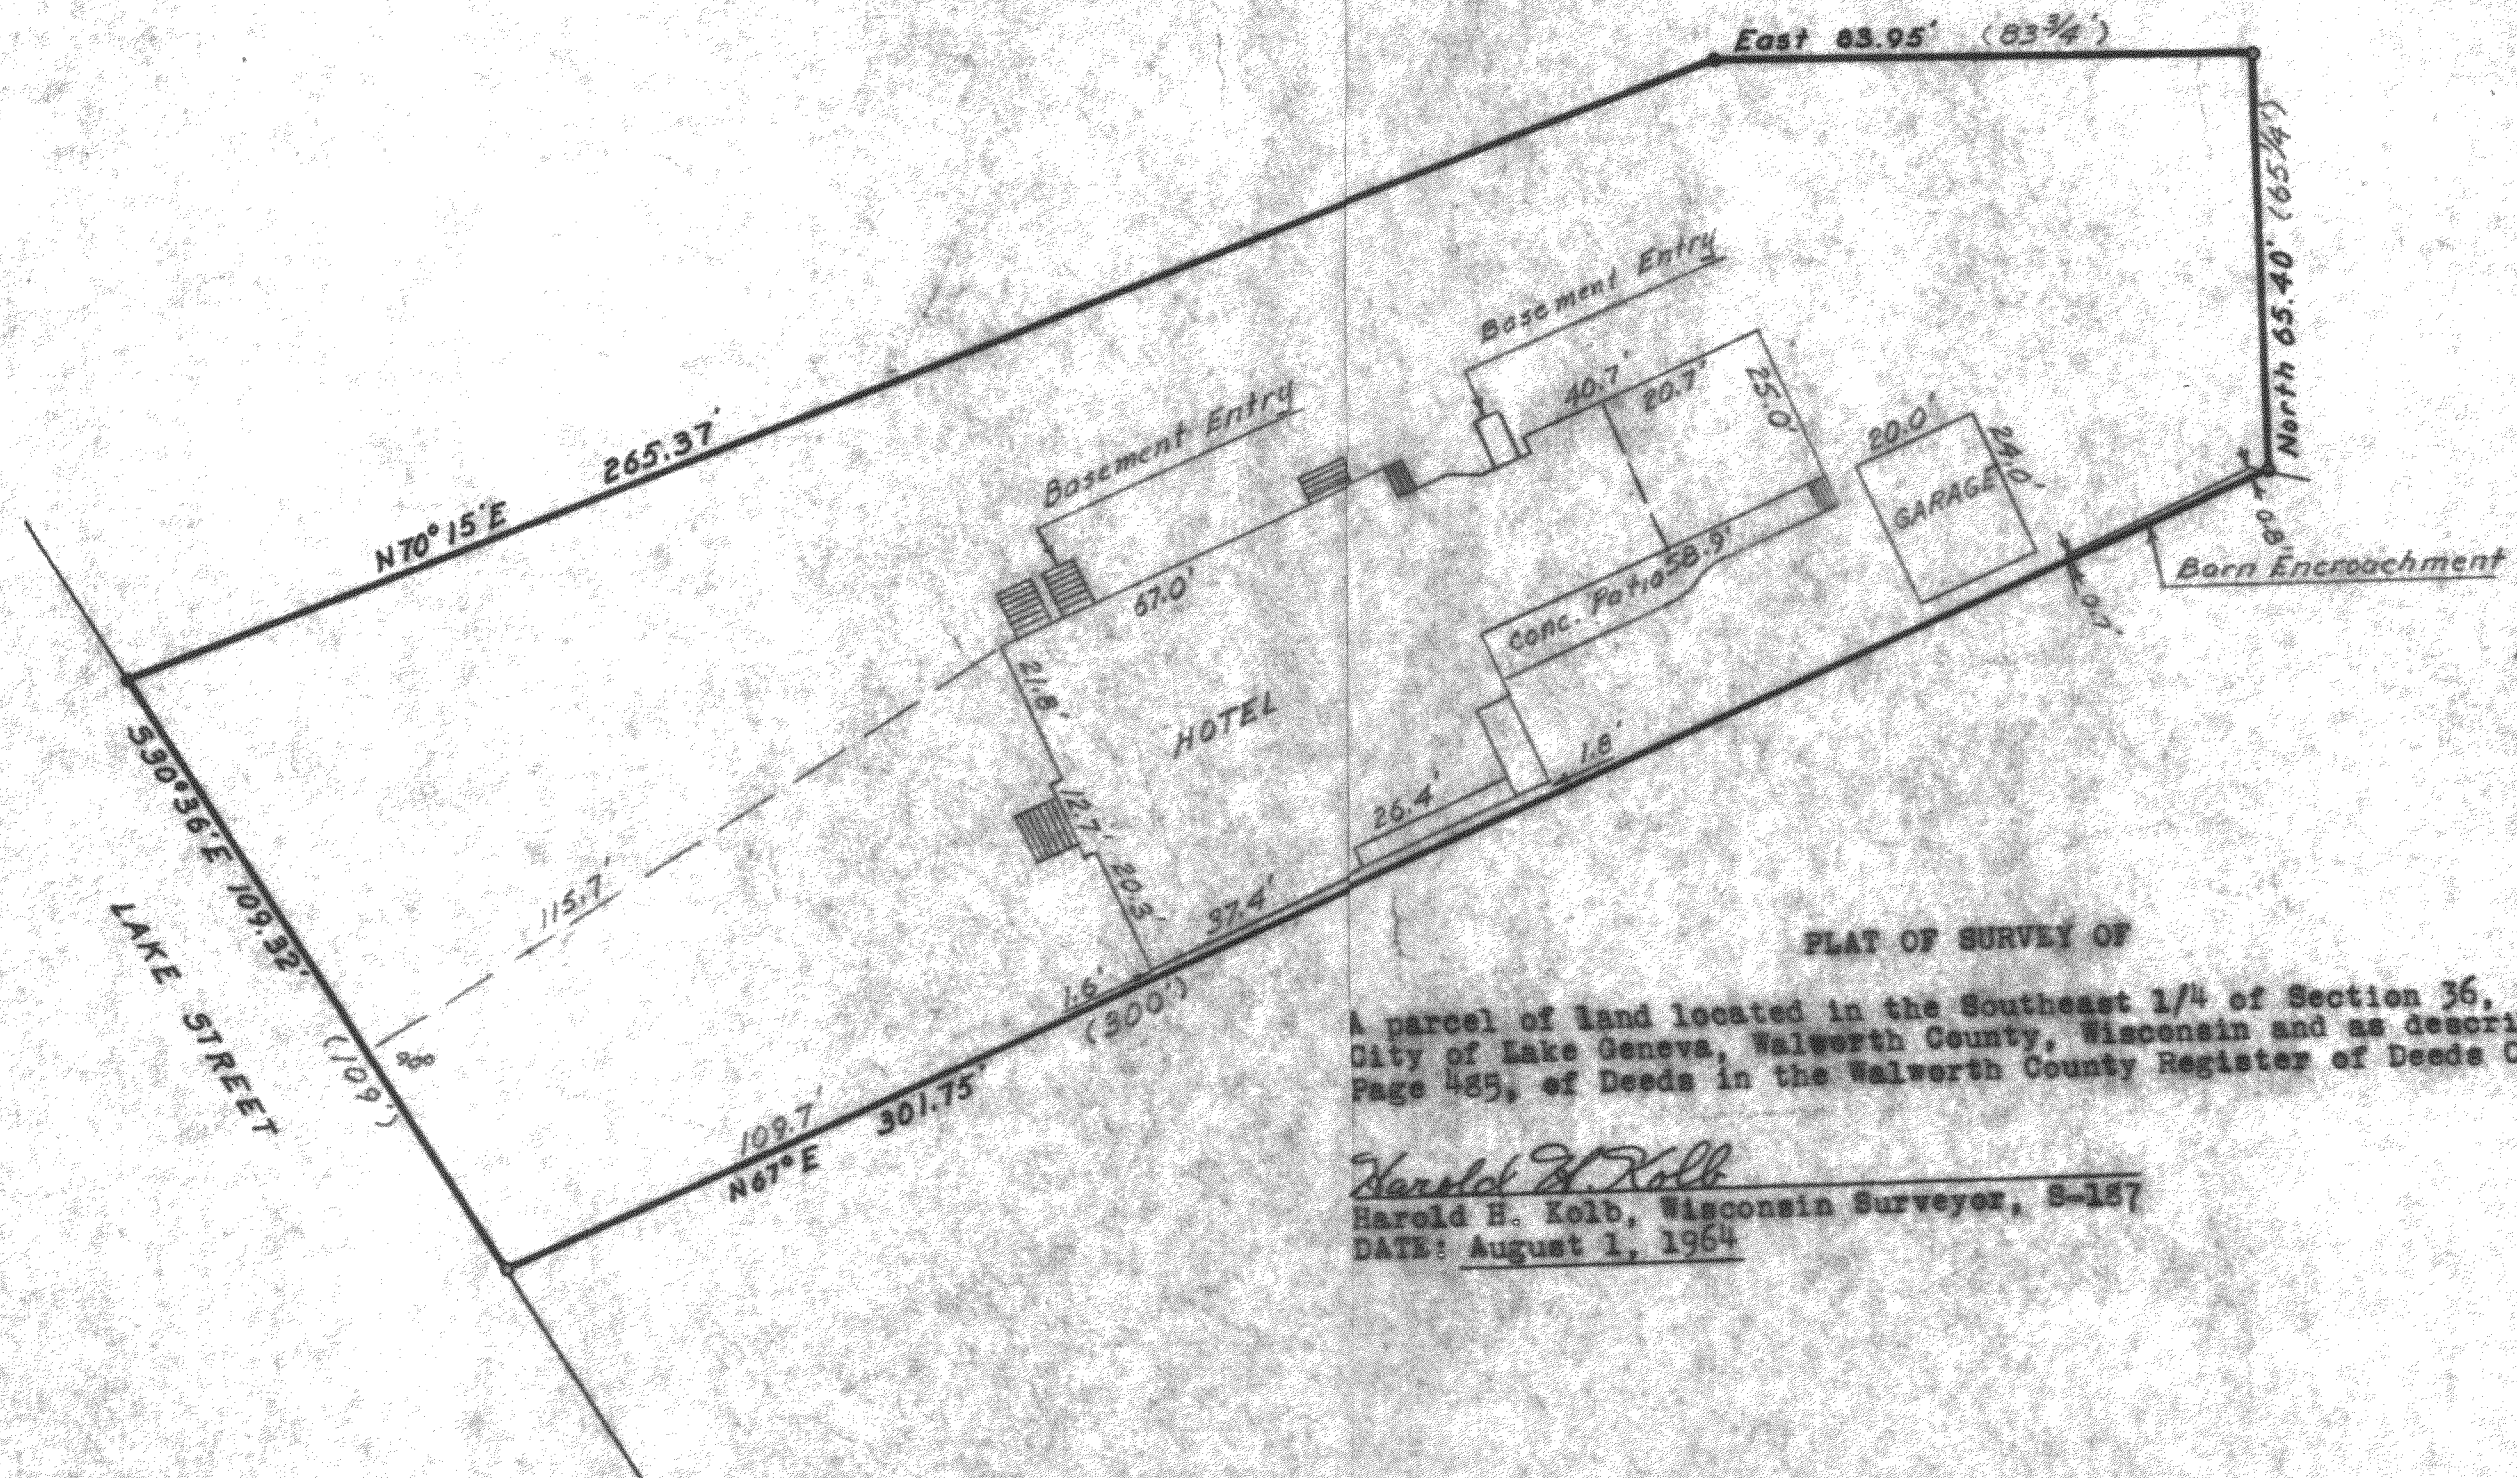

PLAT OF SURVEY OF
A parcel of land located in the Southeast 1/4 of Section 36, T 2 N, R 17 E,
City of Lake Geneva, Walworth County, Wisconsin and as described in Vol. 509,
Page 485, of Deeds in the Walworth County Register of Deeds Office.

Harold H. Kolb
Harold H. Kolb, Wisconsin Surveyor, S-157
DATE: August 1, 1964