LAND-MARK SURVEYING
Mark L. Miritz
Wisconsin Professional Land Surveyor S-2582

N9330 Knuteson Drive
Whitewater, WI 53190
Phone:(262)495-3284
MARKMIRITZ@
LAND-MARKSURVEYING.COM

ORDERED BY:
FAIRWYN
875 E. TOWNLINE ROAD
LAKE GENEVA, WI 53147

PLAT OF SURVEY

LOT 43 AND LOT 44 OF PARADISE VISTA SUBDIVISION, LOCATED IN THE SOUTHEAST 1/4 OF SECTION 1, TOWN 1 NORTH, RANGE 17 EAST, CITY OF LAKE GENEVA, WALWORTH COUNTY, WISCONSIN.

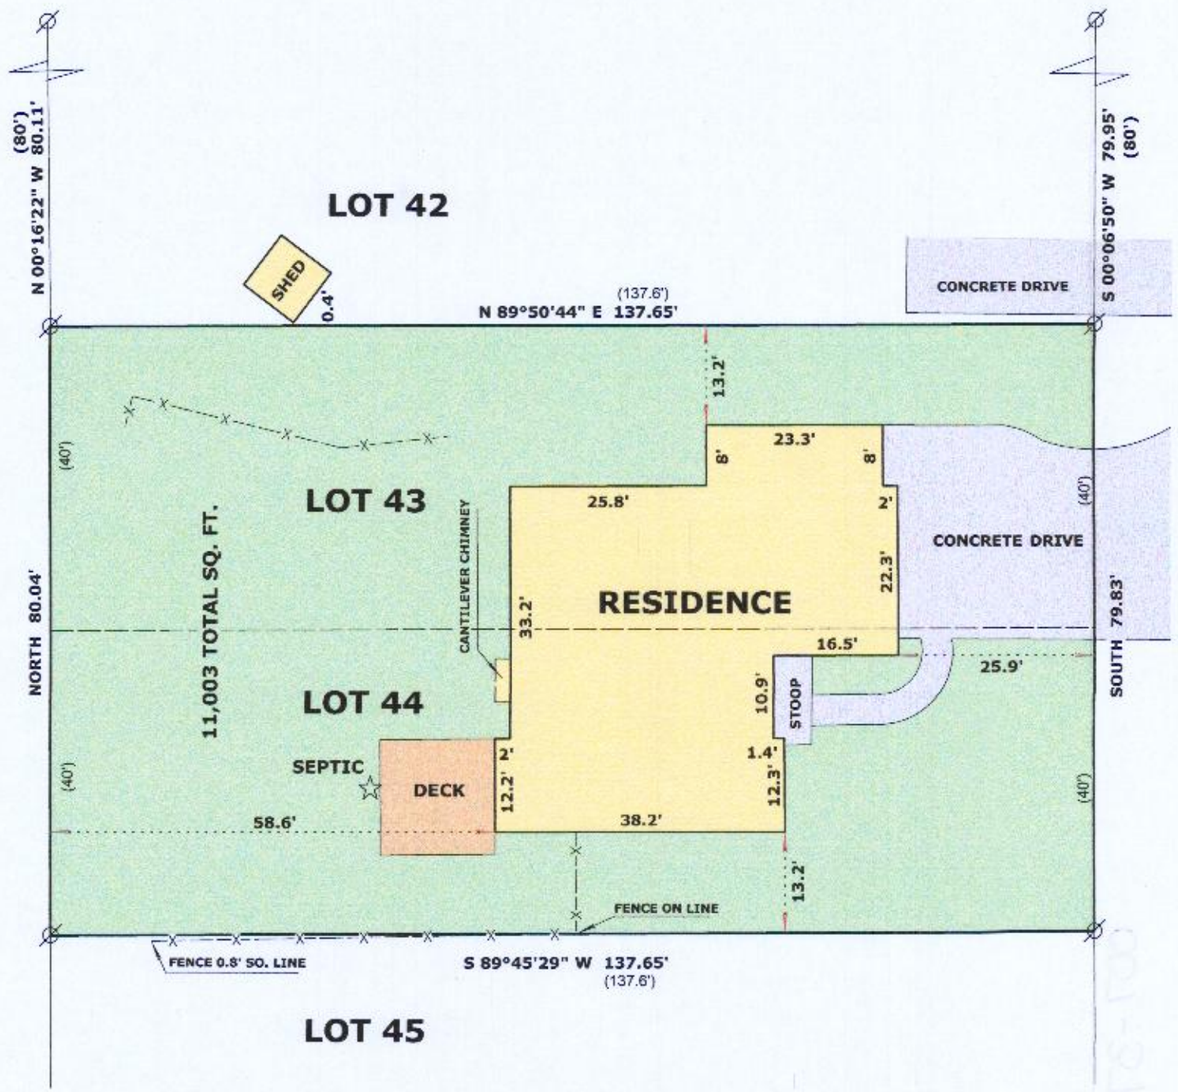

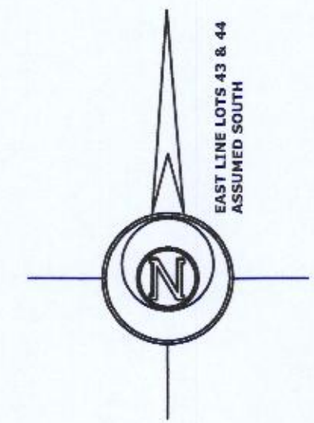

RECEIVED
APR 28 2020
By SMF

LEGEND

⌀	FOUND IRON PIPE
(x x)	RECORDED AS DIMENSION
—x—x—	EXISTING WOOD FENCE

SCALE: 1 INCH = 20 FEET

"I hereby certify that the above described property has been surveyed by me or under my direction and that the above map is a true representation thereof and shows the size and location of the property, its exterior boundaries, the location of all visible structures and dimensions of all principal buildings thereon, boundary fences, apparent easements, roadways and visible encroachments, if any."
"This survey is made for the use of the present owners of the property, and also those who purchase, mortgage, or guarantee the title thereto within one year from date hereof."

WISCONSIN MARK L. MIRITZ S-2582 WHITEWATER, WI LAND SURVEYOR

Mark L. Miritz
MARK L. MIRITZ
WISCONSIN PROFESSIONAL
LAND SURVEYOR S-2582

DATE: FEB. 26, 2020 JOB NO. 20.205

ZPAV-5

007-3731