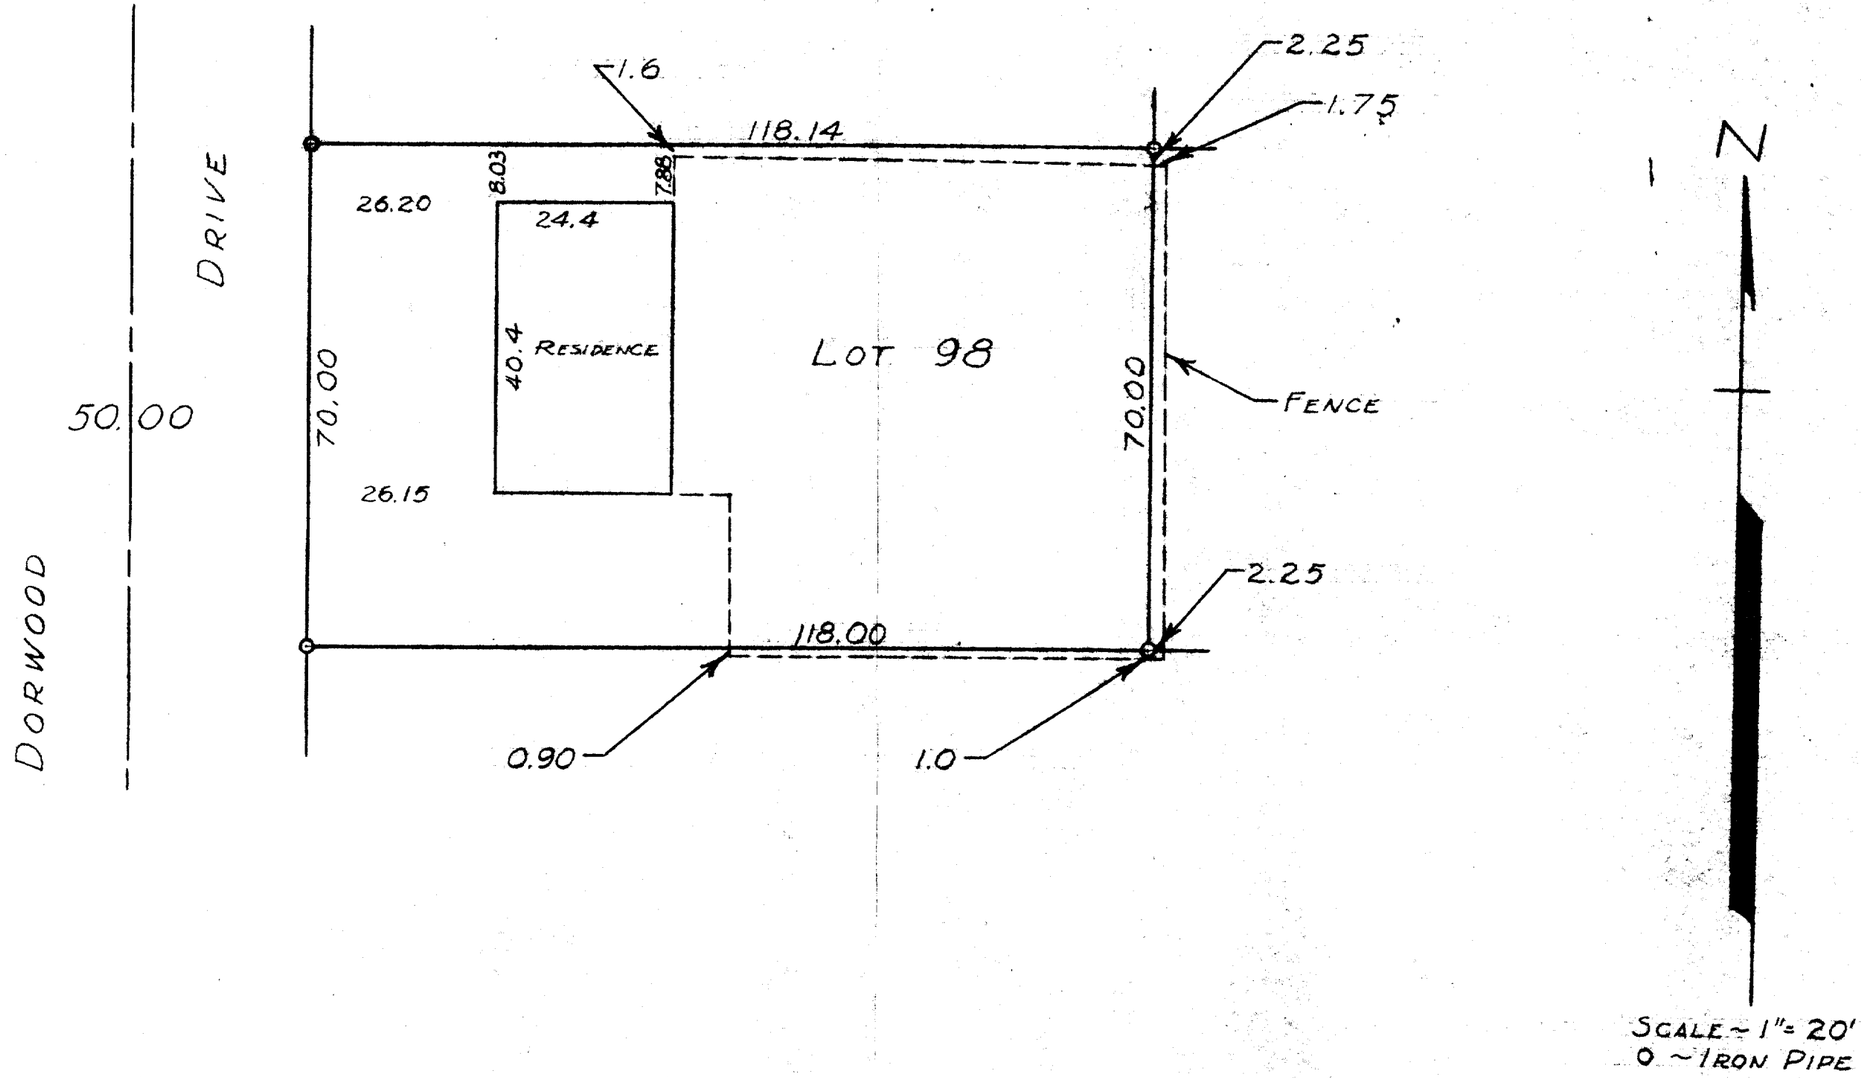

STATE OF WISCONSIN }
COUNTY OF WALWORTH } S.S.

I, GEORGE T. DUNHAM, DO HEREBY CERTIFY THAT I HAVE SURVEYED THE PROPERTY DESCRIBED AS FOLLOWS:

LOT 98, H. E. WELLS ADDITION TO THE CITY OF LAKE GENEVA, WALWORTH COUNTY, WISCONSIN.

AND THAT THE PLAT SHOWN ABOVE IS A CORRECT REPRESENTATION OF THE PROPERTY LINES AND THE IMPROVEMENTS LOCATED THEREON.

SEPTEMBER 16, 1957

George T. Dunham 7-60

GEORGE T. DUNHAM, SURVEYOR,
DELAVAN, WISCONSIN

ZWE-98