PLAT OF SURVEY OF

PART OF LOT 11 OF BLOCK 13 OF THE ORIGINAL PLAT OF THE CITY OF LAKE GENEVA, WALWORTH COUNTY, WISCONSIN

SURVEYED FOR: GLADYS NUOFFER ESTATE
c/o ELVIN CRISPELL
103 N. CHURCH ST.
ELKHORN, WIS. 53121

SURVEYED BY: JENSEN SURVEYING & MAPPING, S.C.
45 S. WISCONSIN
P.O BOX 322
ELKHORN, WIS. 53121-0322

WISCONSIN
THOMAS P. A. JENSEN
S-1084
ELKHORN, WIS.
LAND SURVEYOR

N

LEGEND

O - 1" DIA. IRON PIPE FOUND
● - 3/4" DIA. IRON ROD FOUND
+ - CHISEL CROSS CUT FOUND
—x—x— - EXISTING FENCE
( ) - RECORDED AS

NOTE: NORTH LINE OF WISCONSIN ST. HAS BEEN ASSUMED AS "WEST"
MAPPING DATE: FEB. 16, 1983

I HEREBY CERTIFY THAT I HAVE SURVEYED THE ABOVE DECRIBED PROPERTY, THAT THE PLAT SHOWN HEREON IS AN ACCURATE SURVEY, A TRUE REPRESENTATION THEREOF, CORRECTLY SHOWS THE EXTERIOR BOUNDARY LINES OF SAID PROPERTY, THE CORRECT MEASUREMENTS THEREOF, AND IMPROVEMENTS THEREON

Thomas P. A. Jensen
THOMAS P.A. JENSEN RLS 1084

SCALE 1"=20'

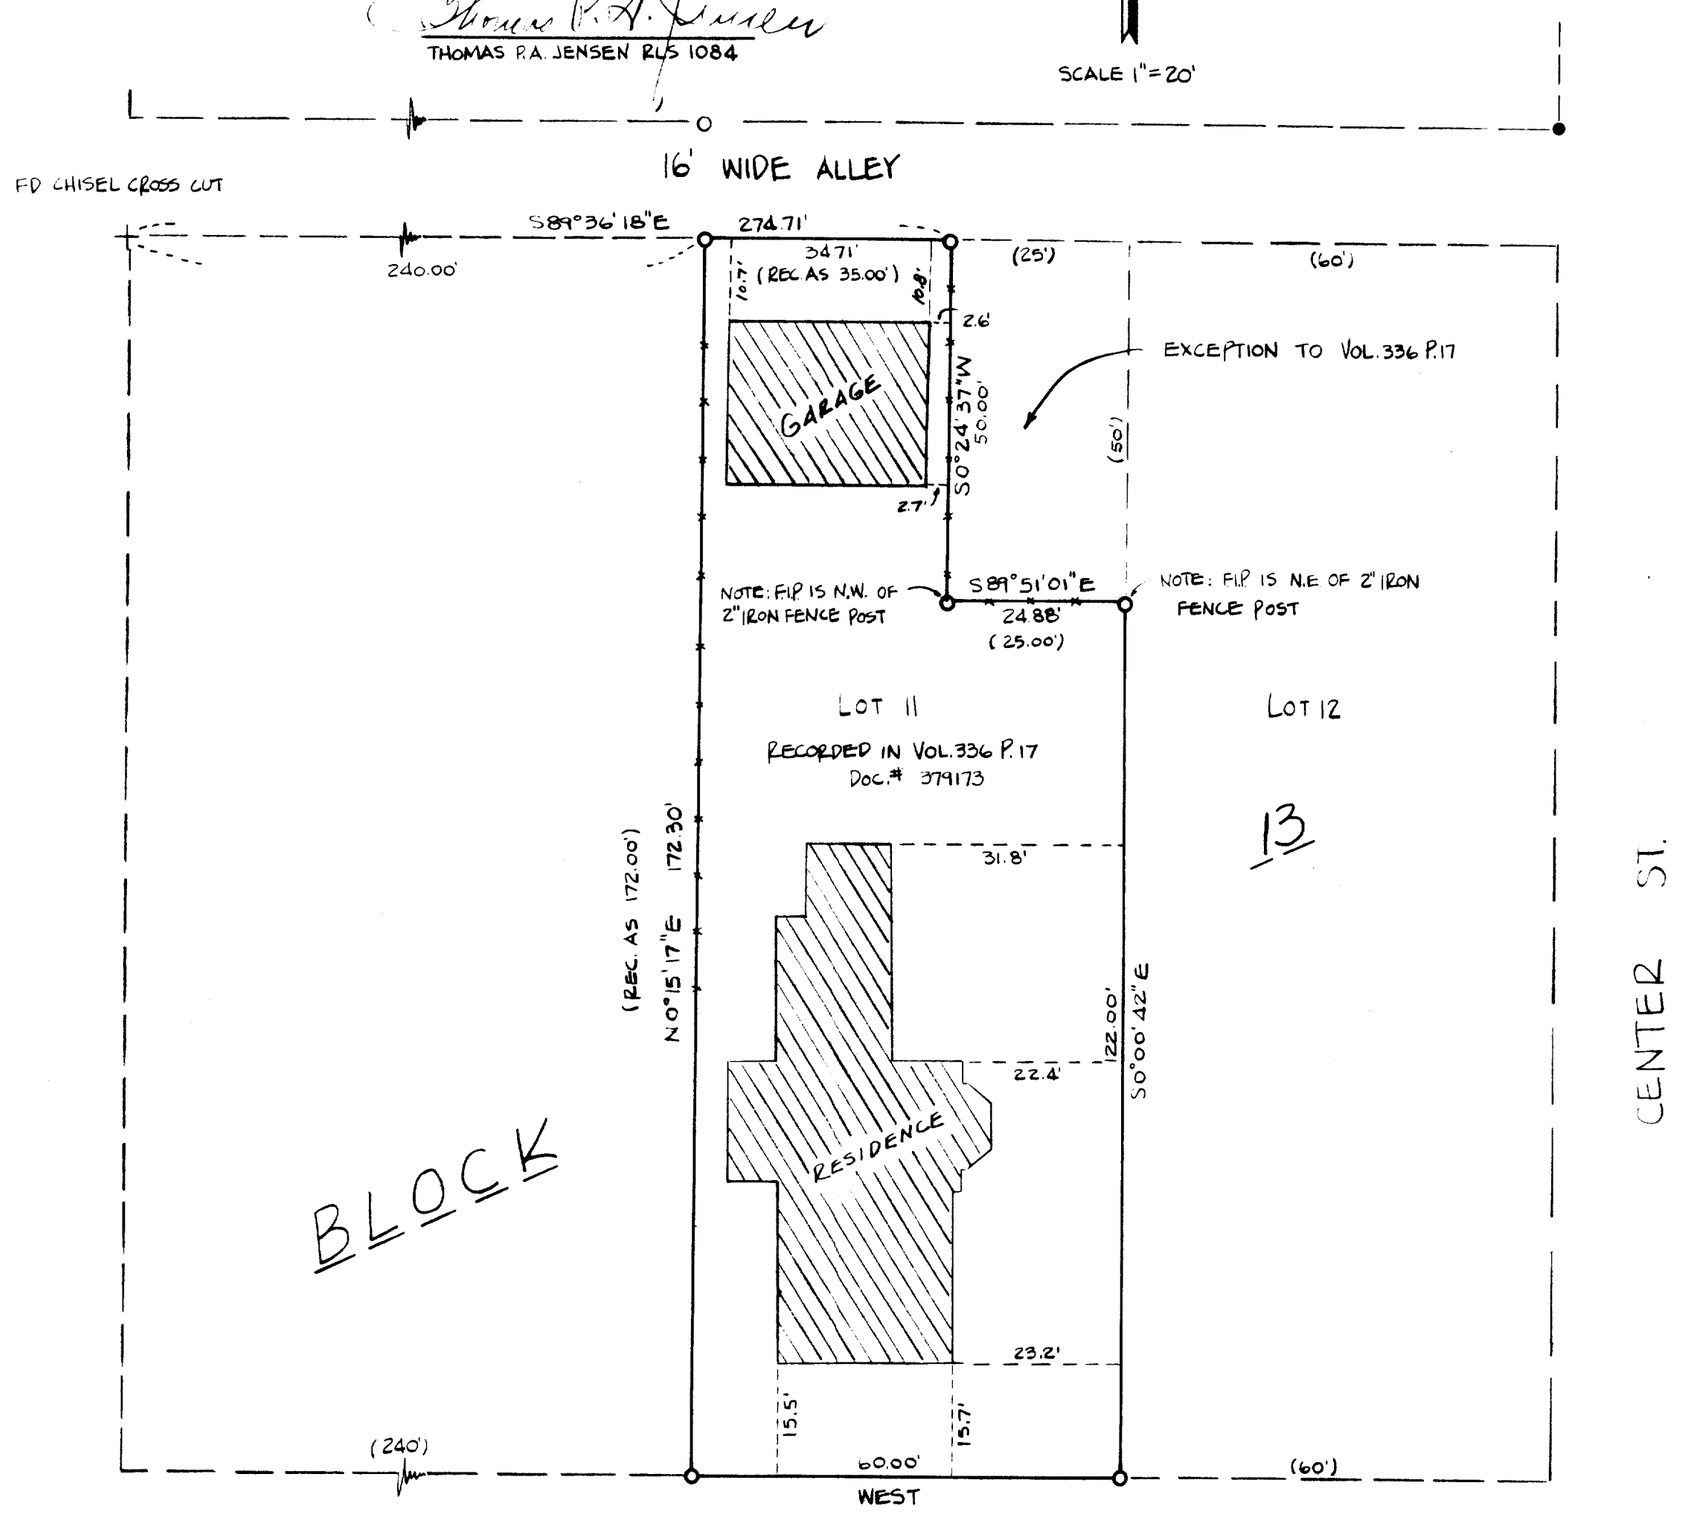

1983.007

OP-119

7-710-J