WALWORTH COUNTY
SURVEYING & MAPPING
LAKE GENEVA, WISCONSIN
414-248-0505

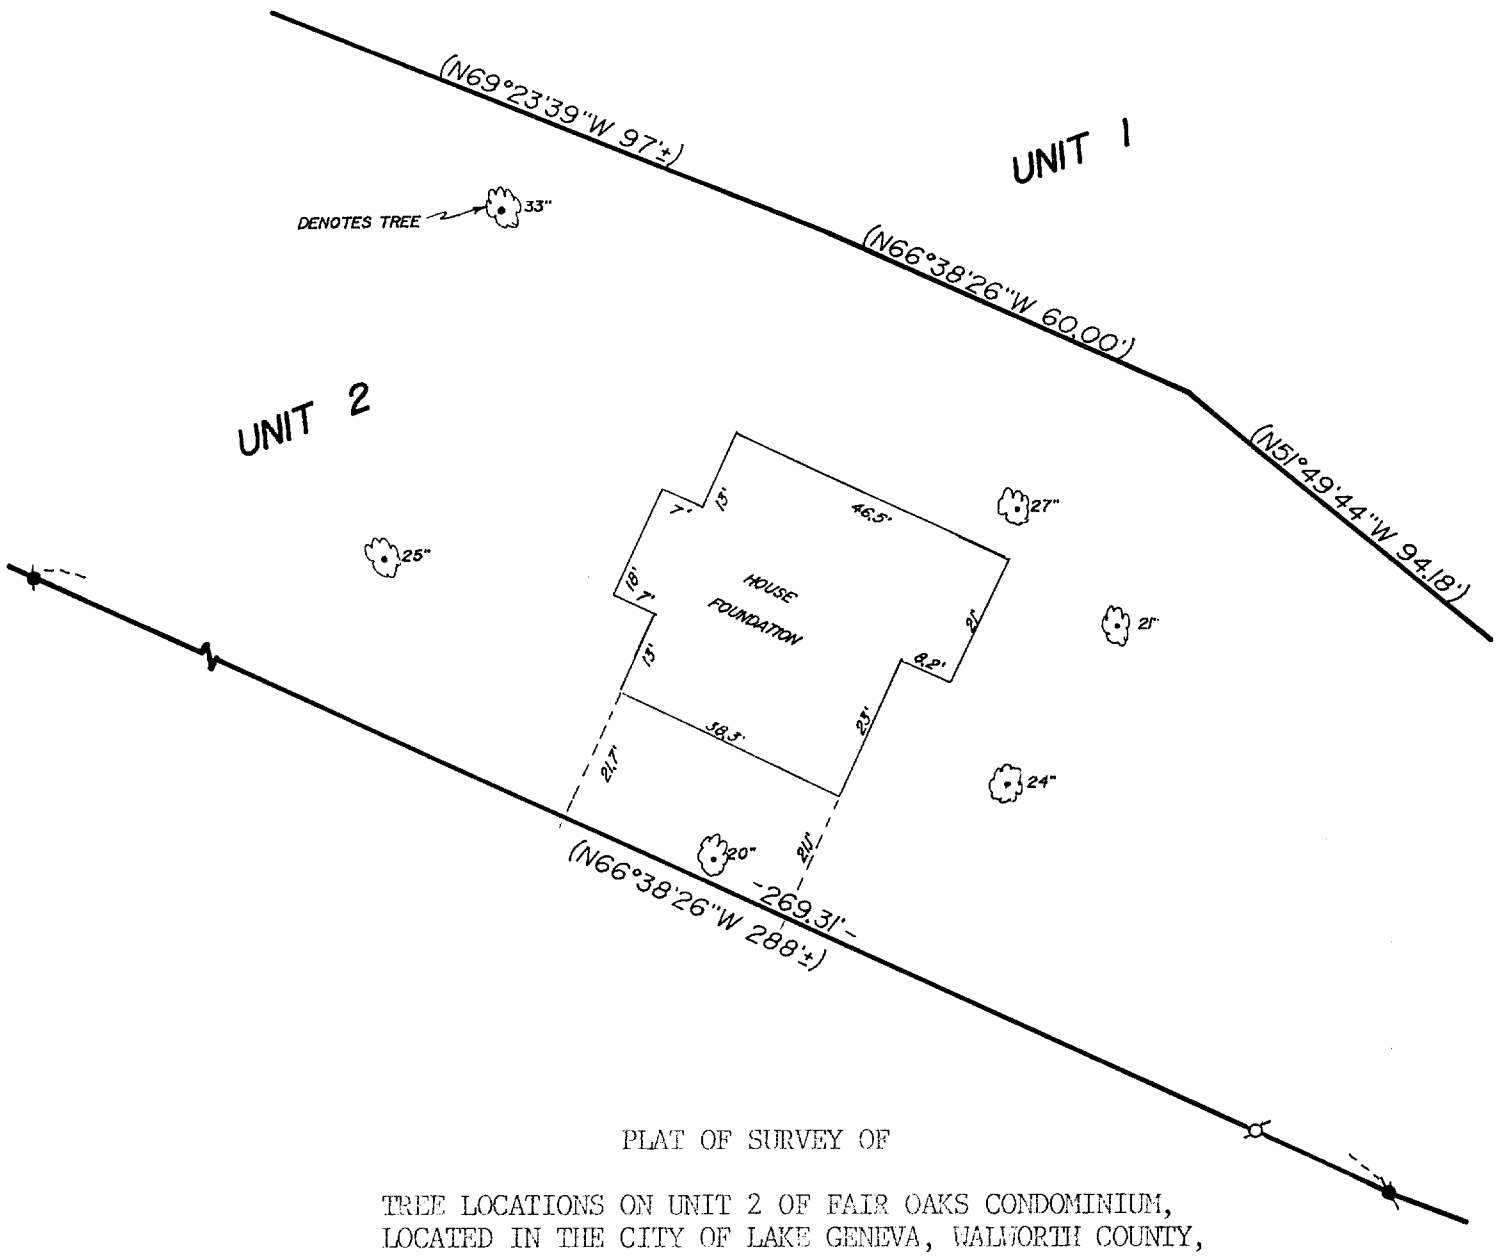

PLAT OF SURVEY OF

TREE LOCATIONS ON UNIT 2 OF FAIR OAKS CONDOMINIUM, LOCATED IN THE CITY OF LAKE GENEVA, WALWORTH COUNTY, WISCONSIN.

ORDERED BY: JAWORT LOWELL
150 NORTH WALWORTH
WILLIAMS BAY, WISCONSIN

REVISED: DEC. 5, 1989 TO SHOW FOUNDATION LOCATION.

RECEIVED
JAN 2 1991
dg

I HEREBY CERTIFY THAT THE TREE LOCATIONS SHOWN HEREON ARE ACCURATE TO THE BEST OF MY KNOWLEDGE AND BELIEF.

N

SCALE IN FEET
0 30 60

ø-IRON PIPE FOUND
●-STONE MONUMENT FOUND
()-RECORDED AS

Robert M. Baerenwald
ROBERT M. BAERENWALD
WISCONSIN REGISTERED LAND SURVEYOR S-1508

Oct. 22, 1989
DATE JOB NO. 2209

NOTE: THIS IS NOT A CERTIFIED COPY UNLESS SEALED

Survey# 007-1215

TAX KEY # ZFA 00002