PLAT OF SURVEY

OF

Lot 4, Ceylon Court Estates,
City of Lake Geneva, Walworth
County, Wisconsin.

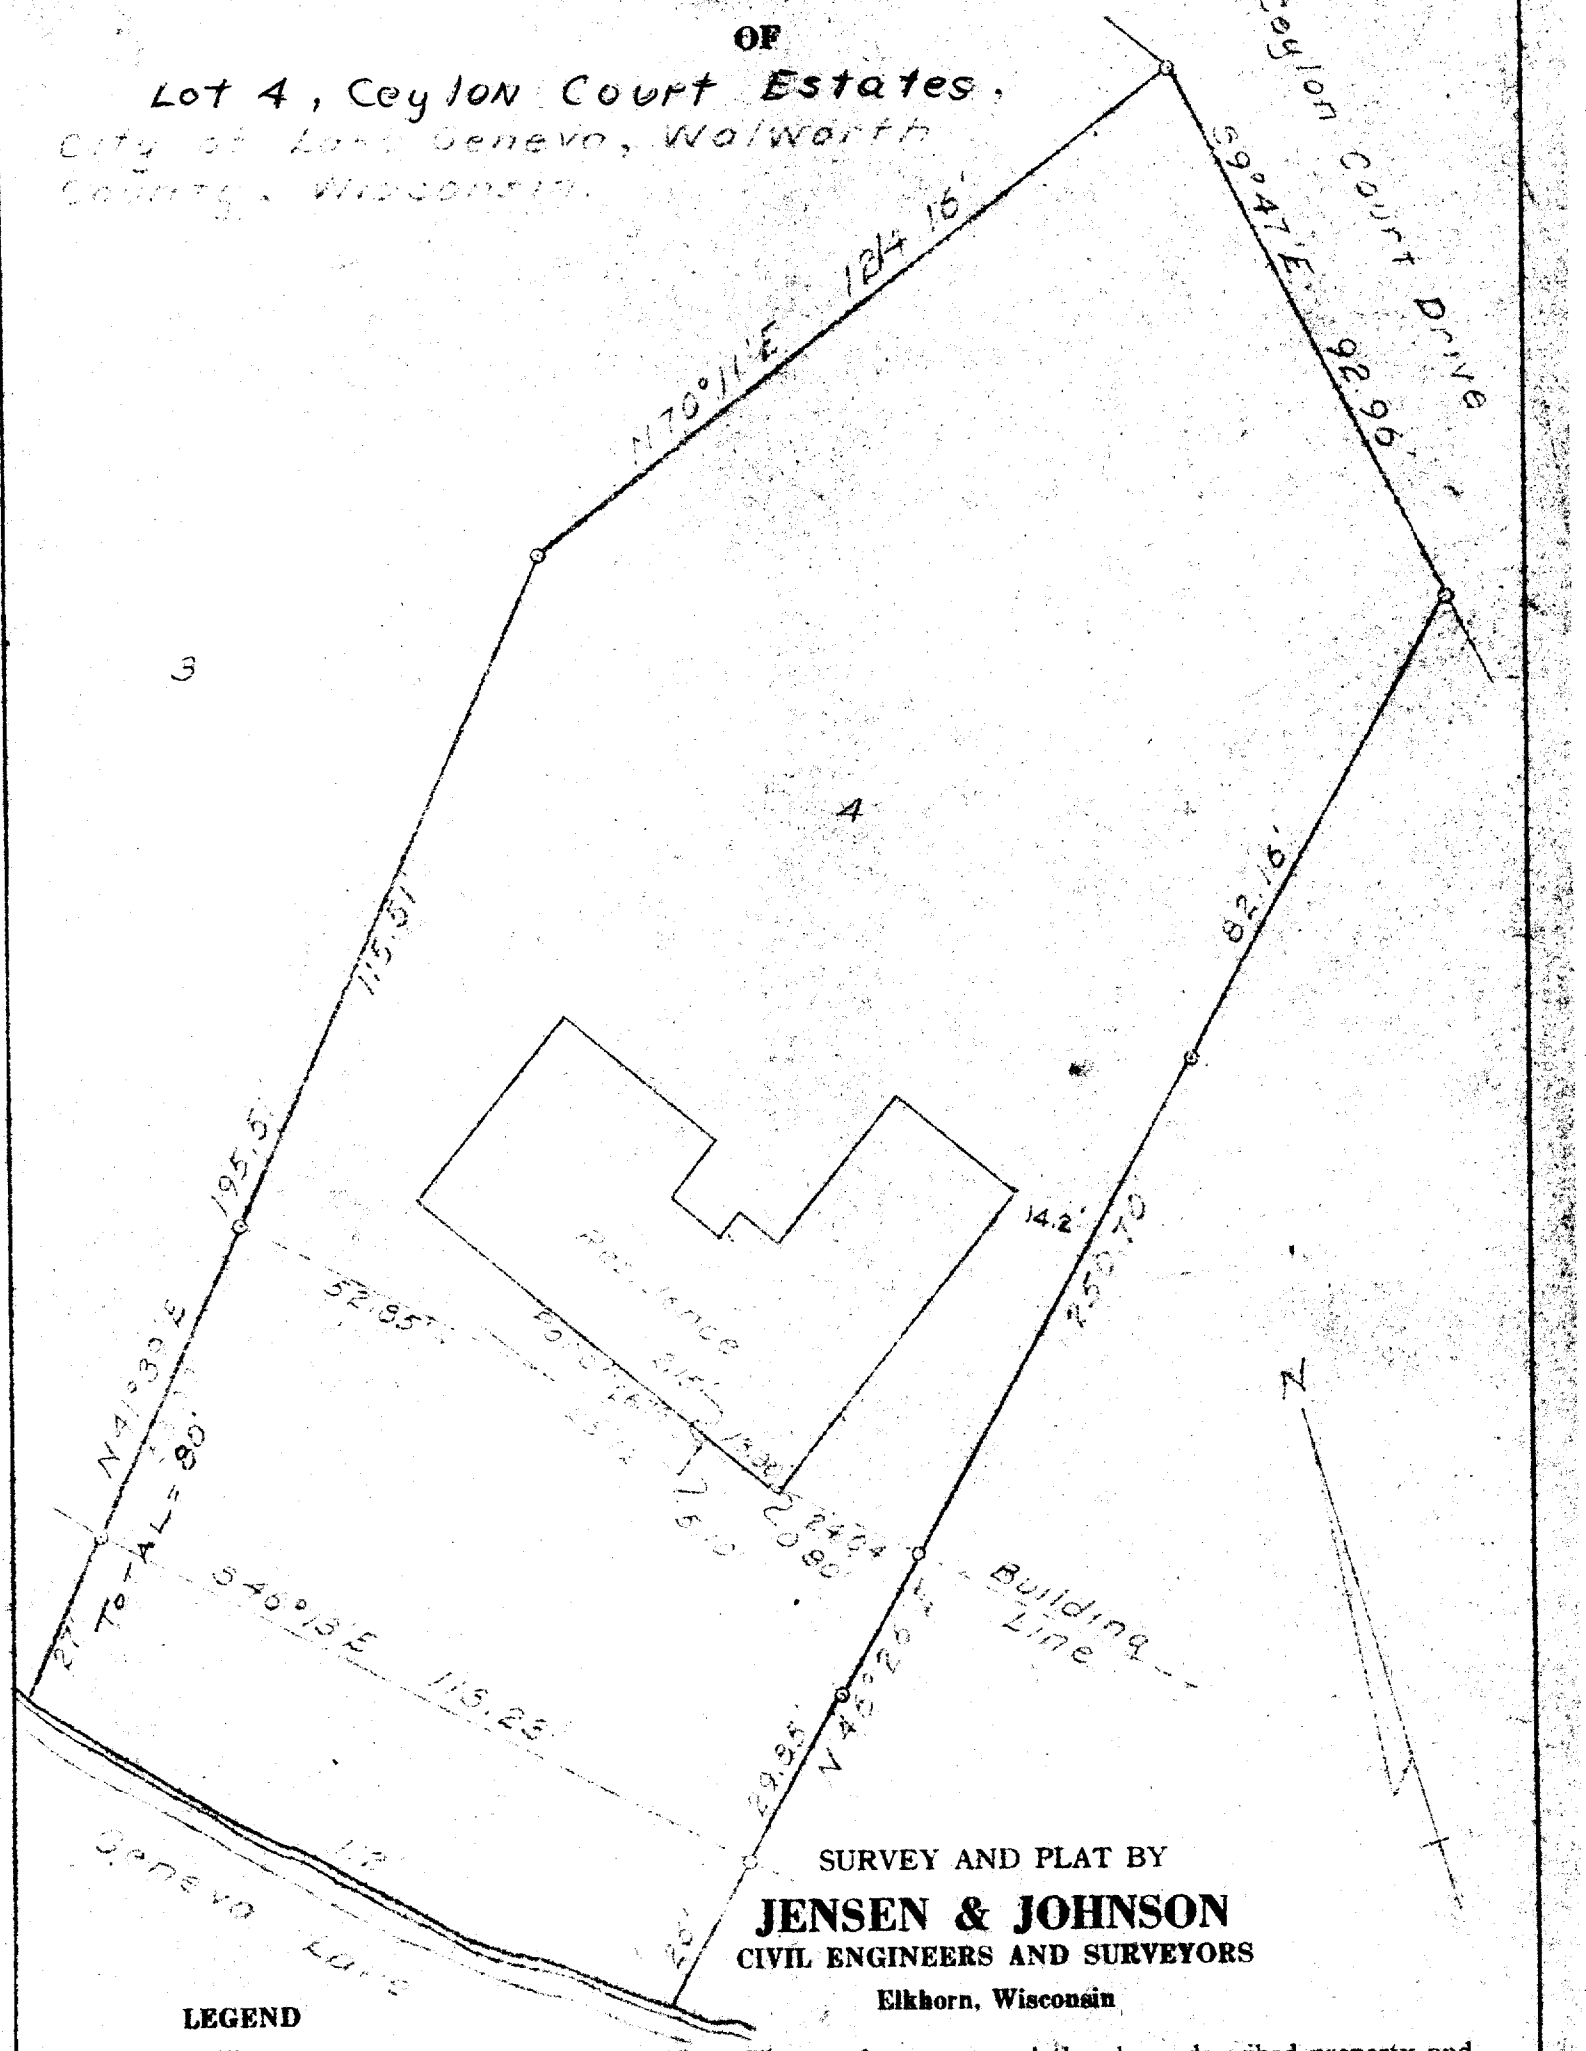

SURVEY AND PLAT BY

JENSEN & JOHNSON

CIVIL ENGINEERS AND SURVEYORS

Elkhorn, Wisconsin

LEGEND

o — Iron Pipe

● — Concrete Monument

Scale 1" = 30'

WE CERTIFY: That we have surveyed the above described property and that the plat shown hereon is an accurate survey and a true representation thereof and correctly shows the exterior boundary lines and all divisions of said property.

Date May 1959

Lloyd J. Jensen

LLOYD J. JENSEN, Partner

Wisconsin Registered Land Surveyor, No. S-211

VP-141A

7-73 J 7-73

NO. 175H—400—1-30-68