

## PLAT

## OF

JAMES E. CROTTY  
Registered Land Surveyor


## SURVEY

6325 S. KNOX AV, CHICAGO

JULY 1871

A piece or parcel of land situate in the East  $\frac{1}{2}$  of Section 36, Township 2 North, Range 17 East, Lake Geneva, Walworth County, Wisconsin, being all of Block 33 of the original Village of Geneva, together with unplat'd land lying adjacent thereto on the North and West, bounded as follows, to wit:

Commencing at the Southeast corner of Block 33 in the Village (now City) of Geneva (now Lake Geneva) in the County of Walworth, Wisconsin, according to the map hereof or record in the Office of the Register of Deeds in and for said County, being the intersection of the centerline of Cass and Willow Streets; running thence west in the center of Cass Street in said Village (now City) 393 feet to an iron pin set in the West end thereof at the East line of Lake Geneva Seminary lands, as now enclosed and occupied; thence north 33 feet to the North line of said street, thence west in the North line of the Lake Geneva Seminary lands 442.6 feet to an iron pin set in the center of the highway extending south from the Southern end of Center Street in said Village (now City); thence northwesterly in the center of said highway 447 feet to the center of the N.W. Race, as the same was constructed and used on the 12th day of February, A.D. 1884; thence northeasterly along center of said Race as used on the date above said to a point where the West end of a piece of land conveyed by R. W. Warren and wife to Allen H. Moore by deed dated November 10th, A.D. 1875, recorded in Vol. 59, page 123, of the records of said Register's Office, extended south would intersect the center of said Race; thence north in the line so extended 27 feet to the North bank of said Race as constructed on the aforesaid date; thence northeasterly along the North bank of said Race 118 feet, more or less, to the South line of Main Street in said Village (now City); thence north 50 feet to the center of said street; thence east in the center of said street 20.2 feet to a point where the center line of Willow Street extended northwesterly intersects the center line of Main Street aforesaid; thence southeasterly in the center line of Willow Street, 492.1 feet, to an iron pin; thence south, still in the center of Willow Street, 307.5 feet to the place of beginning.

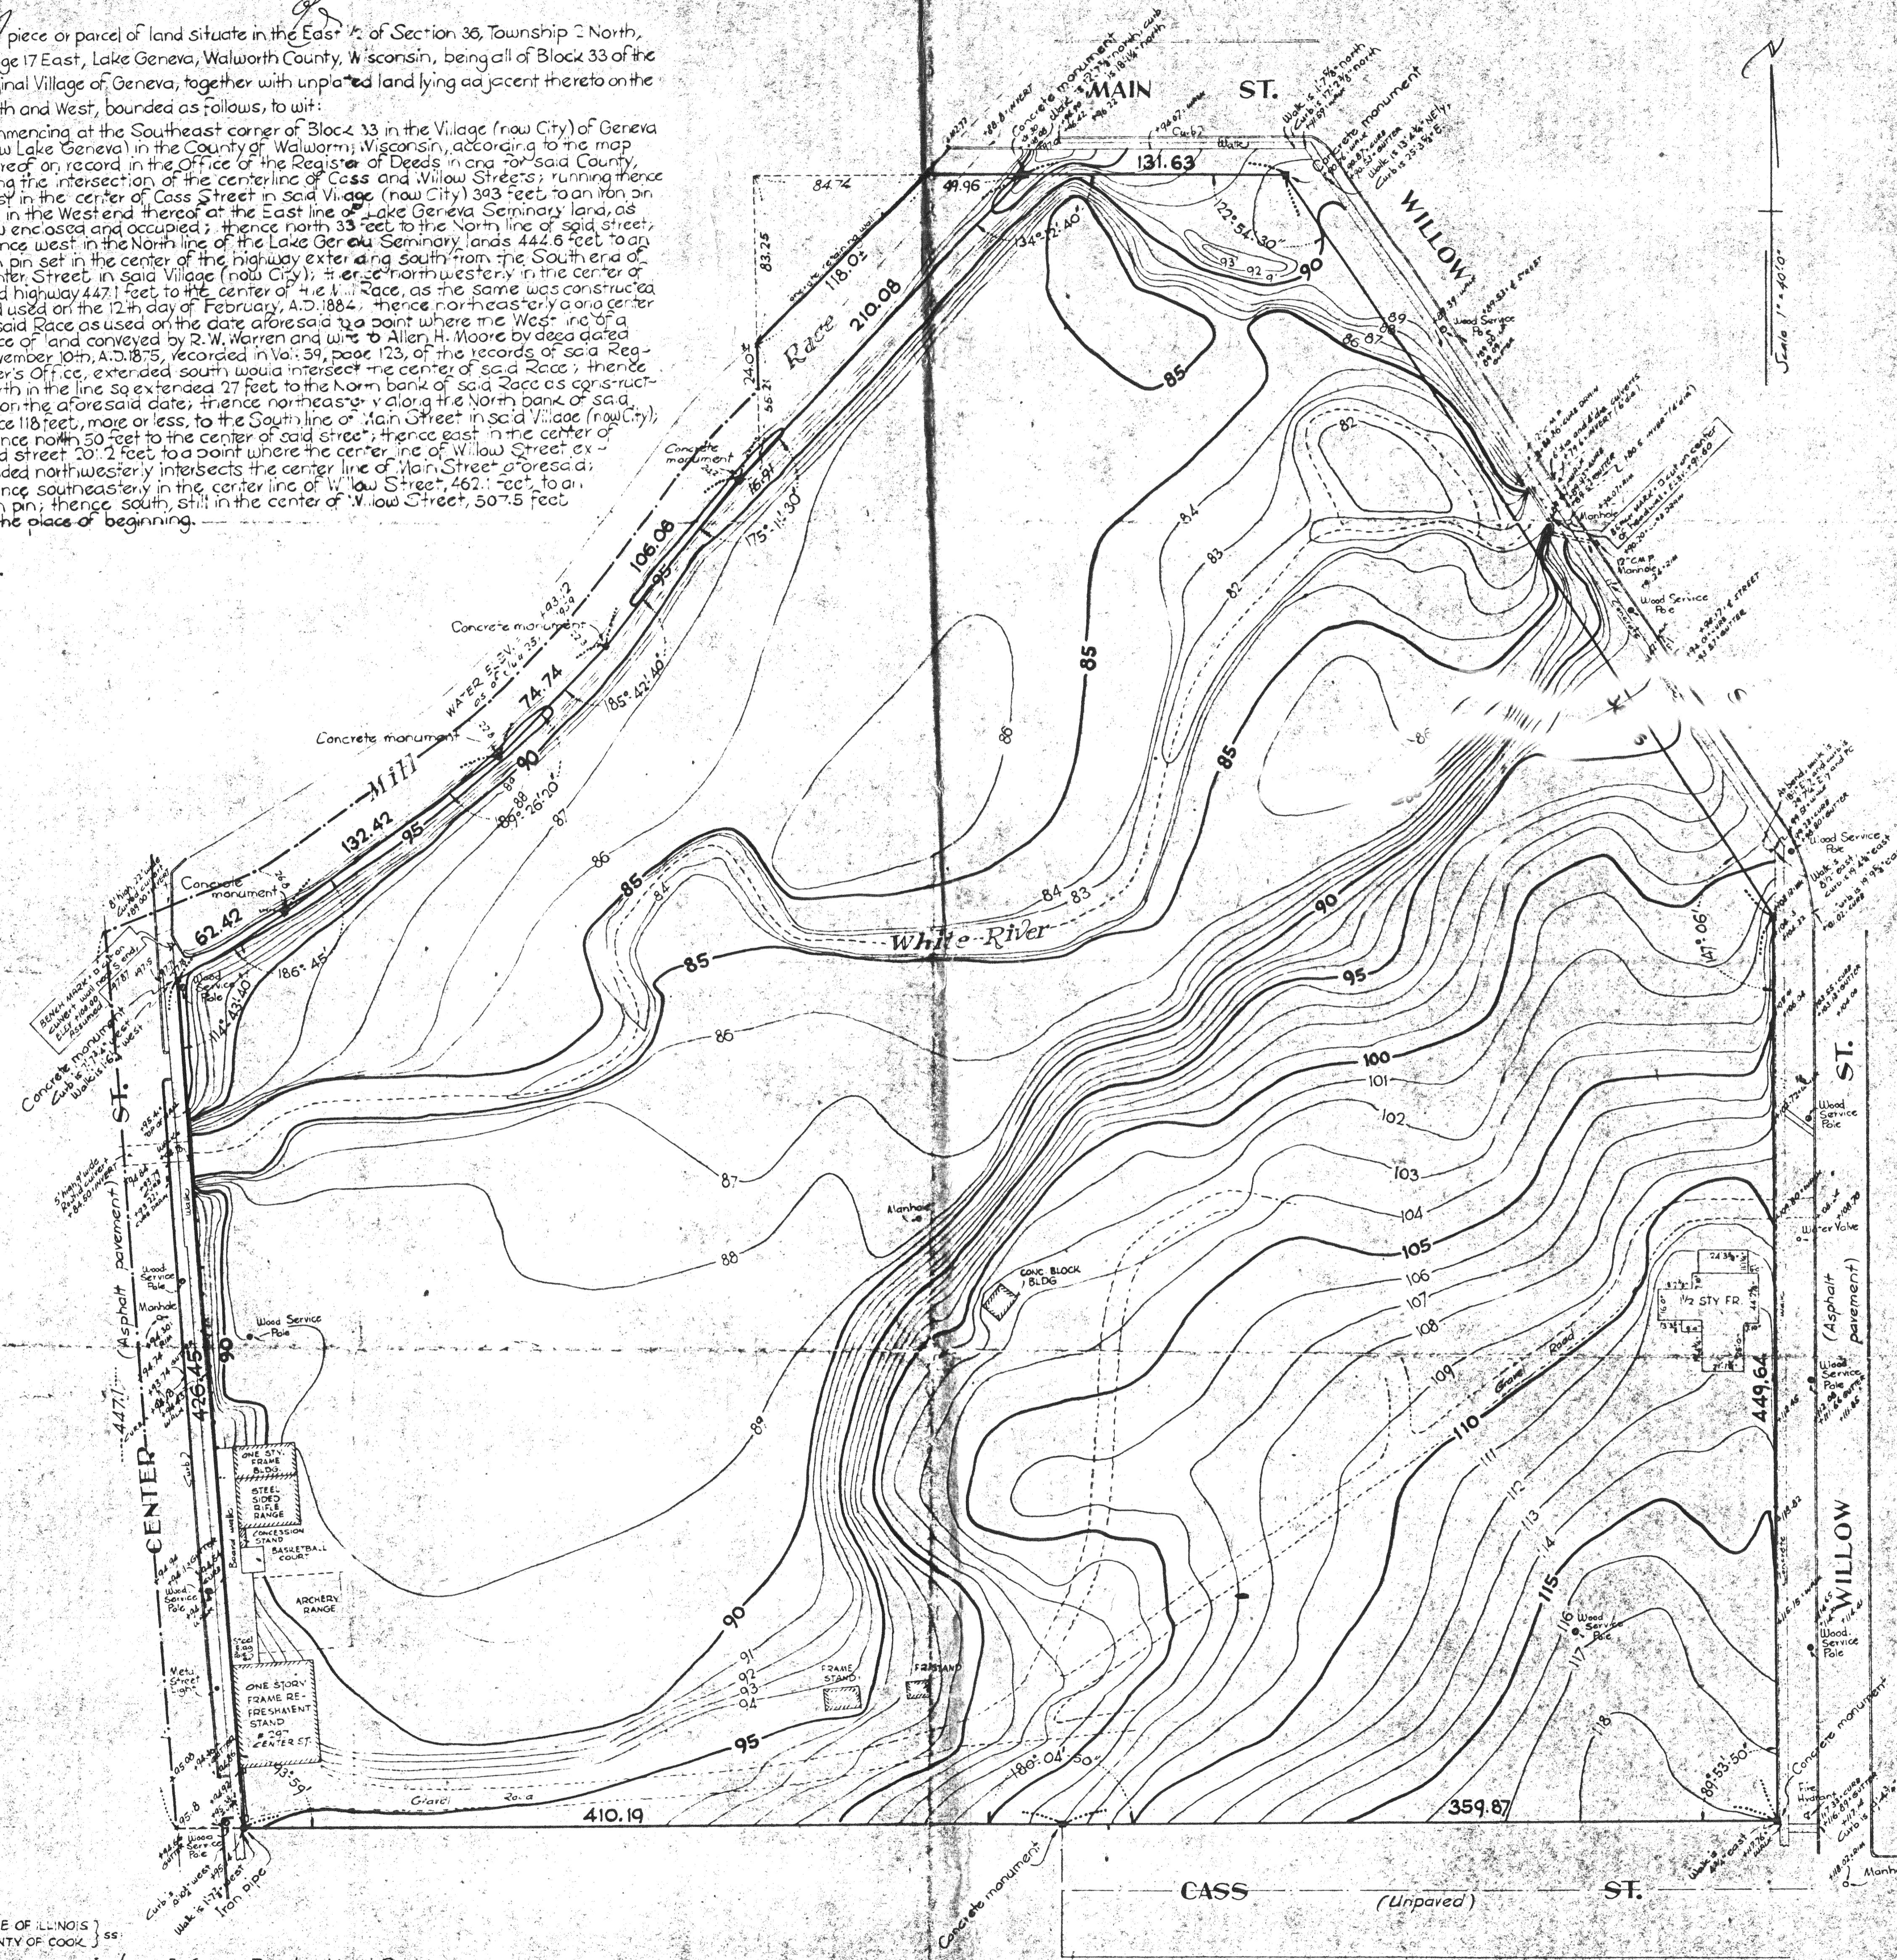

STATE OF ILLINOIS }  
COUNTY OF COOK }

JAMES E. CROTTY, Registered Land Surveyor,  
do hereby certify that I have surveyed the above described  
property and that the plat hereon drawn is a correct repre-  
sentation of said survey.

CHICAGO, ILLINOIS, July 31<sup>st</sup>, A.D. 1950.

James E. Crotty  
Wisconsin Registered Land Surveyor #155642

Compare all points before building by same  
and at once report any difference.

ORDER NO 59,200  
ZOP-349

1066

ZOP-349

007-1421