HAROLD H. KOLB

REGISTERED PROFESSIONAL LAND SURVEYOR
LAKE GENEVA, WISCONSIN

ORDERED BY: JUDY & BOB JUREWICZ
W 2383 TOWN LINE RD.
LAKE GENEVA, WI.53147

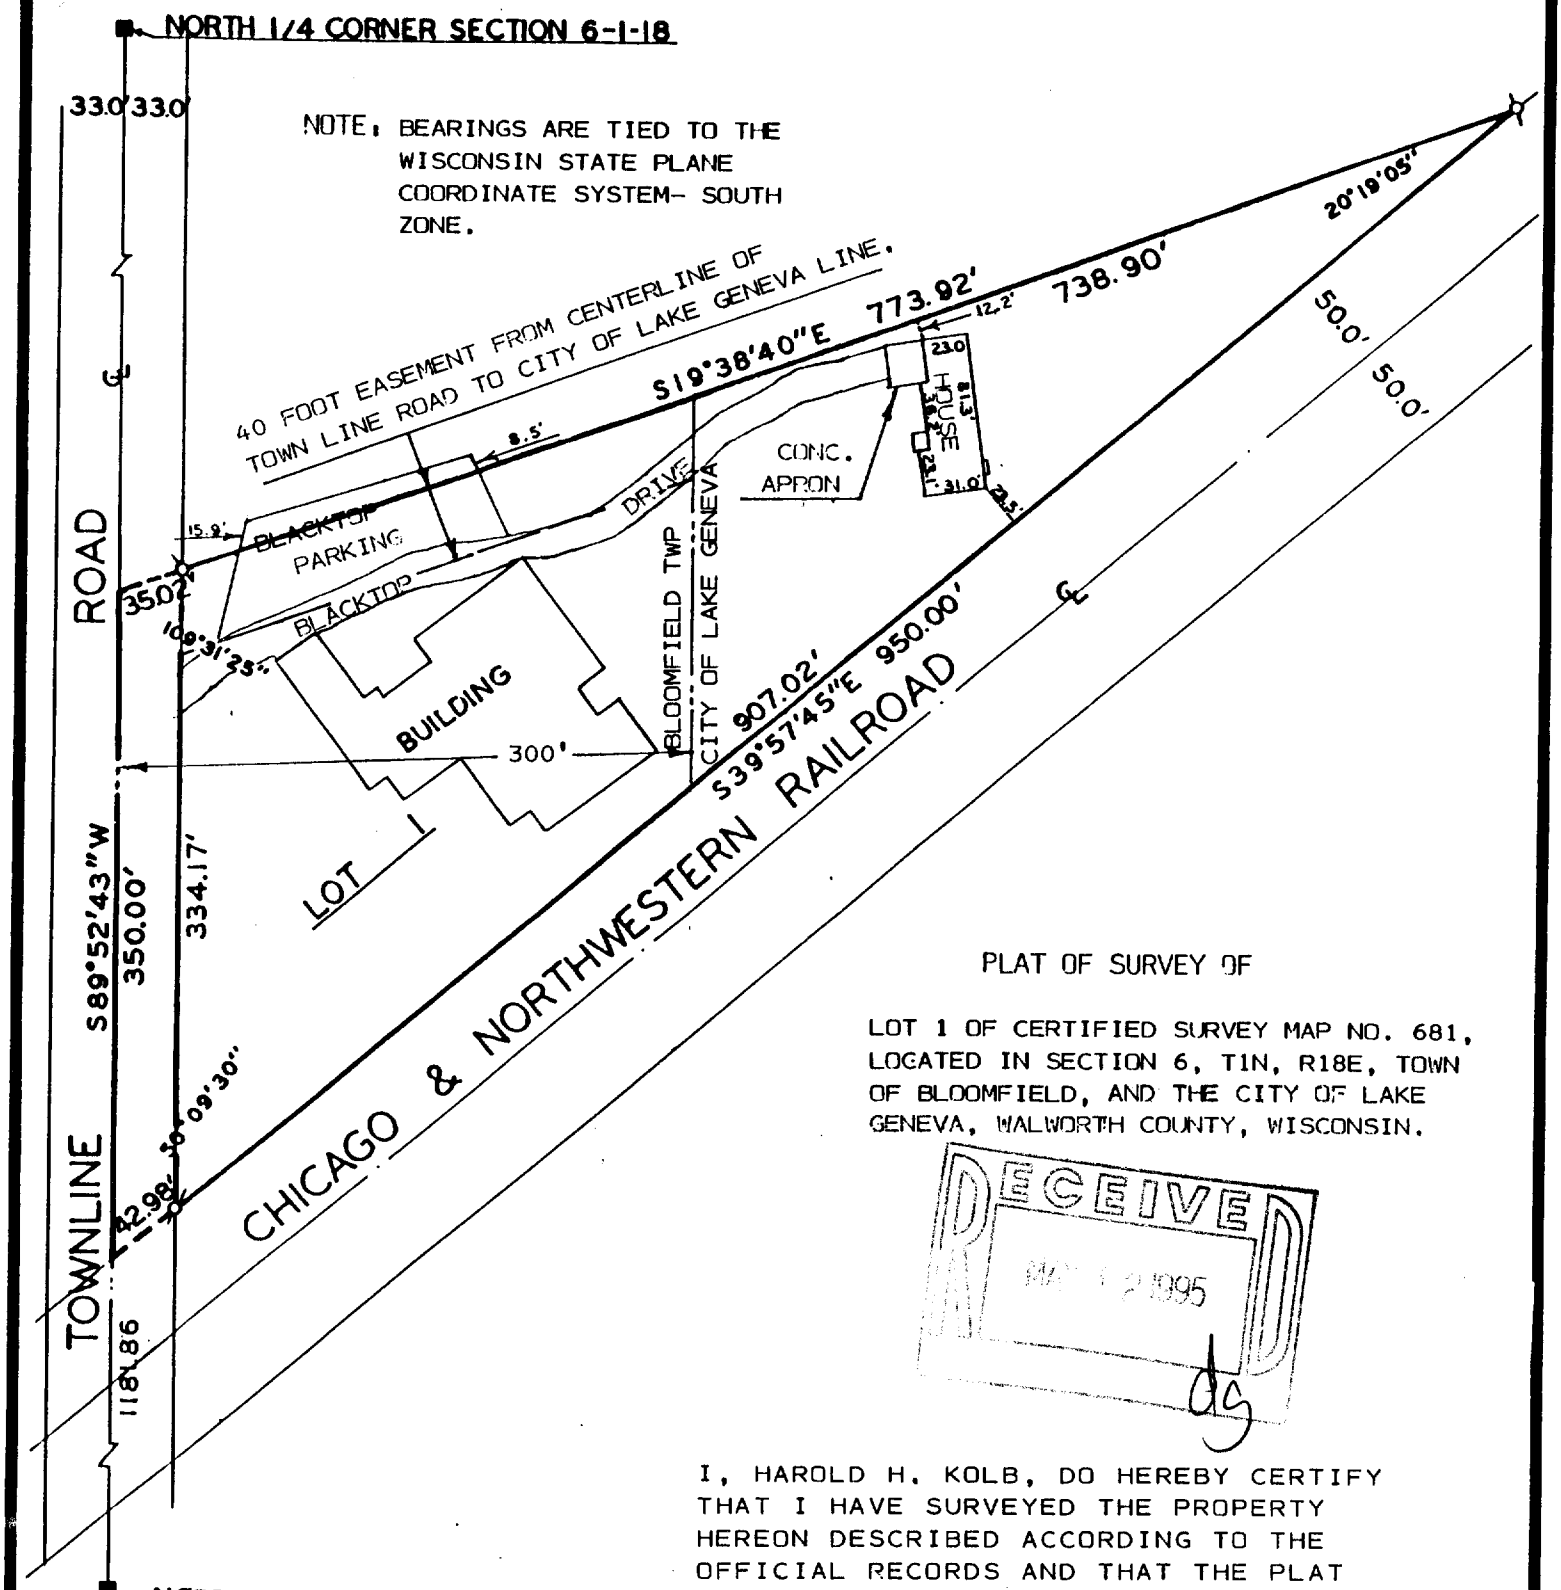

PLAT OF SURVEY OF

LOT 1 OF CERTIFIED SURVEY MAP NO. 681, LOCATED IN SECTION 6, T1N, R18E, TOWN OF BLOOMFIELD, AND THE CITY OF LAKE GENEVA, WALWORTH COUNTY, WISCONSIN.

RECEIVED
MAR 2 1995
ds

I, HAROLD H. KOLB, DO HEREBY CERTIFY THAT I HAVE SURVEYED THE PROPERTY HEREON DESCRIBED ACCORDING TO THE OFFICIAL RECORDS AND THAT THE PLAT HEREON IS A CORRECT REPRESENTATION OF THE LOT LINES TO THE BEST OF MY KNOWLEDGE AND BELIEF.
SURVEY NOT VALID UNLESS SURVEYOR'S SIGNATURE IS IN RED.

HAROLD H. KOLB
WISCONSIN REGISTERED LAND SURVEYOR, S-187
DATE AUGUST 24, 1994

LEGEND

- O — IRON PIPE PLACED, 1" x 24" 1.13 LB./LIN. FT.
- ● — CONCRETE MONUMENT, 5" DIA. x 30"
- ■ — 6" SQ. TOP X 9" SQ. BOTTOM X 38" CONC. MON.
- ø — IRON PIPE FOUND

007-1583

BRUNING 40-105 1M-6-71

ZA-681-1 / MA-681-1

1/8-383