50-15

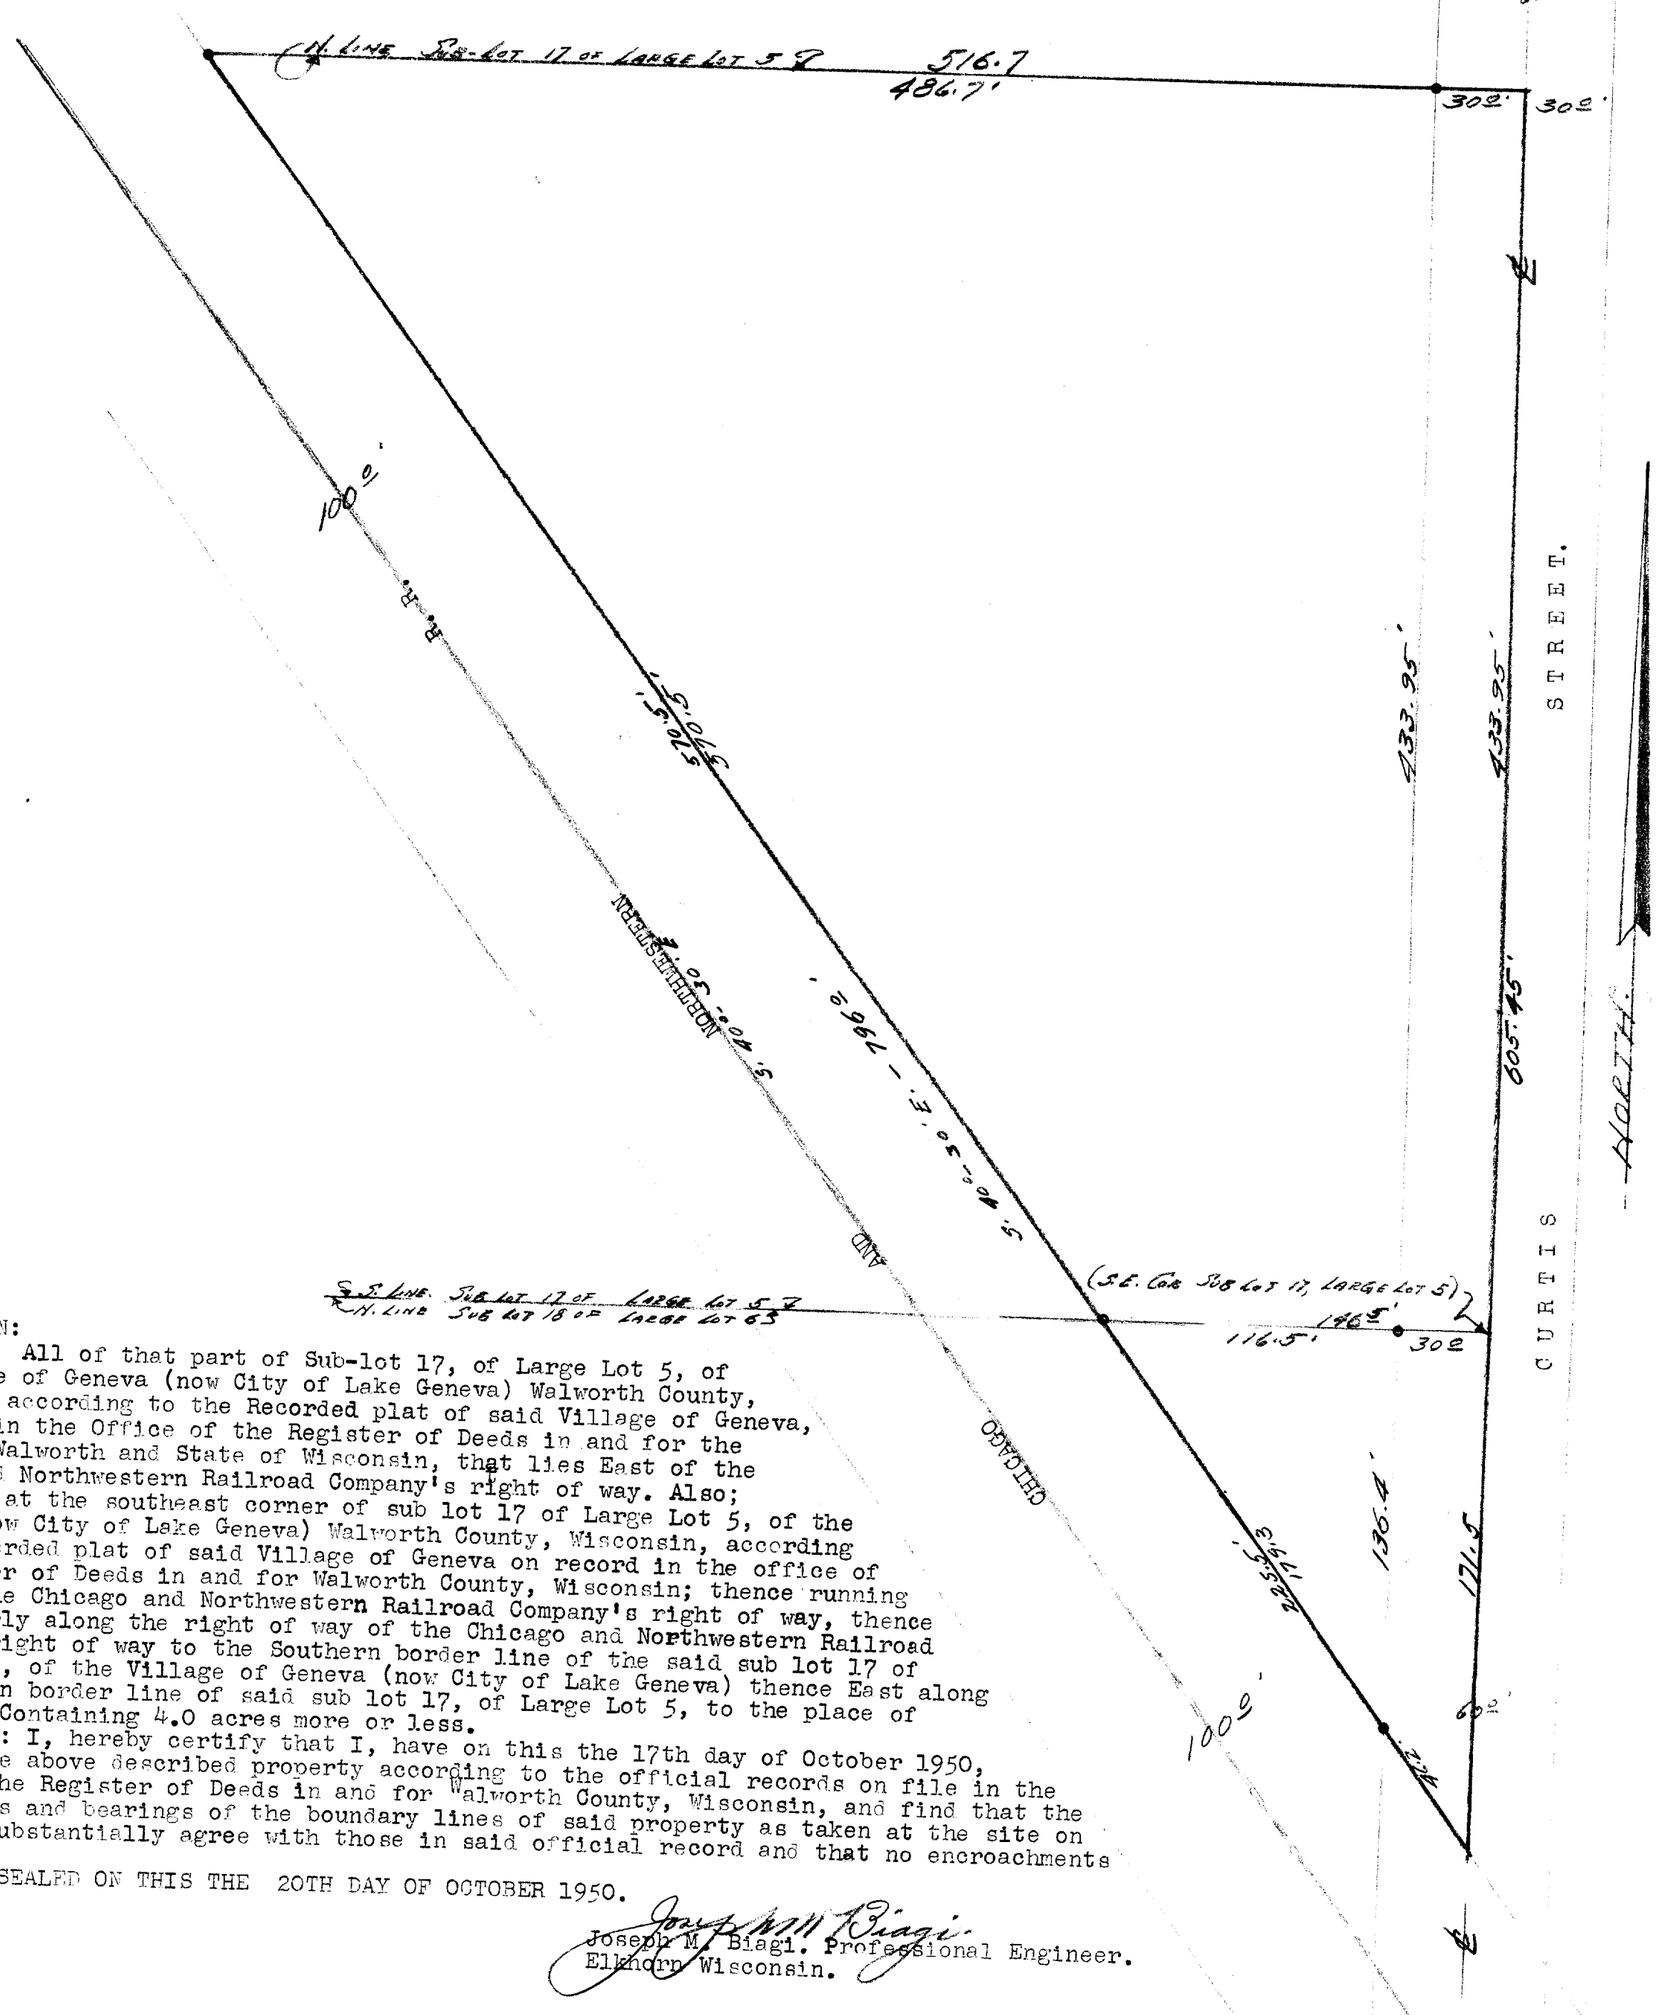

DESCRIPTION:

All of that part of Sub-lot 17, of Large Lot 5, of the Village of Geneva (now City of Lake Geneva) Walworth County, Wisconsin, according to the Recorded plat of said Village of Geneva, of Record in the Office of the Register of Deeds in and for the County of Walworth and State of Wisconsin, that lies East of the Chicago and Northwestern Railroad Company's right of way. Also; commencing at the southeast corner of sub lot 17 of Large Lot 5, of the Village (now City of Lake Geneva) Walworth County, Wisconsin, according to the recorded plat of said Village of Geneva on record in the office of the Register of Deeds in and for Walworth County, Wisconsin; thence running South to the Chicago and Northwestern Railroad Company's right of way, thence Northwesterly along the right of way of the Chicago and Northwestern Railroad Company's right of way to the Southern border line of the said sub lot 17 of Large Lot 5, of the Village of Geneva (now City of Lake Geneva) thence East along the Southern border line of said sub lot 17, of Large Lot 5, to the place of beginning. Containing 4.0 acres more or less.

CERTIFICATE: I, hereby certify that I, have on this the 17th day of October 1950, surveyed the above described property according to the official records on file in the office of the Register of Deeds in and for Walworth County, Wisconsin, and find that the measurements and bearings of the boundary lines of said property as taken at the site on this day, substantially agree with those in said official record and that no encroachments exist.

SIGNED AND SEALED ON THIS THE 20TH DAY OF OCTOBER 1950.

Joseph M. Biagi.
Joseph M. Biagi. Professional Engineer.
Elkhorn Wisconsin.

< 5 120 120

OP-394 (Oct 1950)

7-158B