ABERNATHY and ASSOCIATES
Kenneth B. Abernathy Jr.
Wisconsin Registered Land Surveyor S-1594
W4056 BRAY RD.
ELKHORN, WI. 53121
PHONE: (262) 723-4260 (OFFICE)
(262) 723-7209 (FAX)
Email: abernathy@elknet.net

PLAT OF SURVEY

Lot 19 and the South 5 feet of Lot 14 of Barabara Jean Estates Subdivision, located in the NE 1/4 of Section 1 T.1N., R.17 E. City of Lake Geneva, Walworth County, Wisconsin.

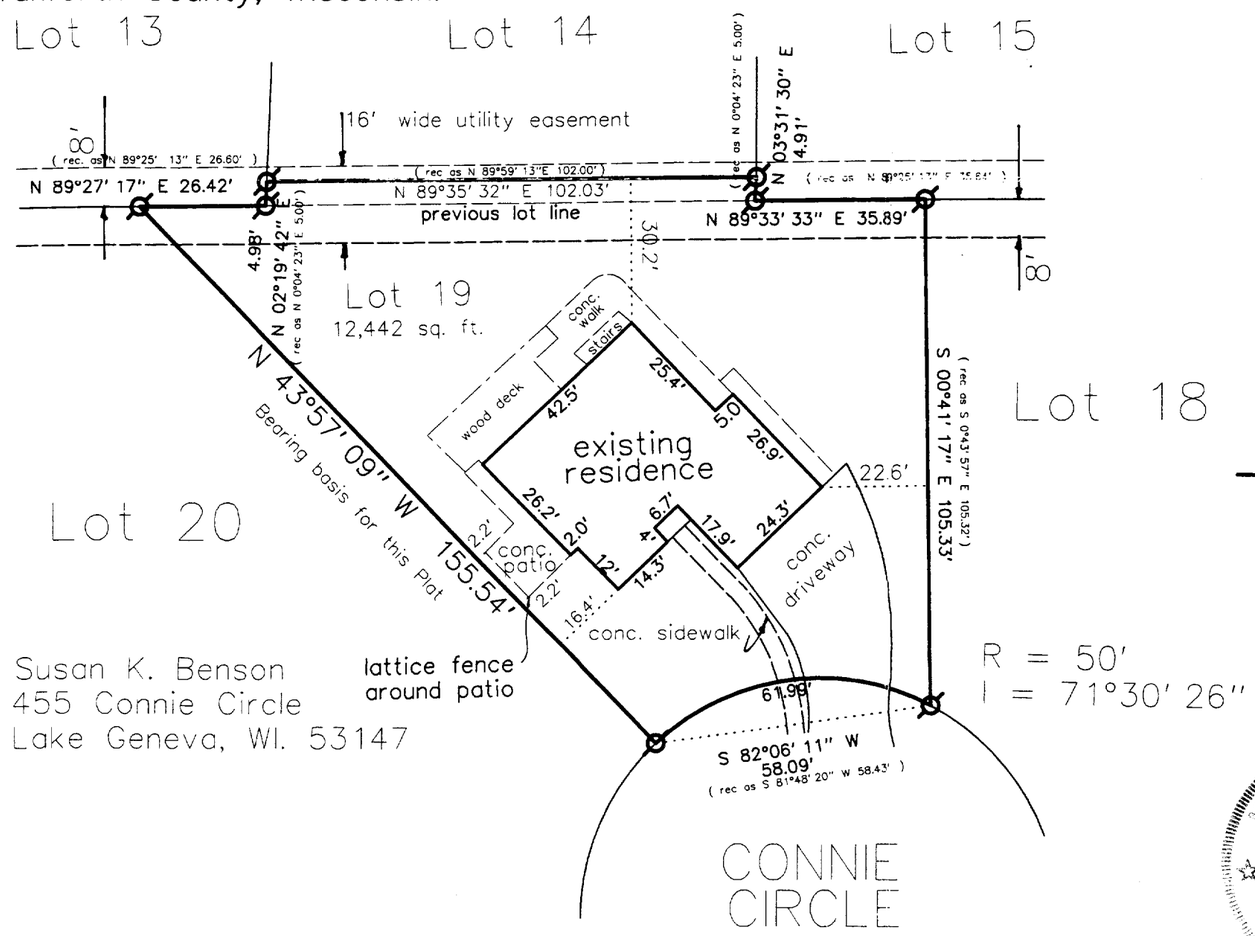

Owner: Susan K. Benson
455 Connie Circle
Lake Geneva, WI. 53147

Legend

⌀	FOUND IRON PIPE
●	FOUND IRON ROD
⊠	FOUND BRASS CAPPED MONUMENT
○	FOUND CONCRETE MONUMENT
+	CHISEL CUT IN CONCRETE
●	SET IRON ROD, 24" LONG, WEIGHING 1.5 LBS./LINEAL FT., 3/4" DIA.
●	SET IRON ROD, 30" LONG, WEIGHING 4.5 LBS./LINEAL FT., 1-11/16" DIA.
(x x)	RECORDED AS DIMENSION
—x—x—	EXISTING FENCE

RECEIVED APR 24 2002

SCALE: 1" = 50 FEET

WISCONSIN KENNETH B. ABERNATHY, JR. S-1594 ELKHORN WI LAND SURVEYOR

"I hereby certify that the above described property has been surveyed by me or under my direction and that the above map is a true representation thereof and shows the size and location of the property, its exterior boundaries, the location of all visible structures and dimensions of all principal buildings thereon, boundary fences, apparent easements, roadways and visible encroachments, if any."

"This survey is made for the use of the present owners of the property, and also those who purchase, mortgage, or guarantee the title thereto within one year from the date hereof."

KENNETH B. ABERNATHY, JR.
WISCONSIN REGISTERED LAND SURVEYOR, S-1594

Date: 3/27/02 Job No. 02.308

ZJ-19

007-2009