


PLAT *OF* *SURVEY*
 OF

FAX: 262-537-4221

PARCEL IDENTIFICATION NO.: ZSY 00029

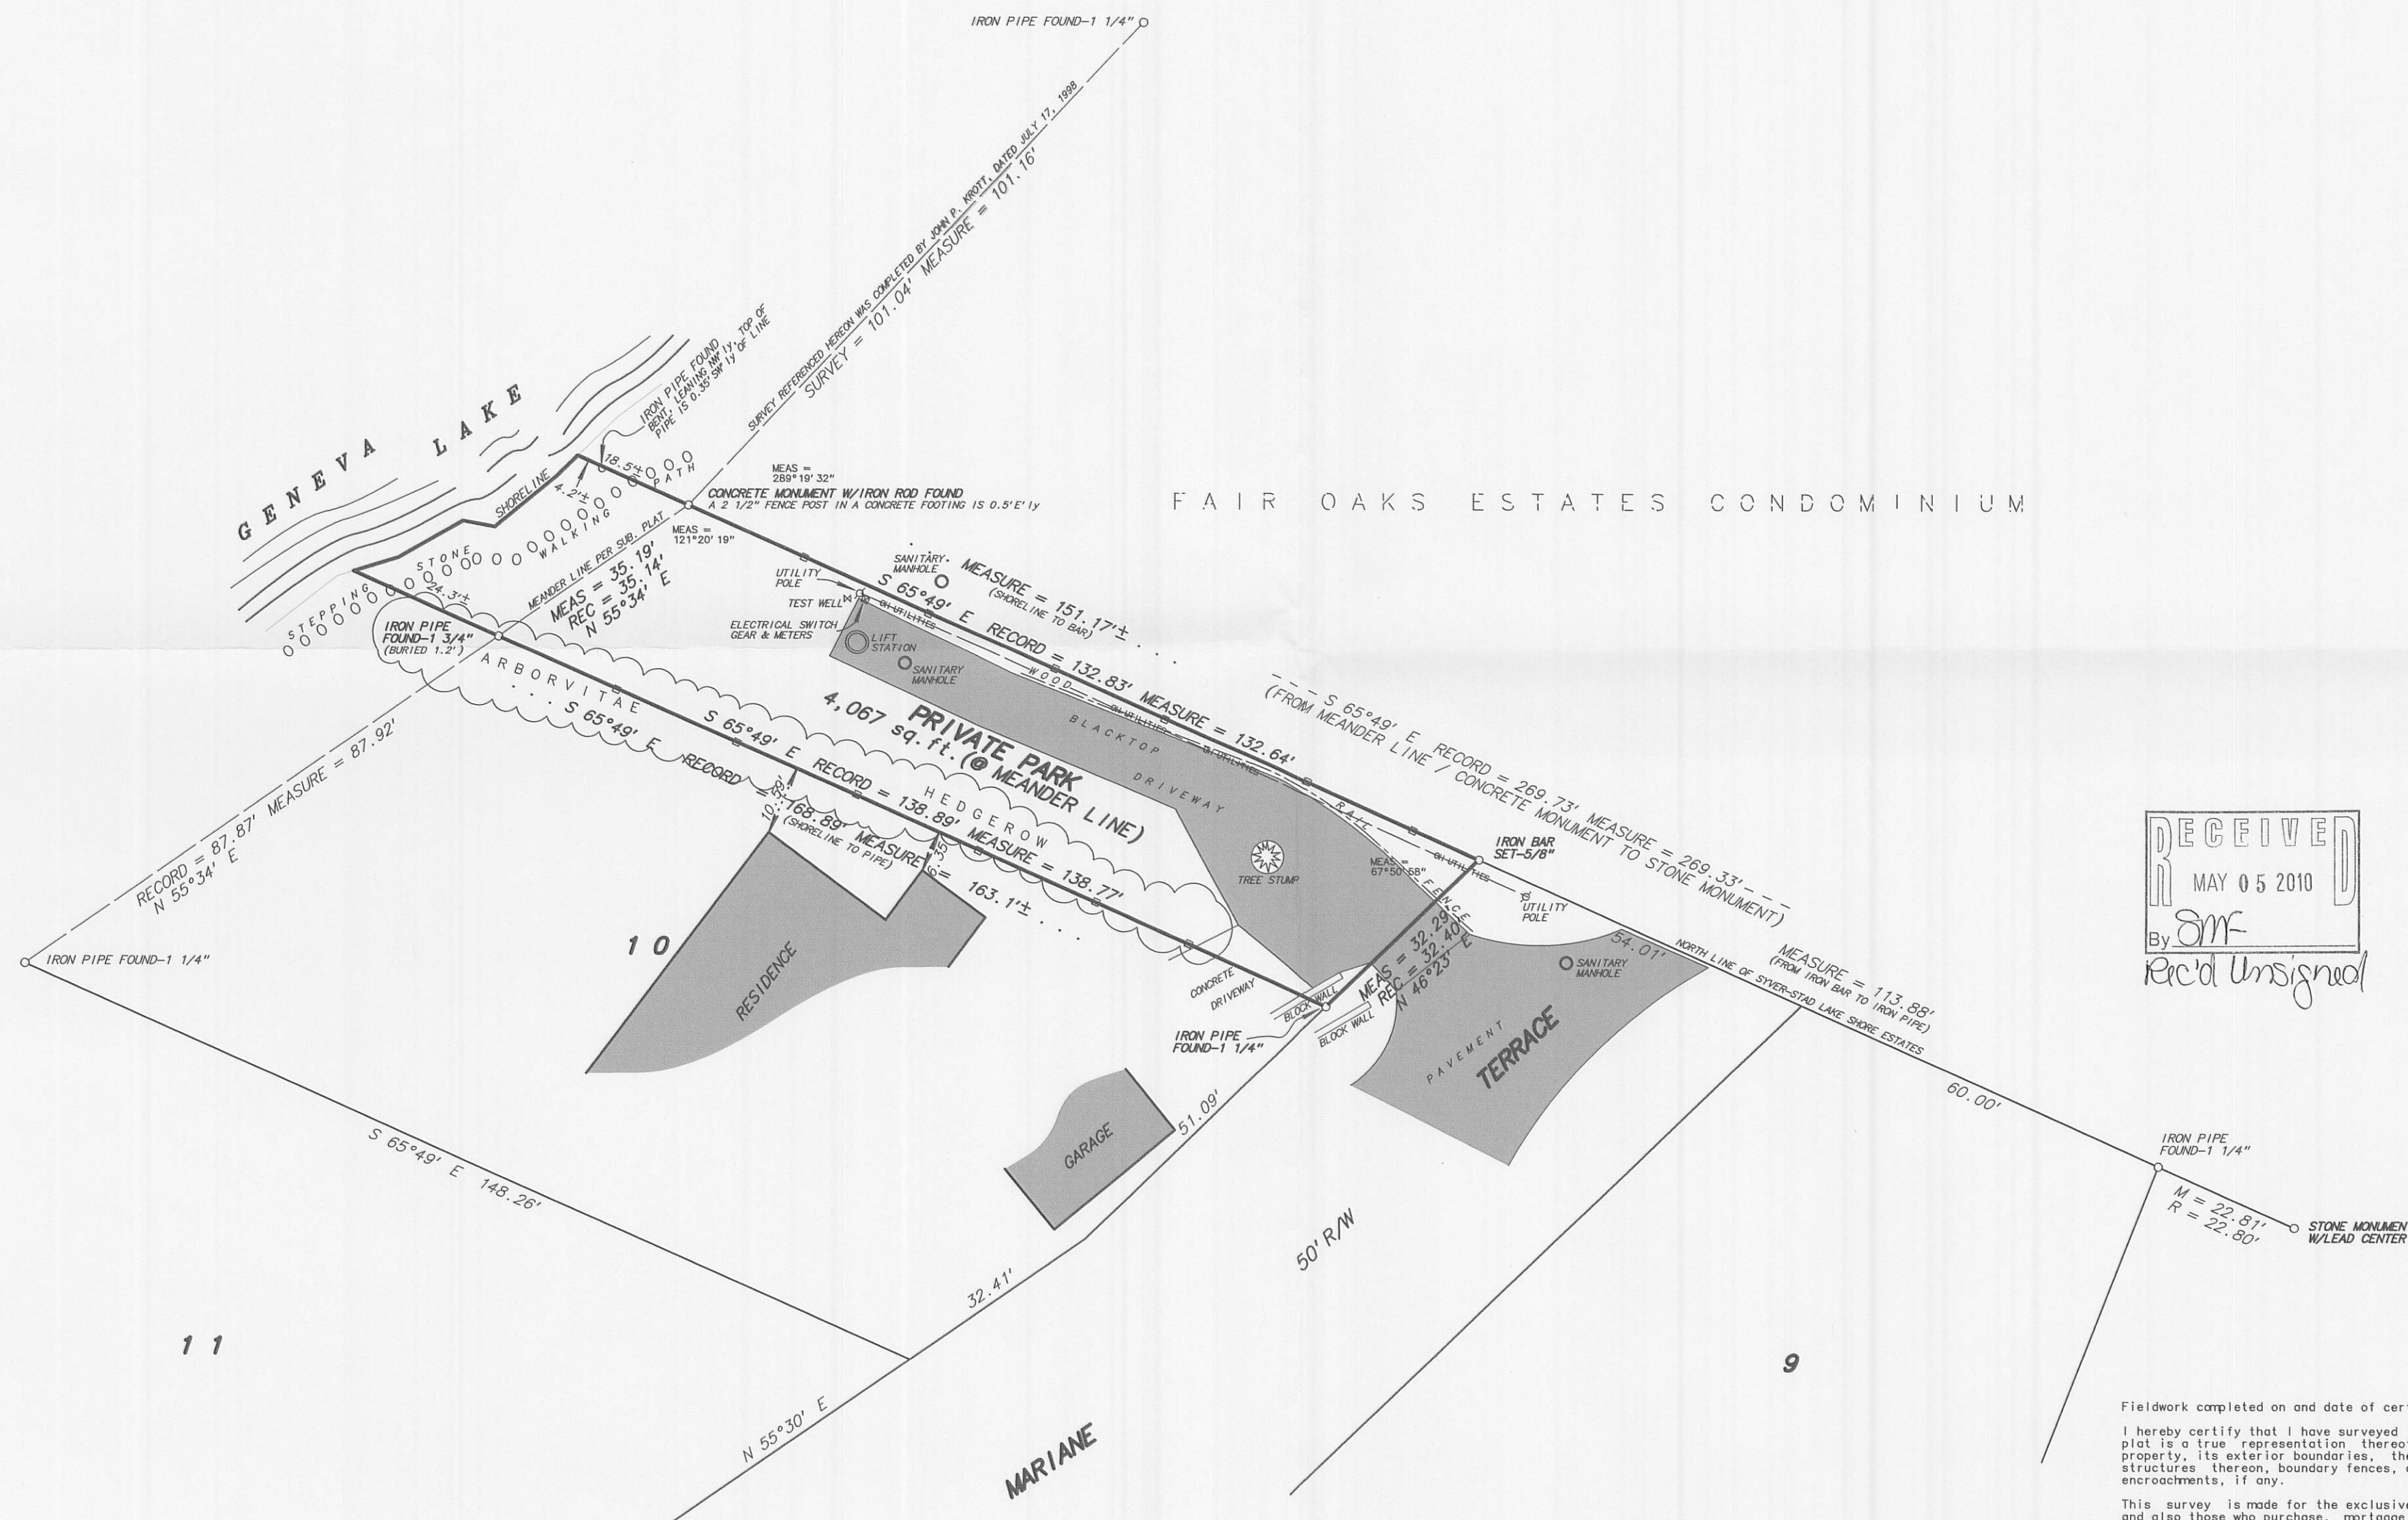

NOTE:
□ = WOOD LATH LINE STAKE SET ALONG PROPERTY LINE

SCALE: 1 inch = 20 feet
 ORDERED BY: D. Pierce / Pierce Builders
 JOB NO. 0 7 2 5 6

ZSY - 29

Fieldwork completed on and date of certification: April 11, 2008

I hereby certify that I have surveyed the above described property and the above plat is a true representation thereof and shows the size and location of the property, its exterior boundaries, the location and dimensions of all visible structures thereon, boundary fences, apparent easements and roadways and visible encroachments, if any.

This survey is made for the exclusive use of the present owners of the property, and also those who purchase, mortgage or guarantee the title thereto within ONE YEAR from the date hereof.

Dated at Bassett, Wisconsin this _____ day of _____ 2008.

Mark A. Bolender
Wisconsin Registered Land Surveyor S - 1784

007-2740