

WORK ORDERED BY --
JOE SCHULTZ
1655 WHITE PINES COURT
NAPERVILLE, IL 60563


FARRIS, HANSEN & ASSOCIATES, INC.
ENGINEERING - ARCHITECTURE - SURVEYING
7 RIDGWAY COURT P.O. BOX 437
ELKHORN, WISCONSIN 53121
OFFICE: (262) 723-2098 FAX: (262) 723-5886

REVISIONS


PROJECT NO.
8010
DATE:
08-24-2010
SHEET NO.
1 OF 1

PLAT OF SURVEY
LOT 1 OF BLOCK 19 OF LAKE GENEVA MANOR TRACT NO. 17
LOCATED IN THE SE 1/4 SECTION 35, TOWN 2 NORTH, RANGE 17 EAST
CITY OF LAKE GENEVA, WALWORTH COUNTY, WI.

ASSIGNED THE NORTHEASTERLY LINE OF LOT 1
S 36D29'00" E

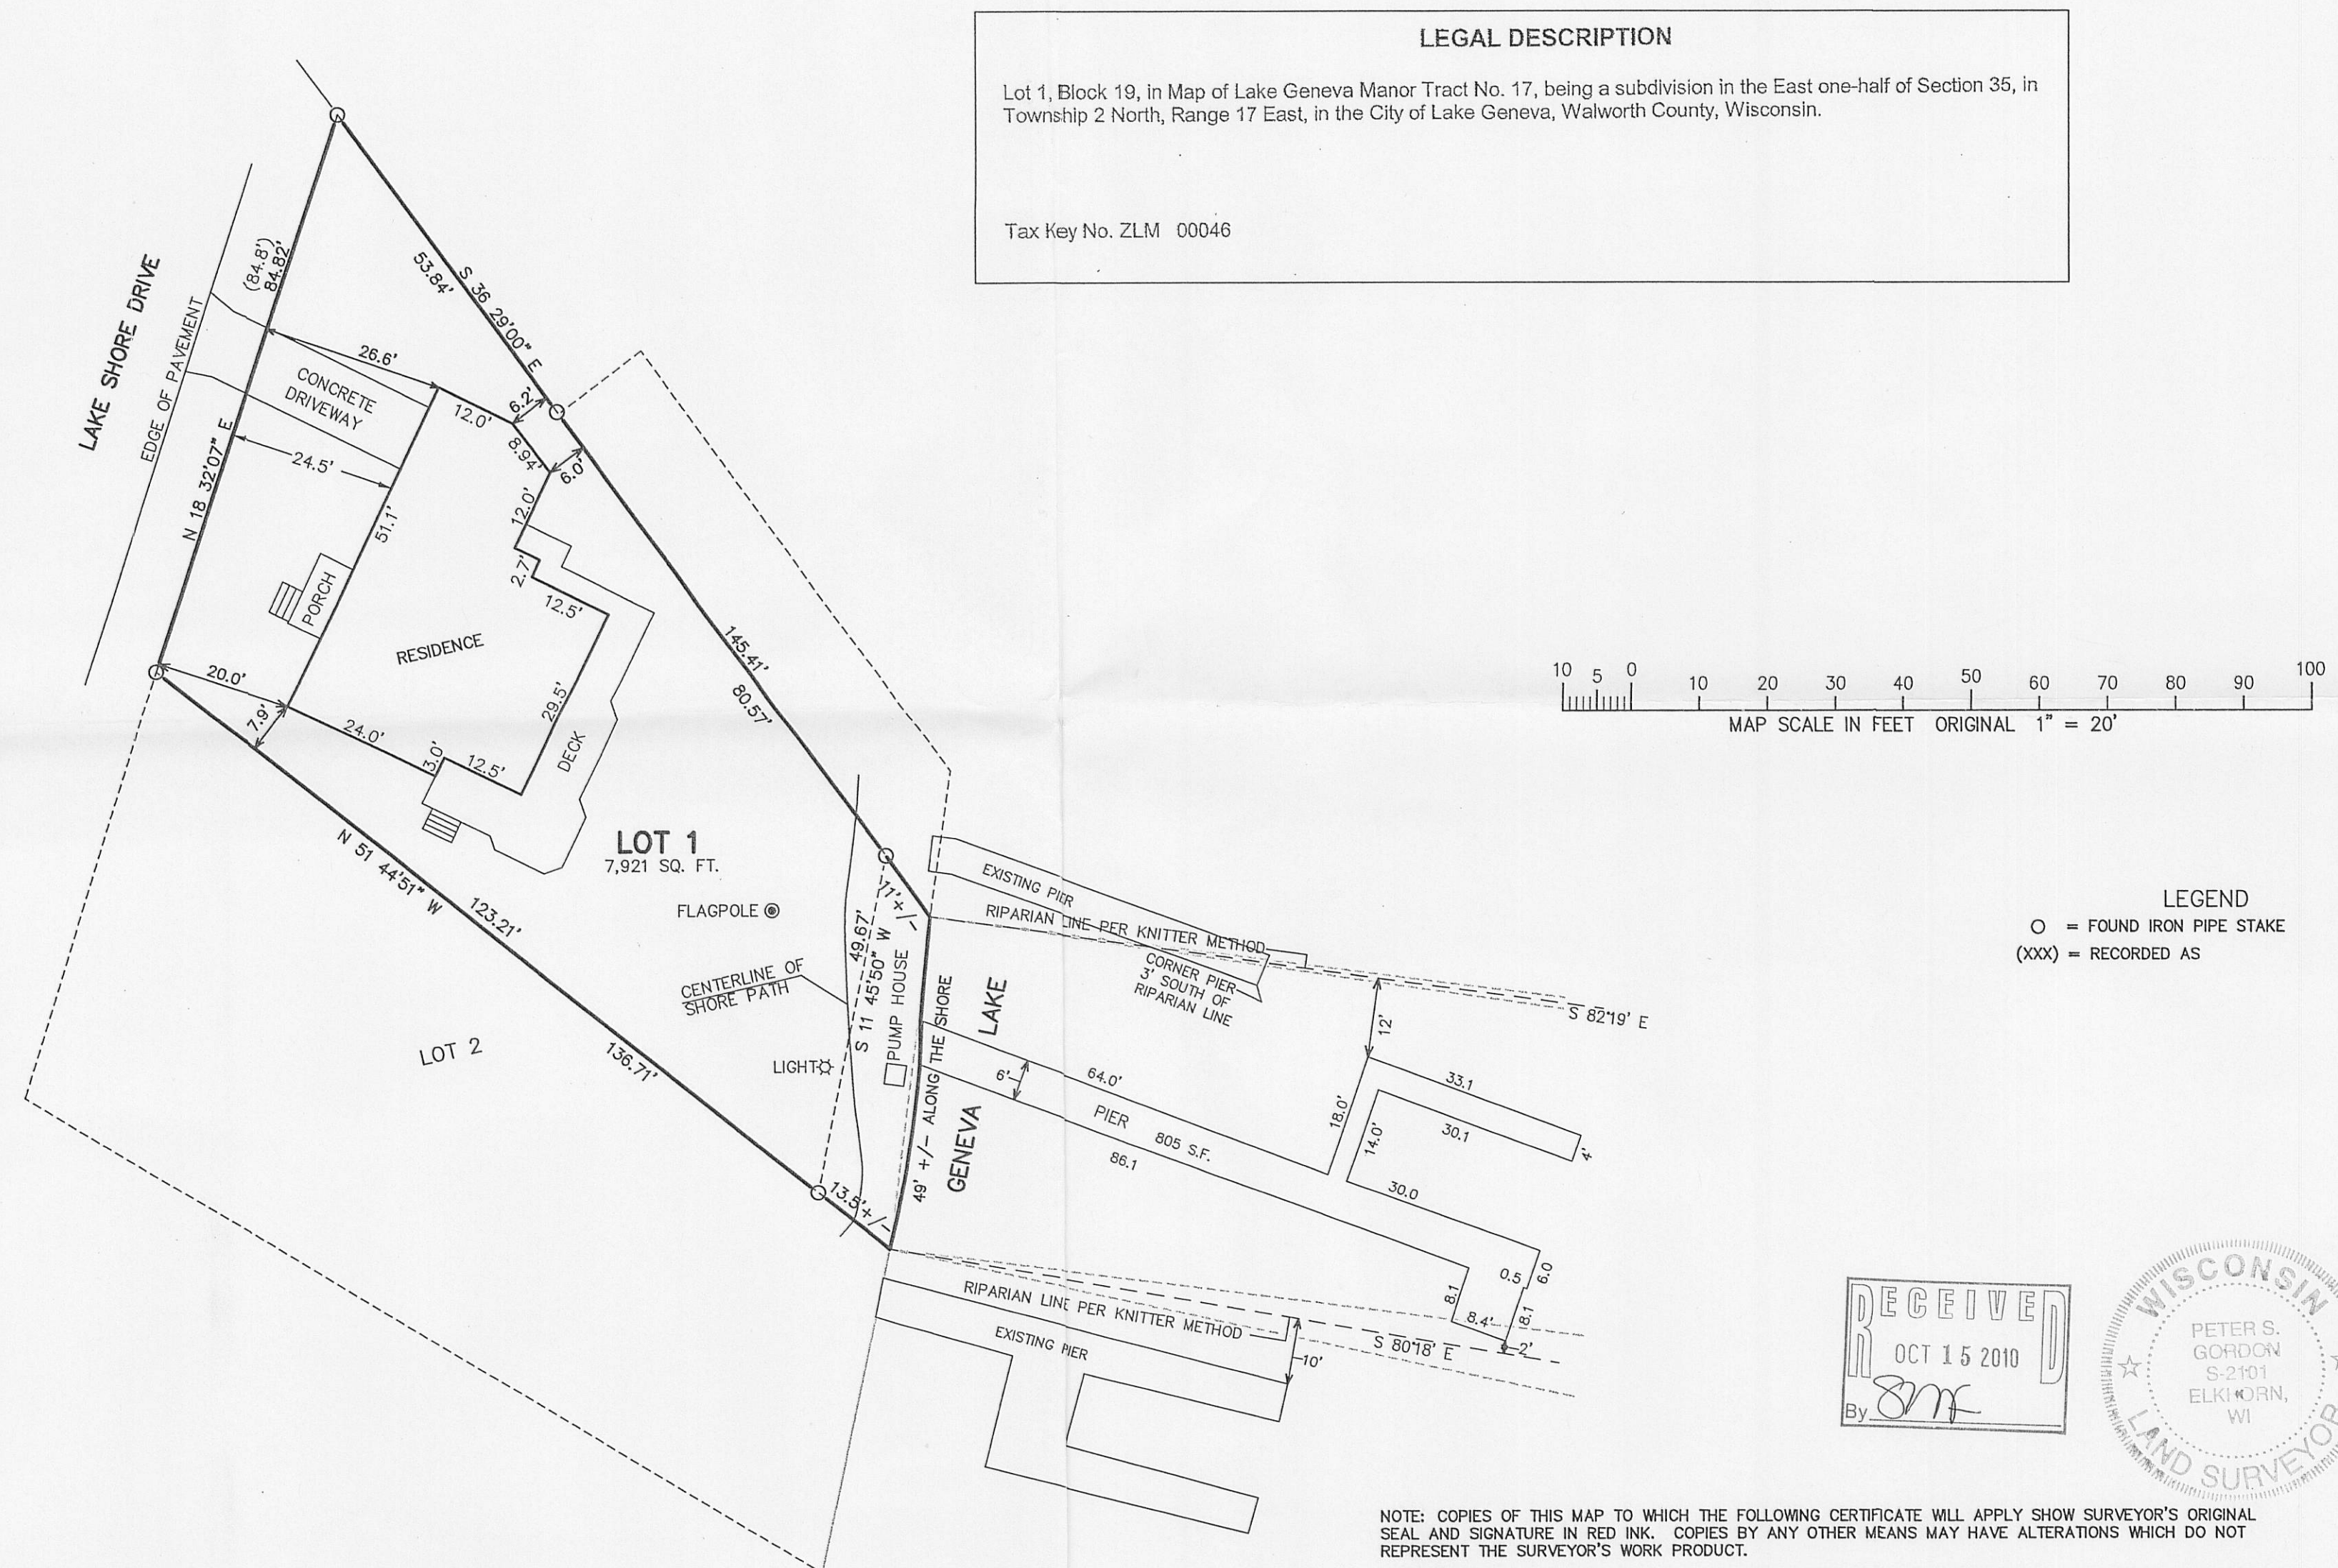


LEGAL DESCRIPTION
Lot 1, Block 19, in Map of Lake Geneva Manor Tract No. 17, being a subdivision in the East one-half of Section 35, in Township 2 North, Range 17 East, in the City of Lake Geneva, Walworth County, Wisconsin.
Tax Key No. ZLM 00046

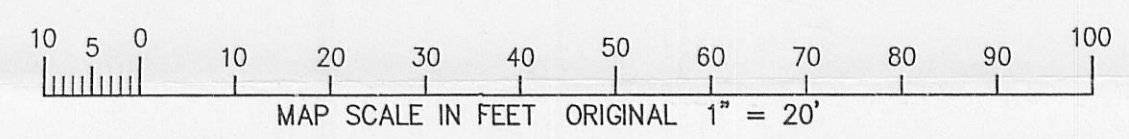

LEGEND
O = FOUND IRON PIPE STAKE
(XXX) = RECORDED AS

RECEIVED
OCT 15 2010
By *SM*

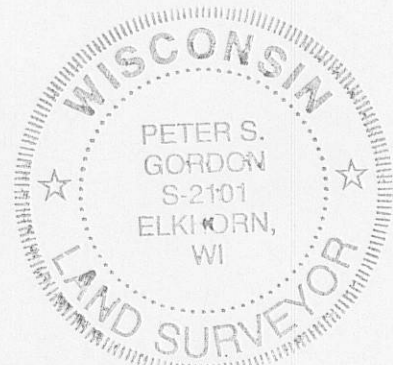

NOTE: COPIES OF THIS MAP TO WHICH THE FOLLOWING CERTIFICATE WILL APPLY SHOW SURVEYOR'S ORIGINAL SEAL AND SIGNATURE IN RED INK. COPIES BY ANY OTHER MEANS MAY HAVE ALTERATIONS WHICH DO NOT REPRESENT THE SURVEYOR'S WORK PRODUCT.
I HEREBY CERTIFY THAT THE ABOVE DESCRIBED PROPERTY HAS BEEN SURVEYED UNDER MY DIRECTION AND THAT THE ABOVE MAP IS A TRUE REPRESENTATION THEREOF AND SHOWS THE SIZE AND LOCATION OF THE PROPERTY, ITS EXTERIOR BOUNDARIES, THE LOCATION OF ALL VISIBLE STRUCTURES, AND DIMENSIONS OF ALL PRINCIPLE BUILDINGS THEREON, BOUNDARY FENCES, APPARENT EASEMENTS, ROADWAYS, AND VISIBLE ENCROACHMENTS, IF ANY. THIS SURVEY IS MADE FOR THE USE OF THE PRESENT OWNERS OF THE PROPERTY, AND ALSO THOSE WHO PURCHASE, MORTGAGE, OR GUARANTEE THE TITLE THERETO WITHIN ONE YEAR FROM THE DATE HEREOF.

DATED: AUGUST 24, 2010
REVISED 09-01-2010
TO SHOW RIPARIAN INFORMATION
Peter S. Gordon
PETER S. GORDON R.L.S. 2101