

FARRIS, HANSEN & ASSOCIATES, INC.
ENGINEERING — ARCHITECTURE — SURVEYING
7 RIDGWAY COURT P.O. BOX 437
ELKHORN, WISCONSIN 53121
OFFICE: (262) 723-2098 FAX: (262) 723-5886

REVISIONS

PROJECT NO.
7419

DATE
03-03-2011


SHEET NO.
1 OF 1

4. The land referred to in this policy is described as follows:

Unit 1, together with said unit's undivided percentage interest in the common elements and the exclusive use of the limited common elements appurtenant to said unit 1, all in Wrigley Drive Condominium, a condominium declared and existing under and by virtue of the Condominium Ownership Act of the State of Wisconsin and recorded by a duly recorded plat of such condominium in the office of the Registrar of Deeds of Walworth County, Wisconsin, on February 15, 2008, as Document No. 729673, and as amended by Amendment Number 1 to Declaration of Condominium of Wrigley Drive Condominium recorded on February 15, 2008 as Document No. 729676, said condominium being located in the City of Lake Geneva, County of Walworth, State of Wisconsin on the real estate described in said Declaration and incorporated herein by this reference thereto.

Together with rights retained in that certain dedication of Public Park and Street dated May 16, 1898 and recorded in the Walworth County Register of Deeds office in Volume 79 of Deeds on Page 154.

TAX KEY NO. PART of ZOP 03068

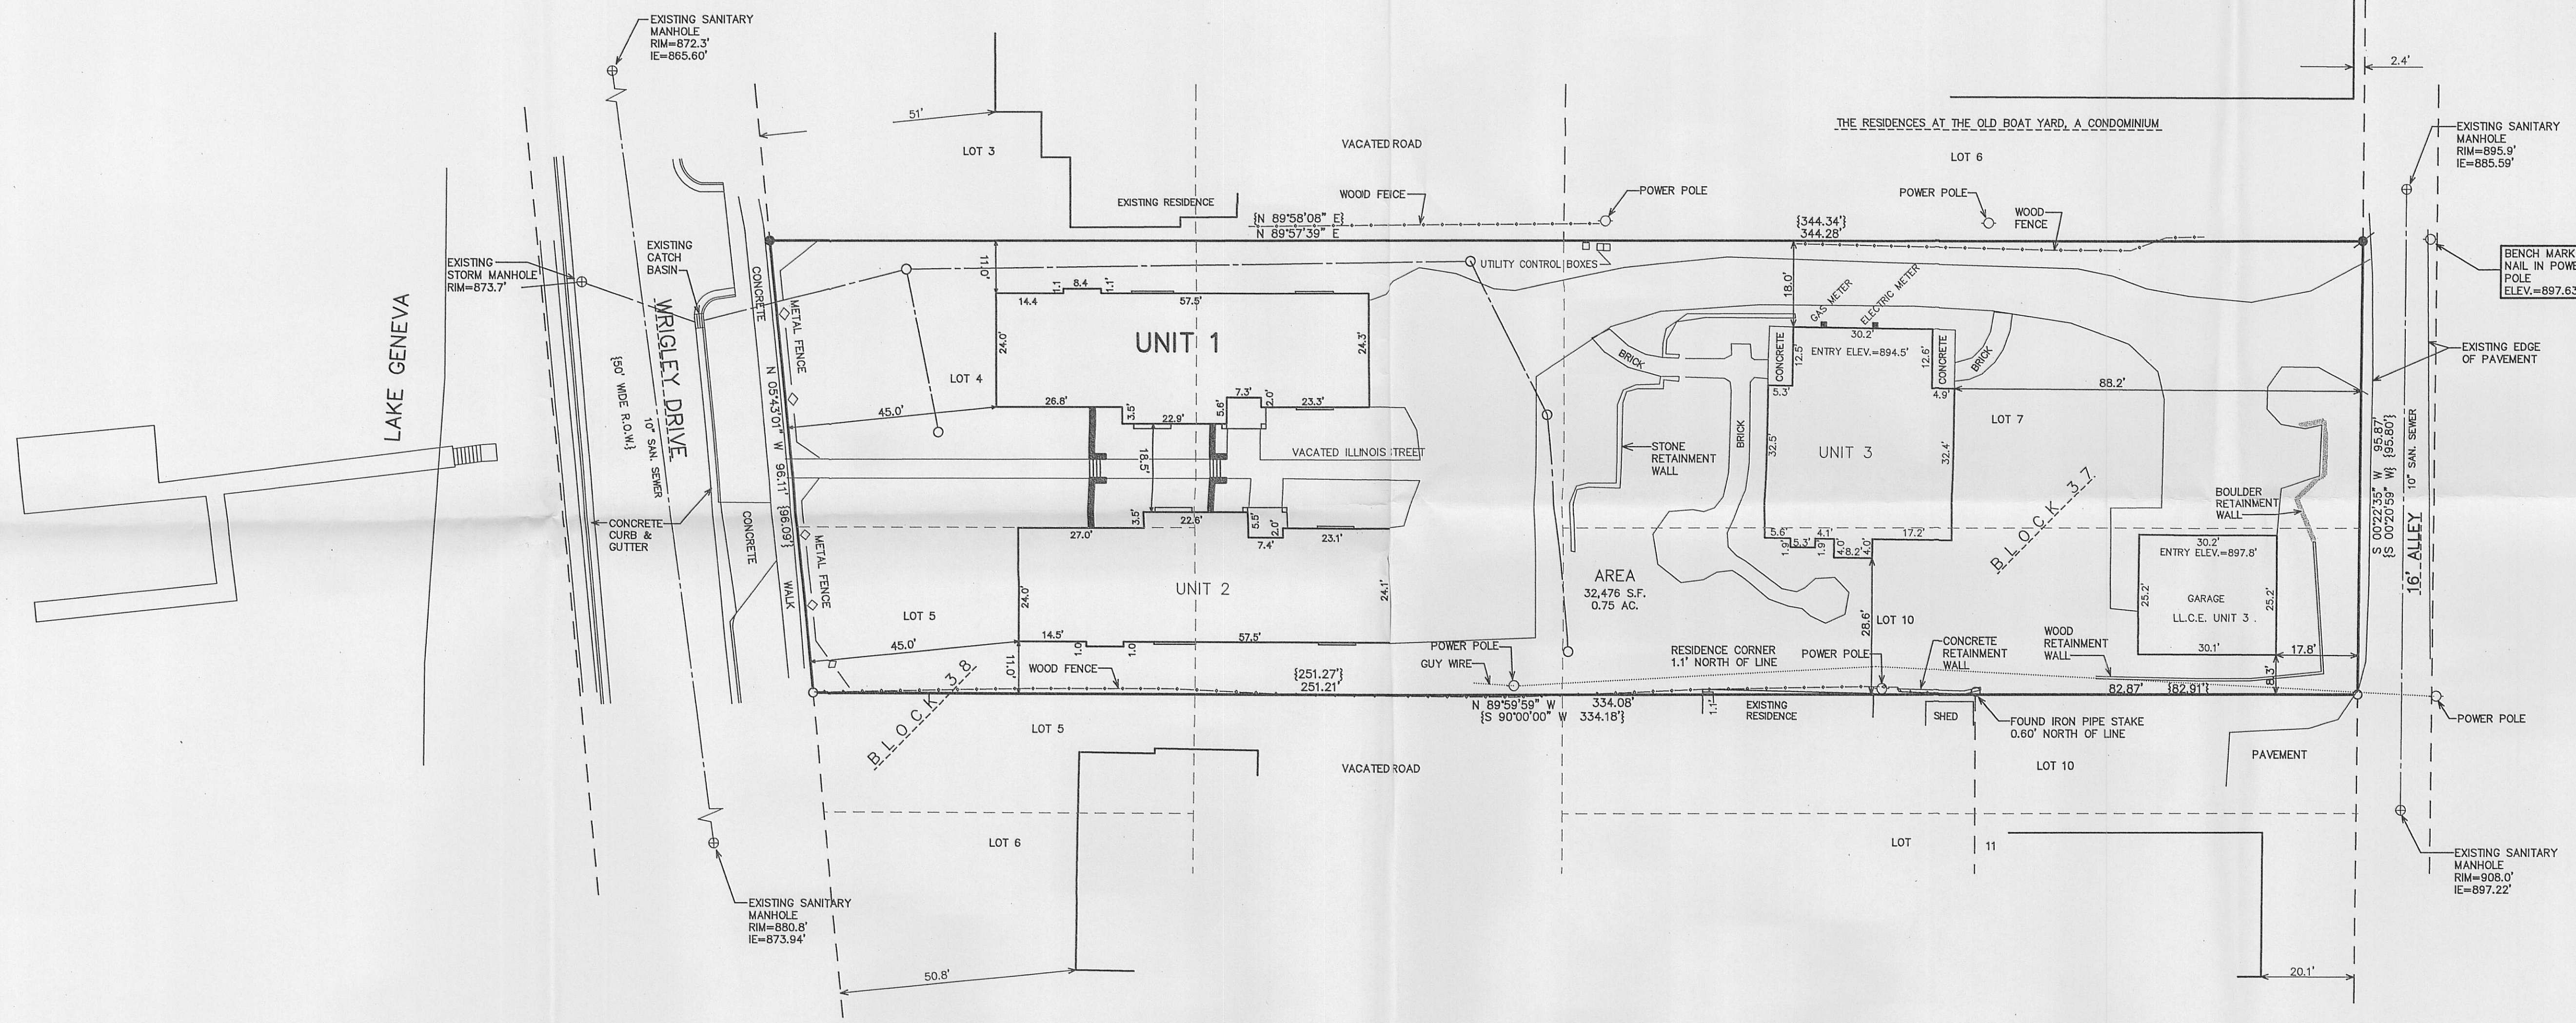

LEGEND



○ = FOUND IRON PIPE STAKE

● = FOUND IRON REBAR STAKE

⦿ = SET IRON REBAR STAKE

{XXX} = RECORDED AS


{XXX} = RECORDED AS

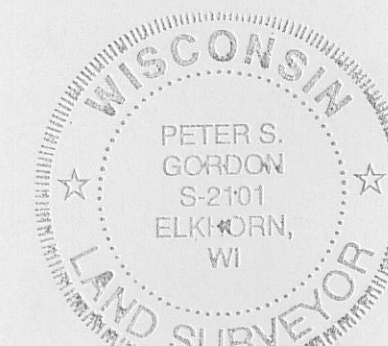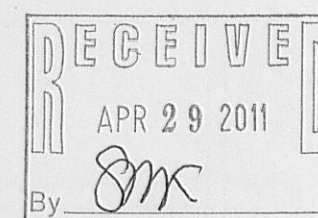

NOTE: COPIES OF THIS MAP TO WHICH THE FOLLOWING CERTIFICATE WILL APPLY SHOW SURVEYOR'S ORIGINAL SEAL AND SIGNATURE IN RED INK. COPIES BY ANY OTHER MEANS MAY HAVE ALTERATIONS WHICH DO NOT REPRESENT THE SURVEYOR'S WORK PRODUCT.

HEREBY CERTIFY THAT THE ABOVE DESCRIBED PROPERTY HAS BEEN SURVEYED UNDER MY DIRECTION AND THAT THE ABOVE MAP IS A TRUE REPRESENTATION THEREOF AND SHOWS THE SIZE AND LOCATION OF THE PROPERTY, ITS EXISTING BUILDINGS, THE LOTS AND ALL VISIBLE STRUCTURES, AND DIMENSIONS OF ALL PRINCIPLE BUILDINGS THEREON, BOUNDARY FENCES, APPARENT EASEMENTS, ROADWAYS, AND VISIBLE ENCROACHMENTS, IF ANY. THIS SURVEY IS MADE FOR THE USE OF THE PRESENT OWNERS OF THE PROPERTY, AND ALSO THOSE WHO PURCHASE, MORTGAGE, OR GUARANTEE THE TITLE THERETO WITHIN ONE YEAR FROM THE DATE HEREOF.

DATED: MARCH 7, 2011


PETER S. GORDON R.L.S. 210

X:\Projects\7419\NCAD\20110303_TTF

MAR 22 2011

