


**FARRIS, HANSEN & ASSOC. INC.**

7 RIDGWAY COURT- P.O. BOX 437  
ELKHORN, WISCONSIN 53121 BUOY LOCATION  
PHONE (262) 723-2098  
FAX (262) 723-5886

NOTE:  
23' BOAT + 4' PAINTER + 2' SCOPE = 29'

**RIPARIAN SURVEY**  
**PARK PARCEL SYLVAN GLEN SUBDIVISION**  
**LOCATED IN SECTION 13, TOWN 1 NORTH, RANGE 16 EAST**  
**VILLAGE OF FONTANA-ON-GENEVA LAKEWALWORTH COUNTY, WISCONSIN**  
BUOY LOCATION

NOTE:  
21' BOAT + 4' PAINTER + 2' SCOPE = 27'

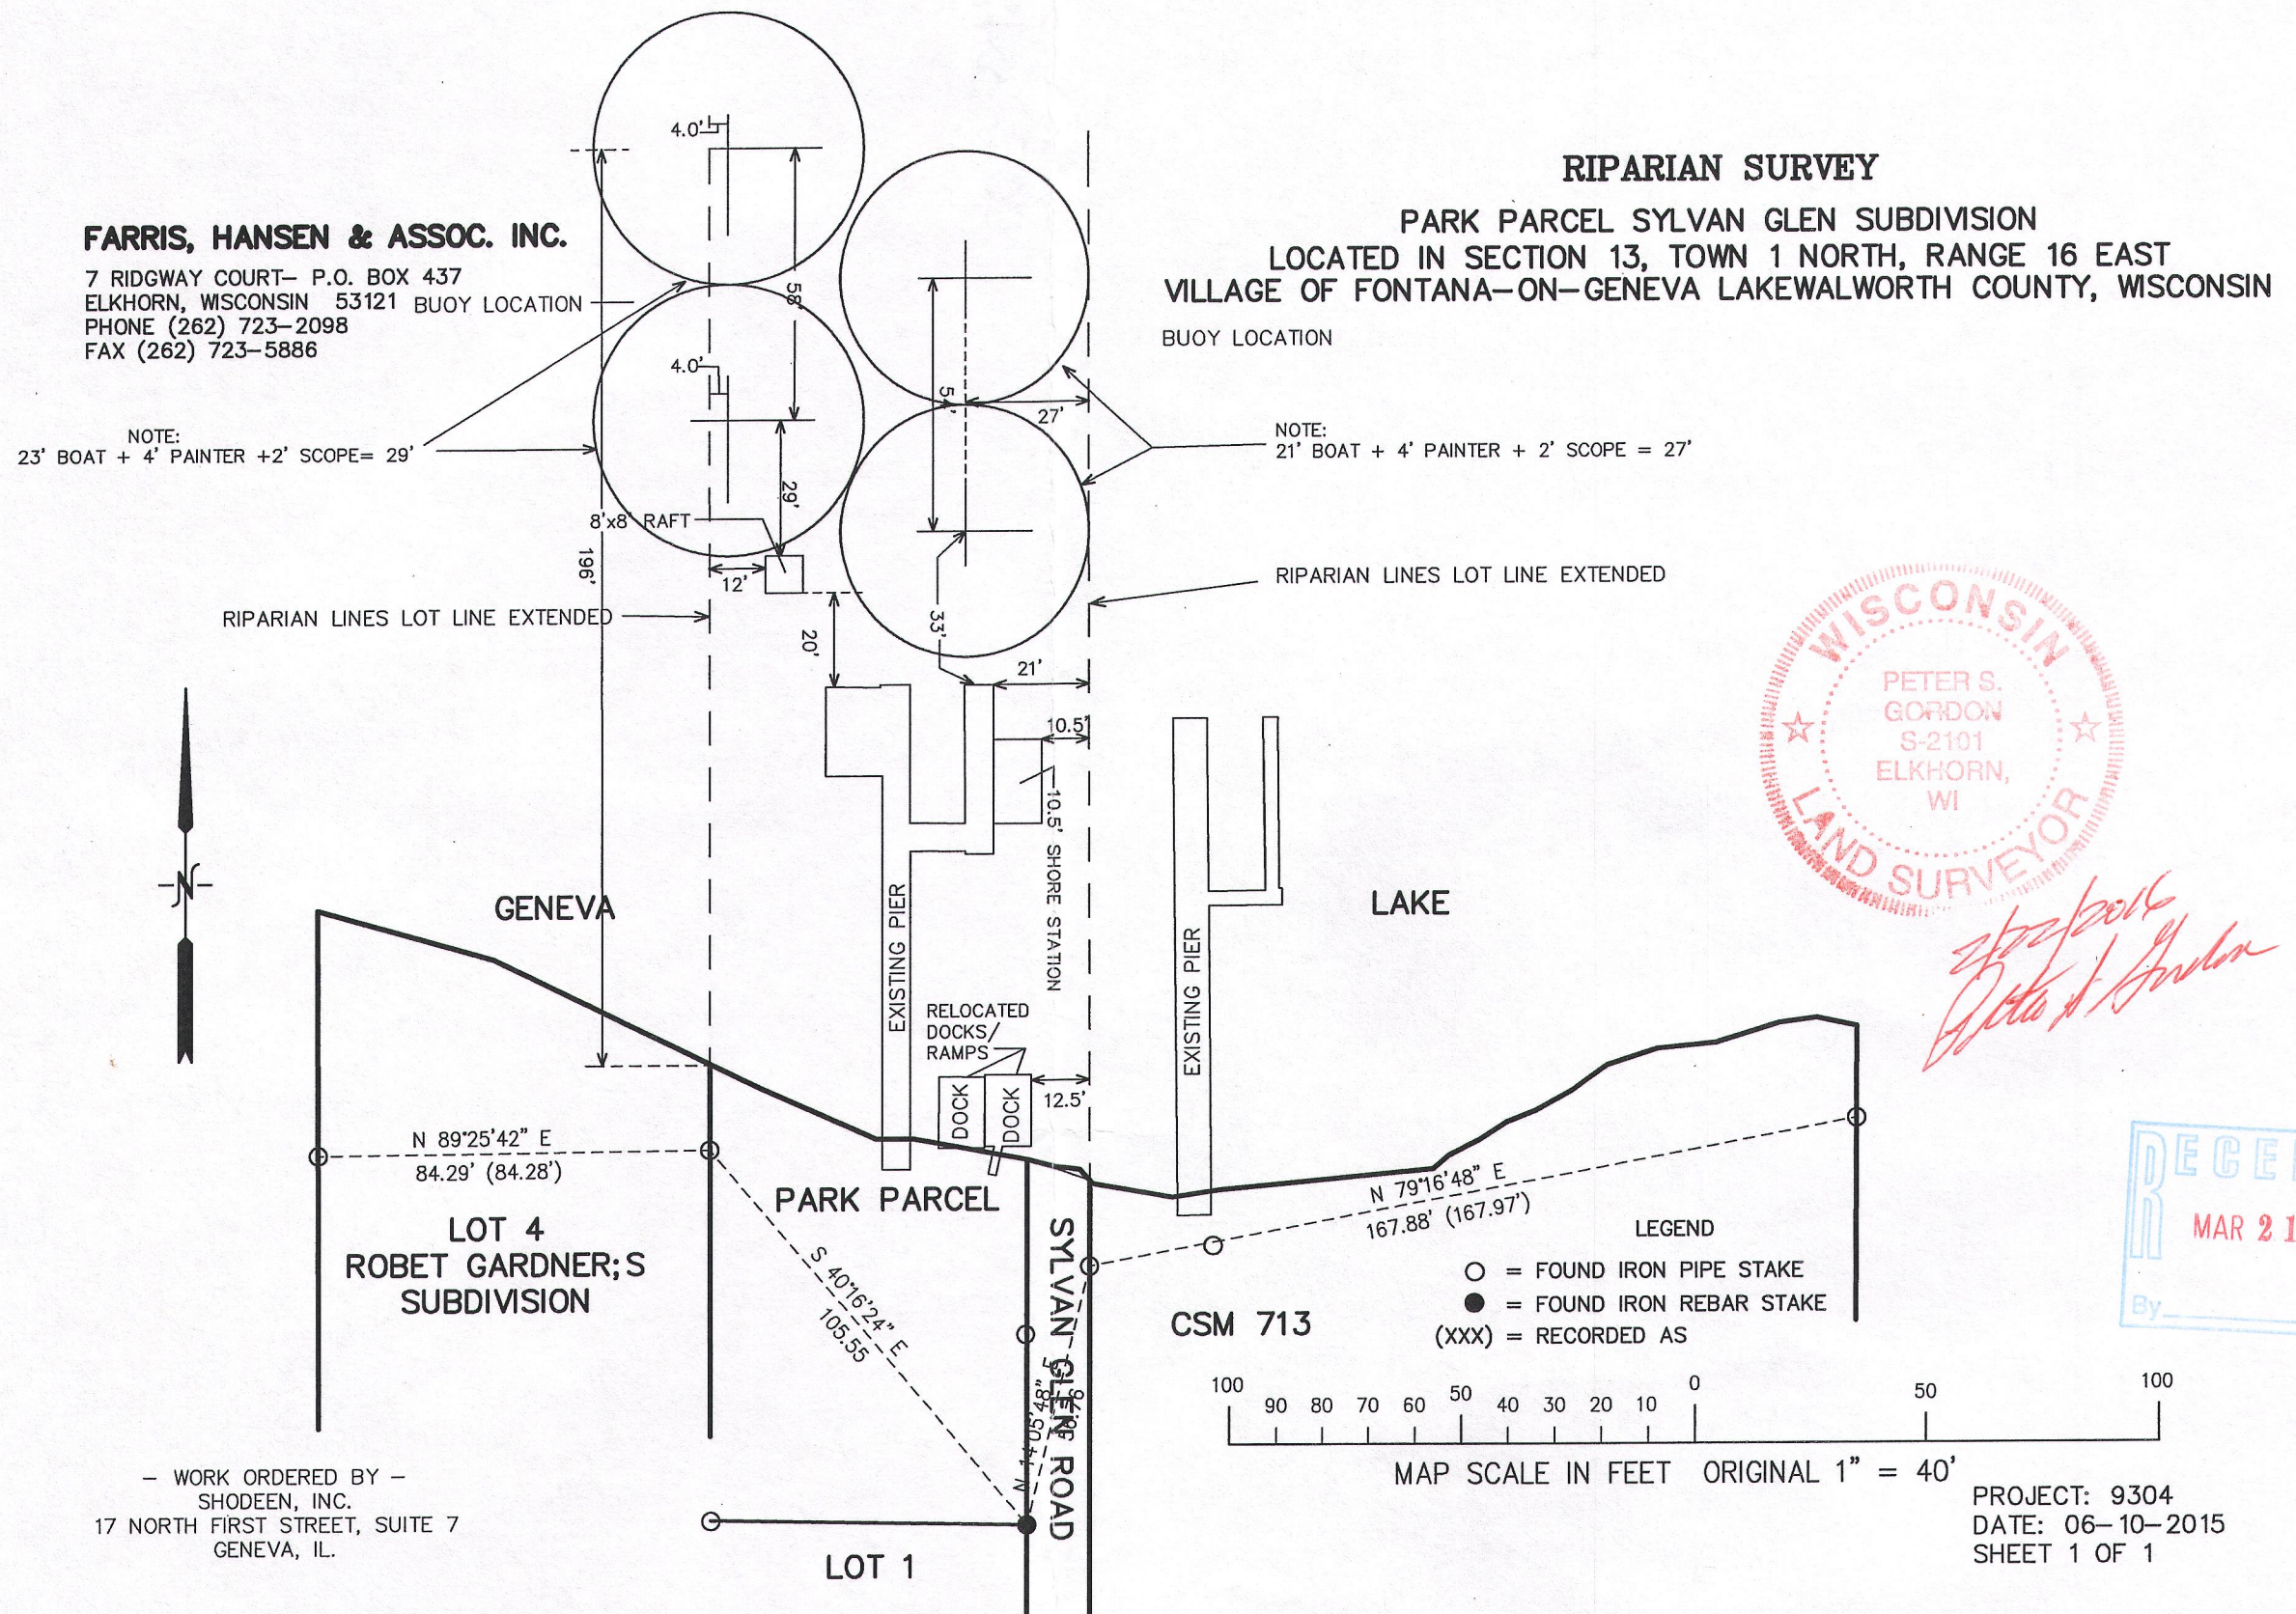

SSGN 9  
FEB 22 2016

007-3242