


*PLAT OF SURVEY*  
*OF*

EMAIL: [ambit@tds.net](mailto:ambit@tds.net)

PARCEL IDENTIFICATION NO.: ZTT 00001

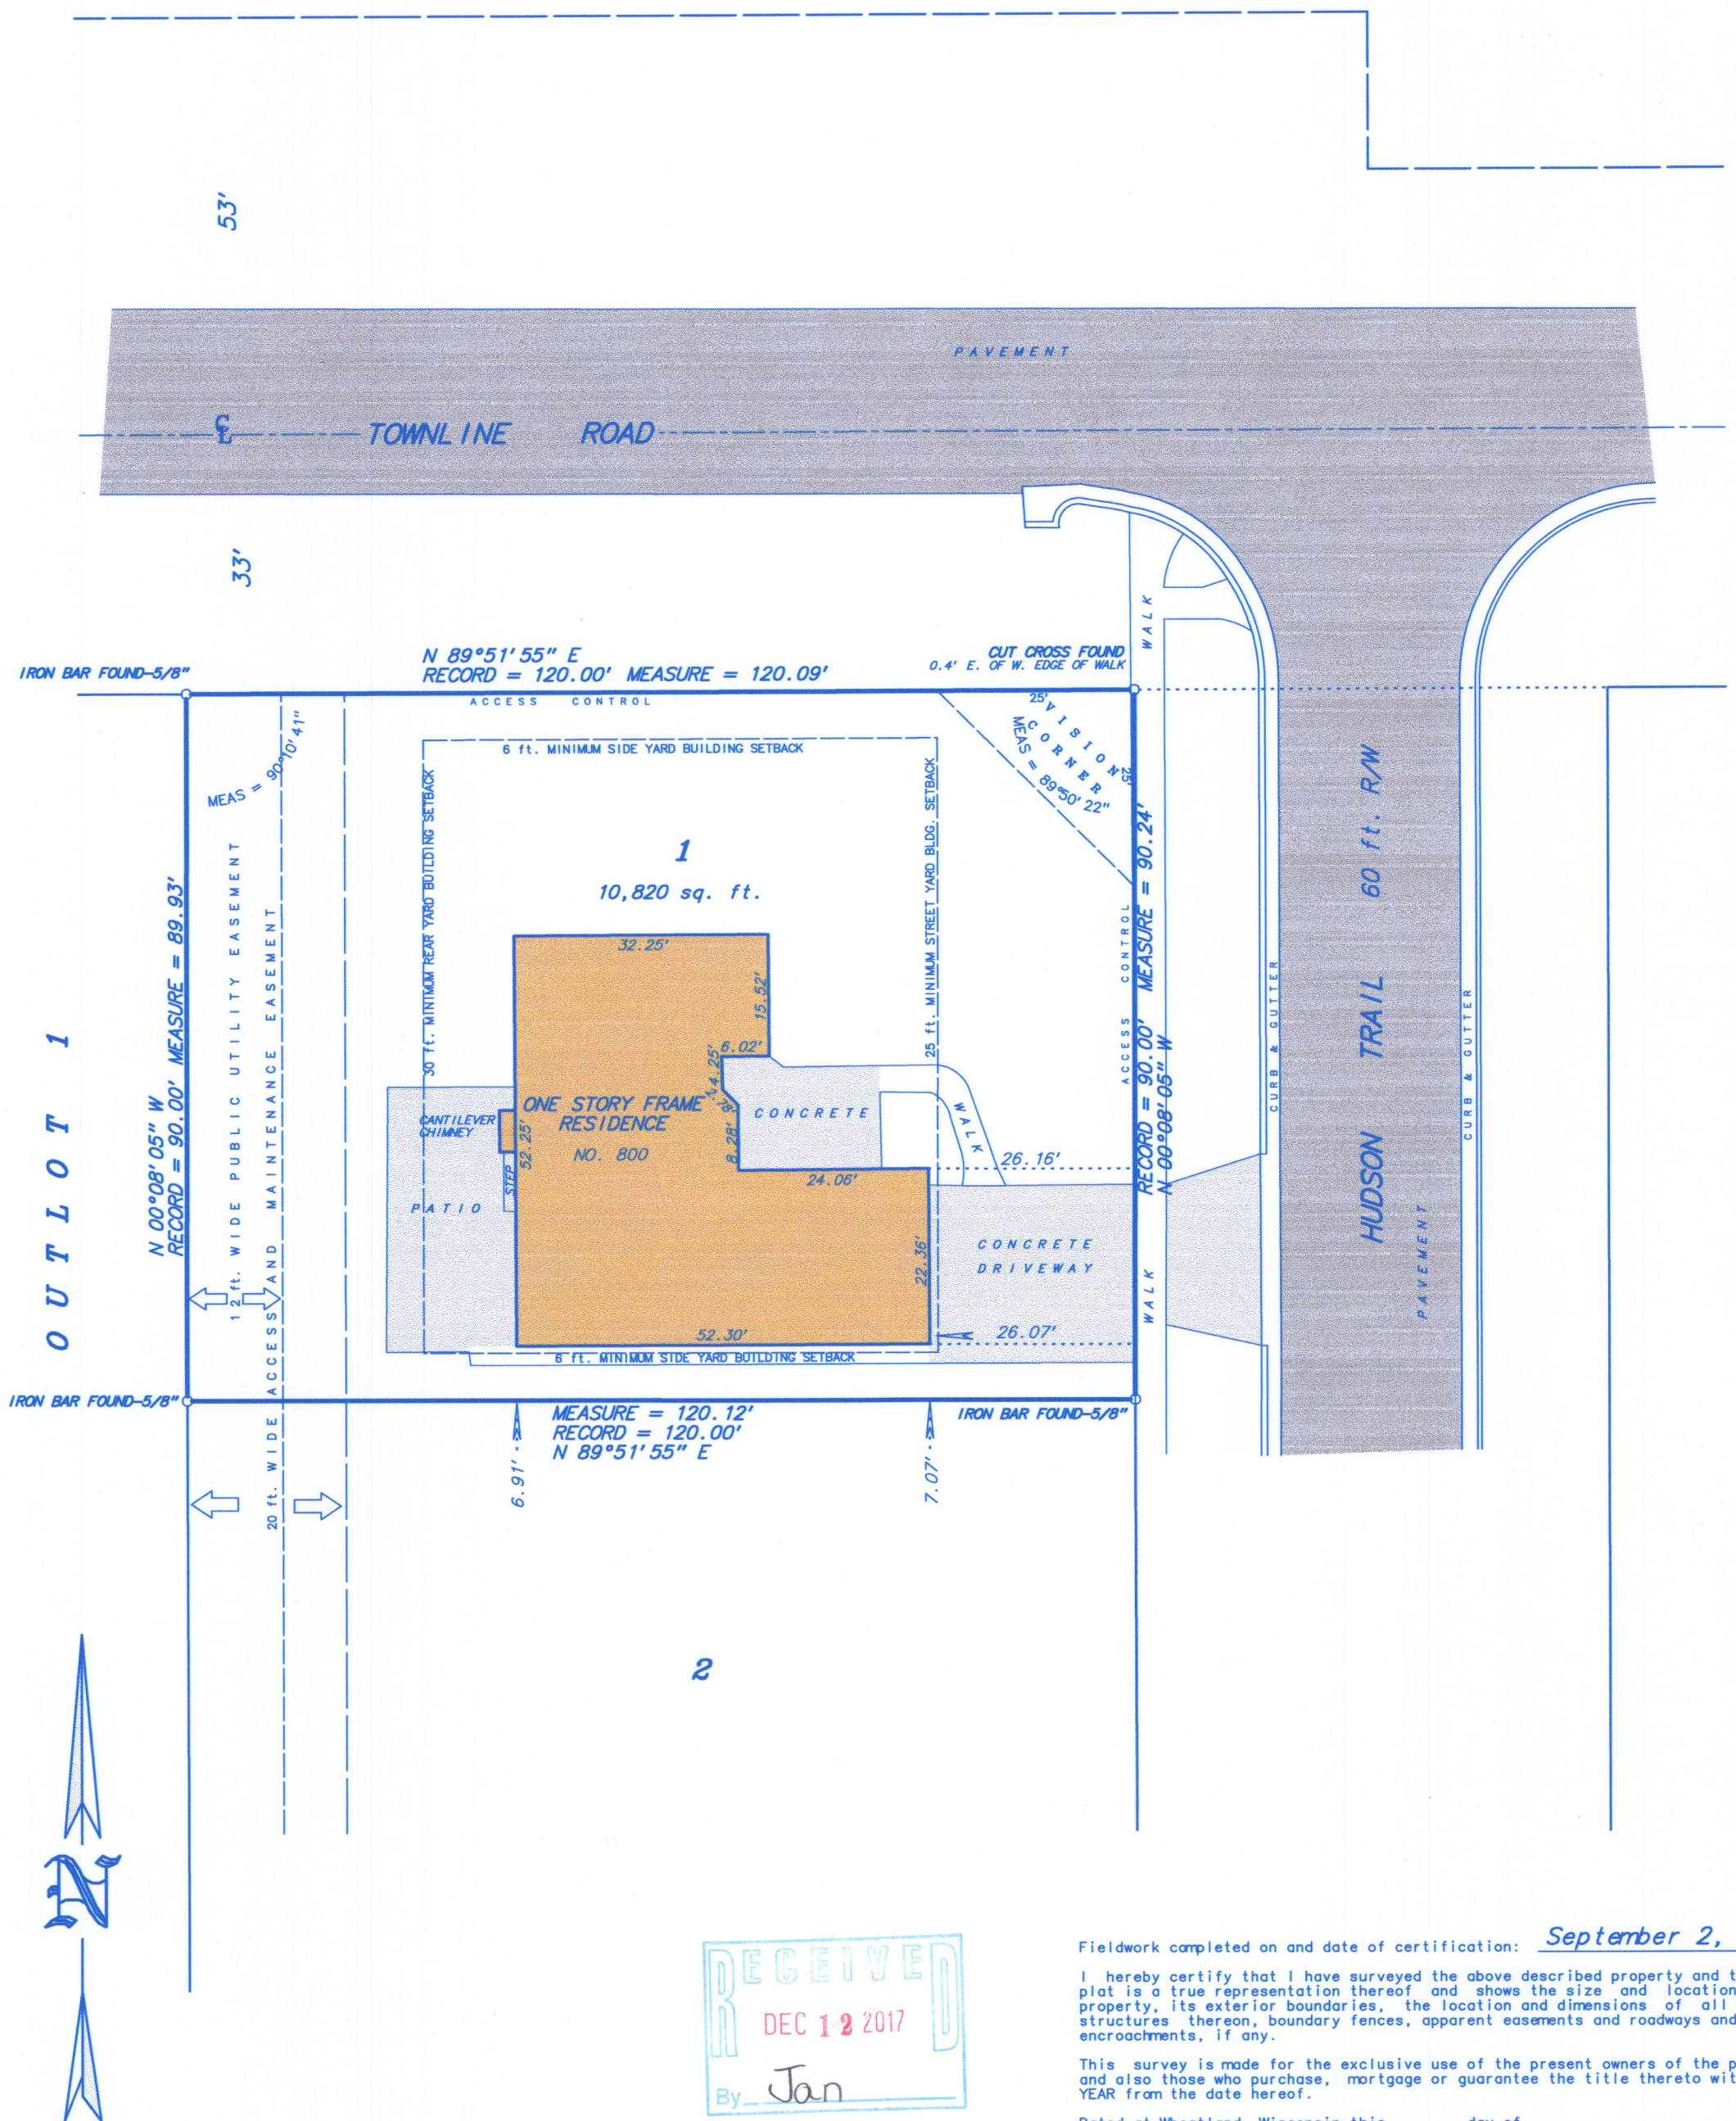

**JOB NO. :** 1 6 1 8 8

Mark A. Bolender  
Wisconsin Professional Land Surveyor 1784

ZTT-1 007-3440