PLAT OF SURVEY
LOT 1 OF CERTIFIED SURVEY MAP NO. 4347

LOCATED IN PART OF THE SW 1/4 OF THE SE 1/4 OF SECTION 36, TOWN 2 NORTH, RANGE 17 EAST, CITY OF LAKE GENEVA, WALWORTH COUNTY, WISCONSIN

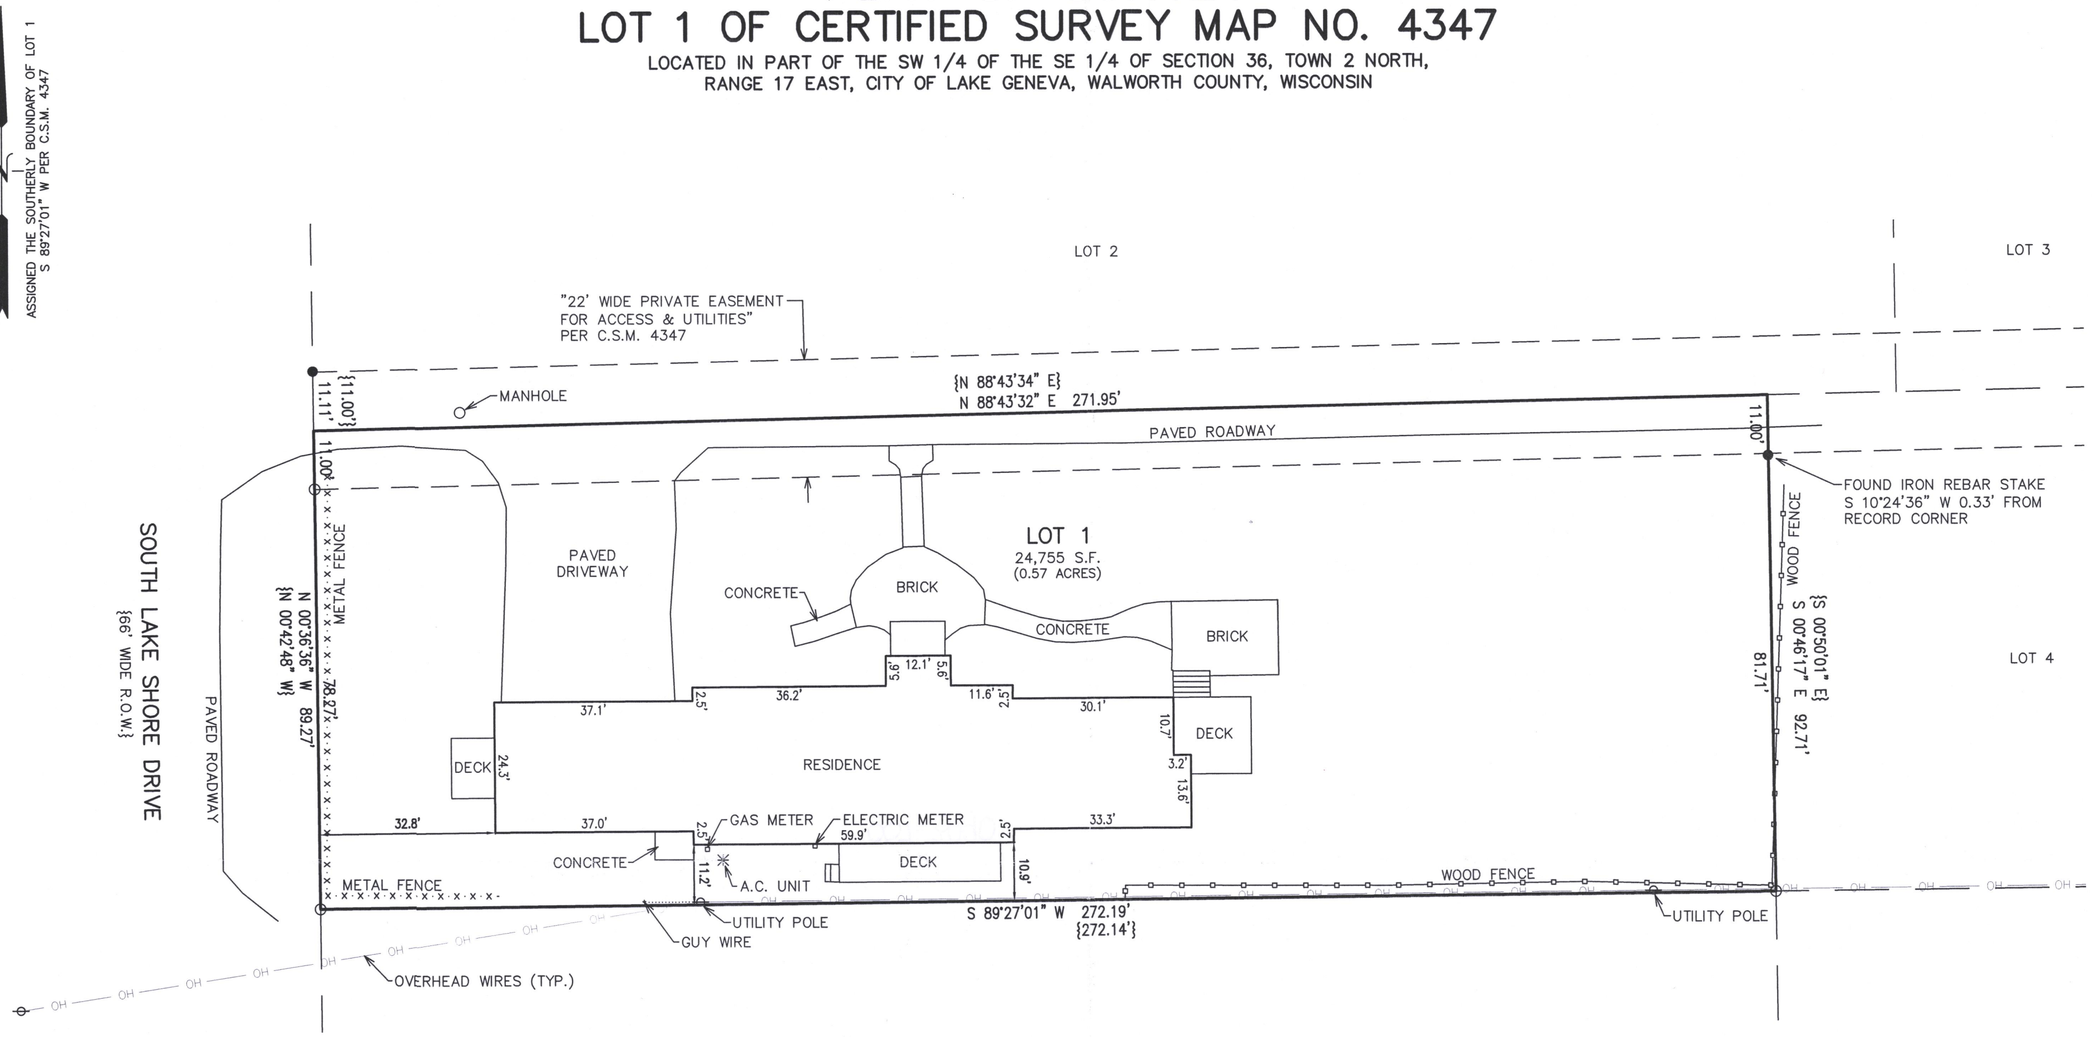

LEGEND

○ = FOUND IRON PIPE STAKE

● = FOUND IRON REBAR STAKE

{XXX} = RECORDED AS

20 10 0 20 40 60 80

MAP SCALE IN FEET – ORIGINAL 1"=20'

RECEIVED
JUL - 7 2022
By SMC

WISCONSIN
CHRISTOPHER A HODGES
2760
FALMYRA
WIS.
LAND SURVEYOR

NOTE: COPIES OF THIS MAP TO WHICH THE FOLLOWING CERTIFICATE WILL APPLY SHOW THE SURVEYOR'S ORIGINAL SEAL AND SIGNATURE IN RED INK. COPIES BY ANY OTHER MEANS MAY HAVE ALTERATIONS WHICH DO NOT REPRESENT THE SURVEYOR'S WORK PRODUCT.

I HEREBY CERTIFY THAT THE ABOVE DESCRIBED PROPERTY HAS BEEN SURVEYED UNDER MY DIRECTION AND THAT THE ABOVE MAP IS A TRUE REPRESENTATION THEREOF AND SHOWS THE SIZE AND LOCATION OF THE PROPERTY AND ITS EXTERIOR BOUNDARIES. THIS SURVEY IS MADE FOR THE USE OF THE PRESENT OWNERS OF THE PROPERTY, AND ALSO THOSE WHO PURCHASE, MORTGAGE, OR GUARANTEE THE TITLE THERETO WITHIN ONE YEAR FROM THE DATE HEREOF.

DATED: 5/25/2022

CHRISTOPHER A. HODGES P.L.S. 2760

PLAT OF SURVEY
615 S LAKE SHORE DRIVE
LAKE GENEVA, WISCONSIN

– WORK ORDERED BY –
RON MILES
615 S LAKE SHORE DRIVE
LAKE GENEVA, WI 53147

FARRIS, HANSEN & ASSOCIATES, INC.
ENGINEERING – ARCHITECTURE – SURVEYING
7 RIDGWAY COURT P.O. BOX 437
ELKHORN, WISCONSIN 53121
OFFICE: (262) 723-2098 FAX: (262) 723-5886

REVISIONS

PROJECT NO. 8095.1

DATE: 05/25/2022

SHEET NO. 1 OF 1

X:\PROJECTS\8095\8095_1\ACAD\8095_1.dwg

ZA4347-1

007-3990