


DESCRIPTION: Lot 12 of Lake Geneva East Shore Estates a subdivision of a portion of the City of Lake Geneva, Walworth County, Wisconsin.

CERTIFICATE: I, hereby certify that I have surveyed the above mentioned property and that the hereon portrayed is an accurate survey and a true representation thereof and correctly shows the exterior boundary lines and the location of the buildings and other improvements thereof.

Dated May 22nd 1967.

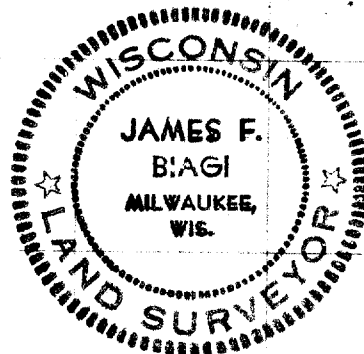

James F. Biagi, RLS 272
Elkhorn, Wisconsin.