# KOLB LAND CONSULTING, INC.

LAND SURVEYING · SUBDIVIDING · LAND PLANNING

LAKE GENEVA, WISCONSIN 53147 WHITEWATER, WISCONSIN 53190

RECEIVED
APR 11 1986

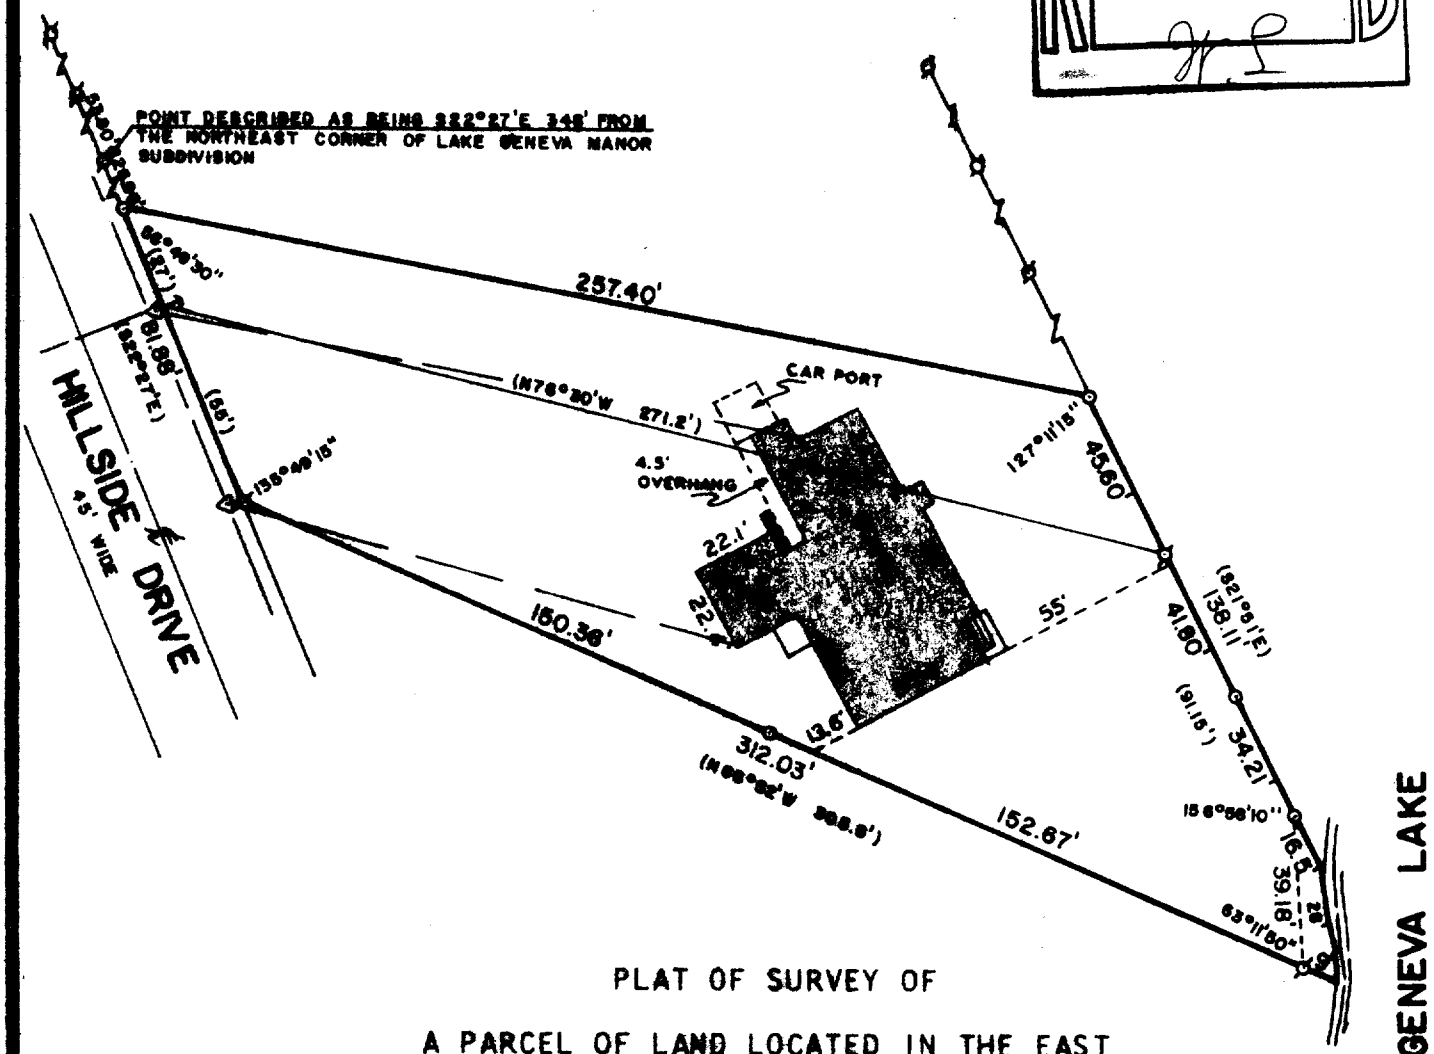


PLAT OF SURVEY OF

A PARCEL OF LAND LOCATED IN THE EAST ½ OF SECTION 35, T 2 N, R 17 E, CITY OF LAKE GENEVA, WALWORTH COUNTY, WISCONSIN.

ORDERED BY: KEN SEAVER
3586 VINE ROAD
LAKE GENEVA, WISCONSIN 53147

NOTE: LOCATED ALL VISIBLE IMPROVEMENTS, 1-9-86

SCALE: 1"=50'

ø - IRON PIPE FOUND
o - IRON PIPE PLACED
( ) - RECORDED AS
Δ - UTILITY POLE
———OVERHEAD UTILITY LINE
↓ - UTILITY POLE ANCHOR

I, HAROLD H. KOLB, DO HEREBY CERTIFY THAT I HAVE SURVEYED THE PROPERTY HEREON DESCRIBED ACCORDING TO THE OFFICIAL RECORDS, AND THAT THE PLAT HEREON IS A CORRECT REPRESENTATION OF THE LOT LINES TO THE BEST OF MY KNOWLEDGE AND BELIEF.

Harold H. Kolb
HAROLD H. KOLB
WISCONSIN REGISTERED LAND SURVEYOR, S-187

DATE Aug. 20, 1982

REVISED: JANUARY 10, 1986

7-811-K

YUP-94-I

LG-YUP-94I