KOLB LAND CONSULTING, INC.

LAND SURVEYING · SUBDIVIDING · LAND PLANNING

929 WILLIAMS STREET LAKE GENEVA, WISCONSIN 53147 414-248-3697

RECEIVED NOV 13 1986

EUGENE DRIVE 60' WIDE

SCALE: 1" = 40'

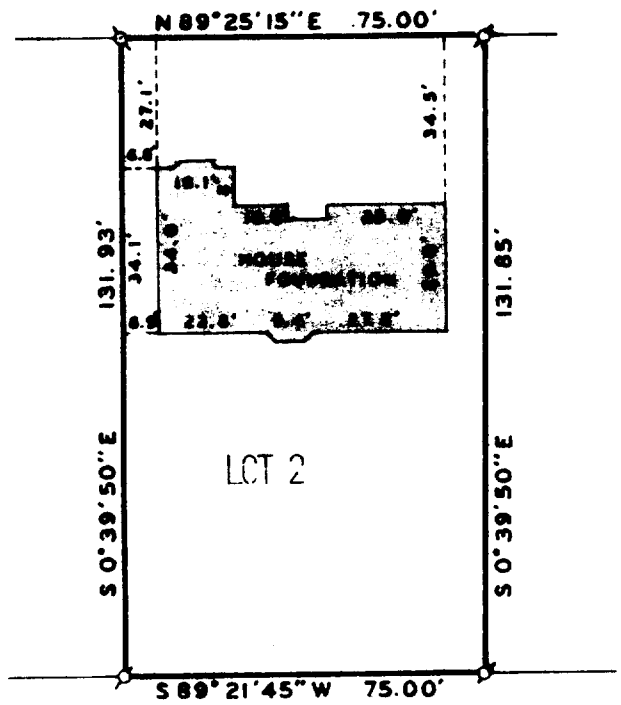

LEGEND

ø - IRON PIPE FOUND

ORDERED BY: ANCHOR SAVINGS AND LOAN
201 BROAD
LAKE GENEVA, WI. 53147

NOTE: BEARINGS ARE TIED TO WISCONSIN STATE PLANE COORDINATES; SOUTH ZONE.

PLAT OF SURVEY OF

LOT 2 OF CERTIFIED SURVEY MAP NUMBER 1490, LOCATED IN THE NORTHWEST 1/4 OF SECTION 1, T1N, R17E, CITY OF LAKE GENEVA, WALWORTH COUNTY, WISCONSIN.

I, HAROLD H. KOLB, DO HEREBY CERTIFY THAT I HAVE SURVEYED THE PROPERTY HEREON DESCRIBED ACCORDING TO THE OFFICIAL RECORDS AND THAT THE PLAT HEREON IS A CORRECT REPRESENTATION OF THE LOT LINES AND THE PRINCIPAL LINES OF THE FOUNDATION, TO THE BEST OF MY KNOWLEDGE AND BELIEF.

WISCONSIN HAROLD H. KOLB LAKE GENEVA, WI. LAND SURVEYOR

Harold H. Kolb

HAROLD H. KOLB

WISCONSIN REGISTERED LAND SURVEYOR, S-187

DATE JULY 29, 1986

REVISED

REVISED

2A 1490-2 LG- 484 7-874K