RECEIVED
NOV 13 1986

KOLB LAND CONSULTING, INC.

LAND SURVEYING · SUBDIVIDING · LAND PLANNING

929 WILLIAMS STREET LAKE GENEVA, WISCONSIN 53147 414-248-3697

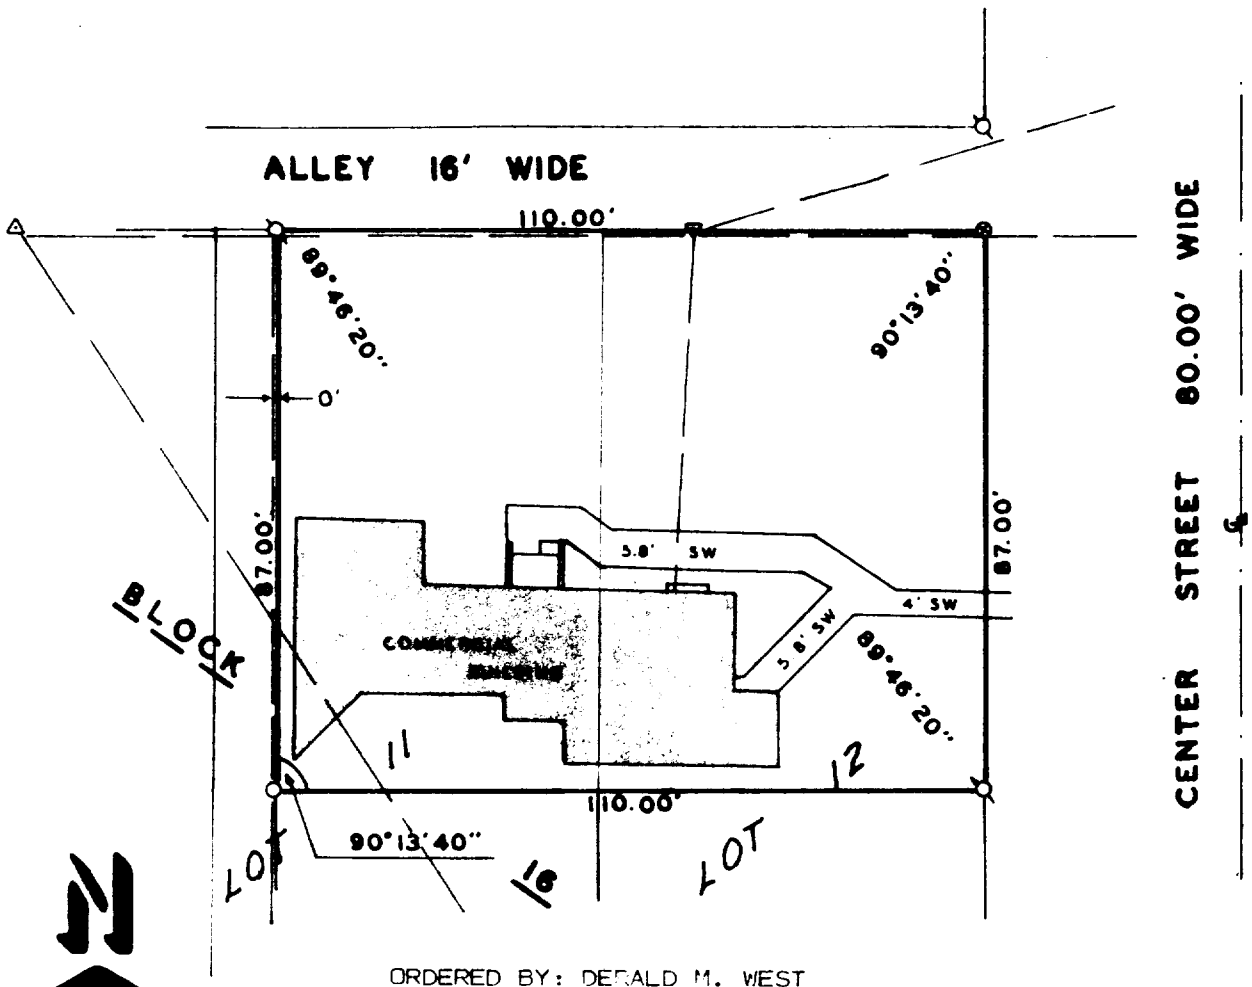

ORDERED BY: DERALD M. WEST
312 CENTER STREET
LAKE GENEVA, WI. 53147

SCALE: 1" = 30'

PLAT OF SURVEY OF

THE NORTH 87 FEET OF THE EAST 50 FEET OF LOT 11 AND THE NORTH 87 FEET OF LOT 12, BLOCK 16, OF THE ORIGINAL PLAT OF THE CITY OF LAKE GENEVA, WALWORTH COUNTY, WISCONSIN.

LEGEND

- ø - IRON PIPE FOUND
- O - 1-1/4" X 24" IRON PIPE SET
- ● - RAILROAD SPIKE SET
- △ - UTILITY POLE
- —— —— - OVERHEAD UTILITY LINE
- SW - SIDE WALK

I HEREBY CERTIFY THAT I HAVE SURVEYED THE ABOVE DESCRIBED PROPERTY AND THAT THE ABOVE MAP IS A TRUE REPRESENTATION THEREOF AND SHOWS THE SIZE AND LOCATION OF THE PROPERTY, ITS EXTERIOR BOUNDARIES, THE LOCATION OF ALL VISIBLE STRUCTURES AND DIMENSIONS OF ALL PRINCIPAL BUILDINGS THEREON, BOUNDARY FENCES, APPARENT EASEMENTS, ROADWAYS AND VISIBLE ENCROACHMENTS, IF ANY, TO THE BEST OF MY KNOWLEDGE AND BELIEF.
THIS SURVEY IS MADE FOR THE USE OF THE PRESENT OWNERS OF THE PROPERTY, AND ALSO THOSE WHO PURCHASE, MORTGAGE, OR GUARANTEE THE TITLE THERETO WITHIN ONE (1) YEAR FROM DATE HEREOF.

Harold H. Kolb

HAROLD H. KOLB

WISCONSIN REGISTERED LAND SURVEYOR, S-187

DATE MAY 8, 1986

REVISED

REVISED

ZOP-161 LG-OP-161 7-878