



DUNHAM SURVEYING, S.C.
SURVEYING & SUBDIVIDING
DELAVER, WISCONSIN 53115

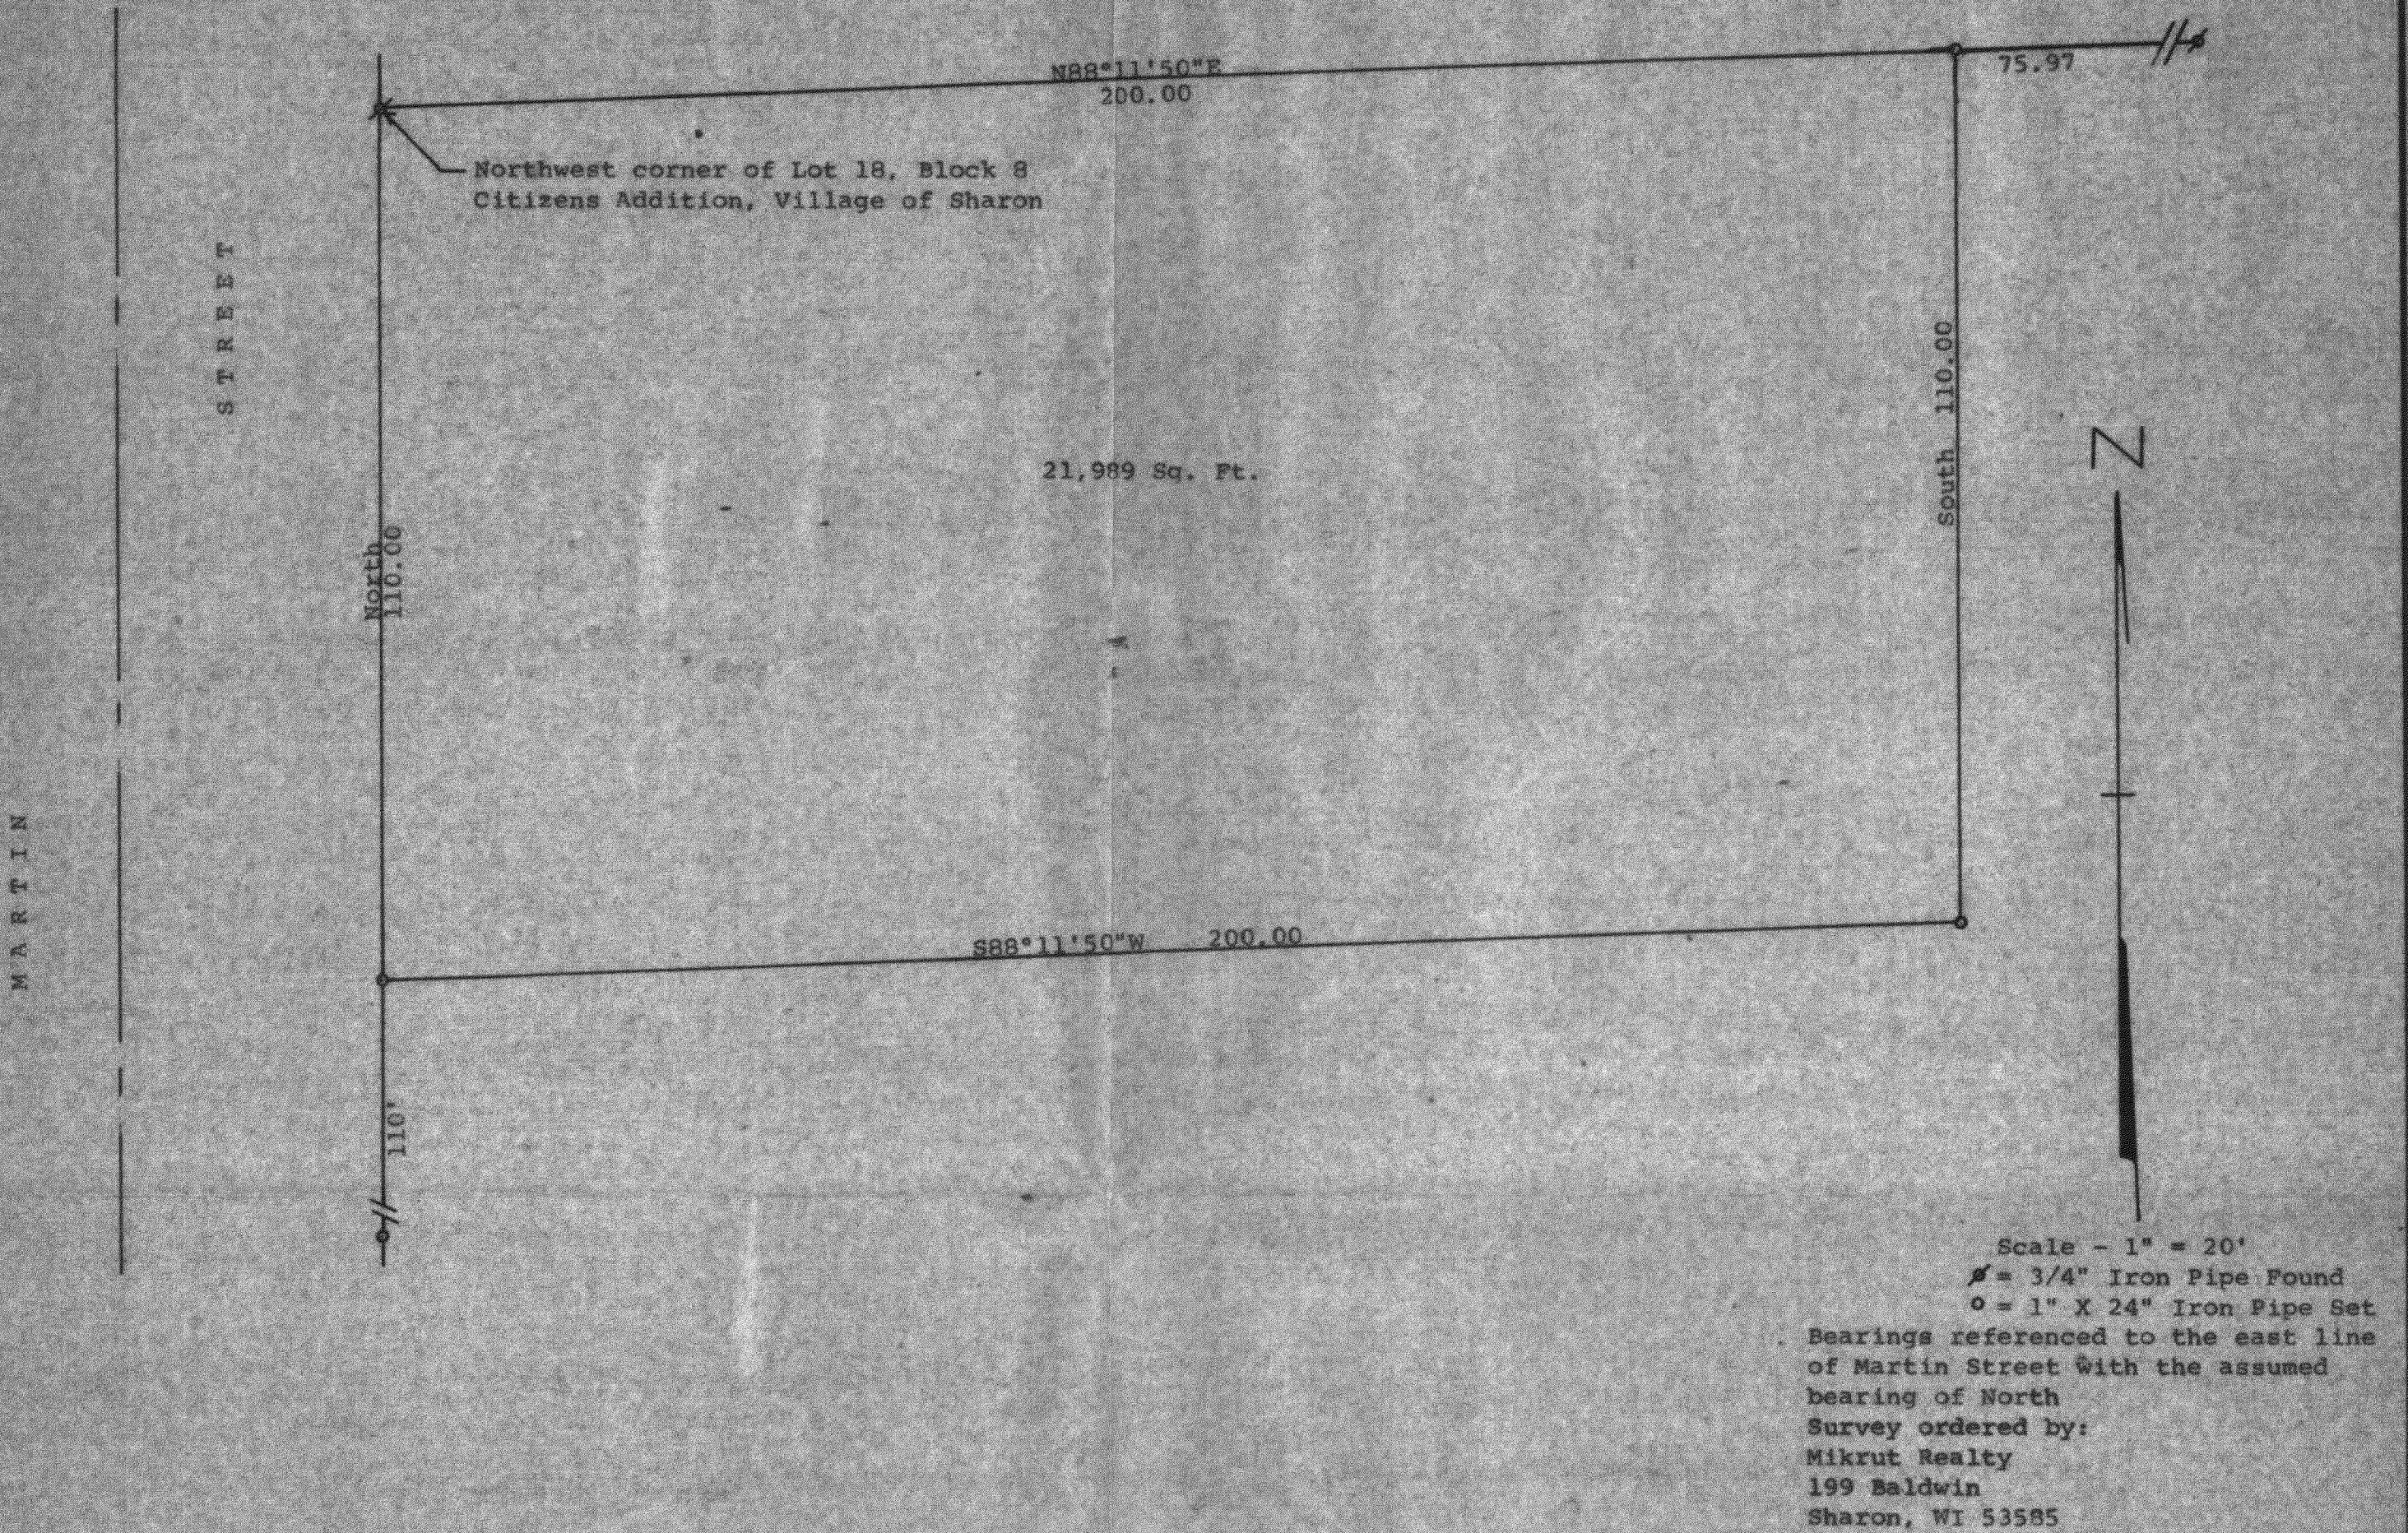

STATE OF WISCONSIN) SS
COUNTY OF WALWORTH)

I, George T. Dunham, Surveyor, certify that I have surveyed the property described as follows:

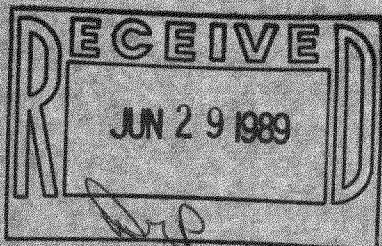

A parcel of land located in Lot 18, Block 8, Citizens Addition, Village of Sharon, Walworth County, Wisconsin, described as follows: Beginning at the northwest corner of said Lot 18; thence N88°11'50"E along the north line of said Lot 18, 200.00 feet; thence South parallel with the east line of Martin Street, 110.00 feet; thence S88°11'50"W parallel with the north line of said Lot 18, 200.00 feet; thence North along the east line of Martin Street, 110.00 feet to the place of beginning containing 21,989 square feet of land.

and that the plat shown hereon is a correct representation thereof and shows the size and location of the property, its exterior boundaries, the location of all visible structures and dimensions of all principal buildings thereon, boundary fences, apparent easements, roadways and visible encroachments, if any, and that I have surveyed the property hereon described, according to the official records, to the best of my knowledge and belief.
January 17, 1989

George T. Dunham
George T. Dunham, Surveyor

