


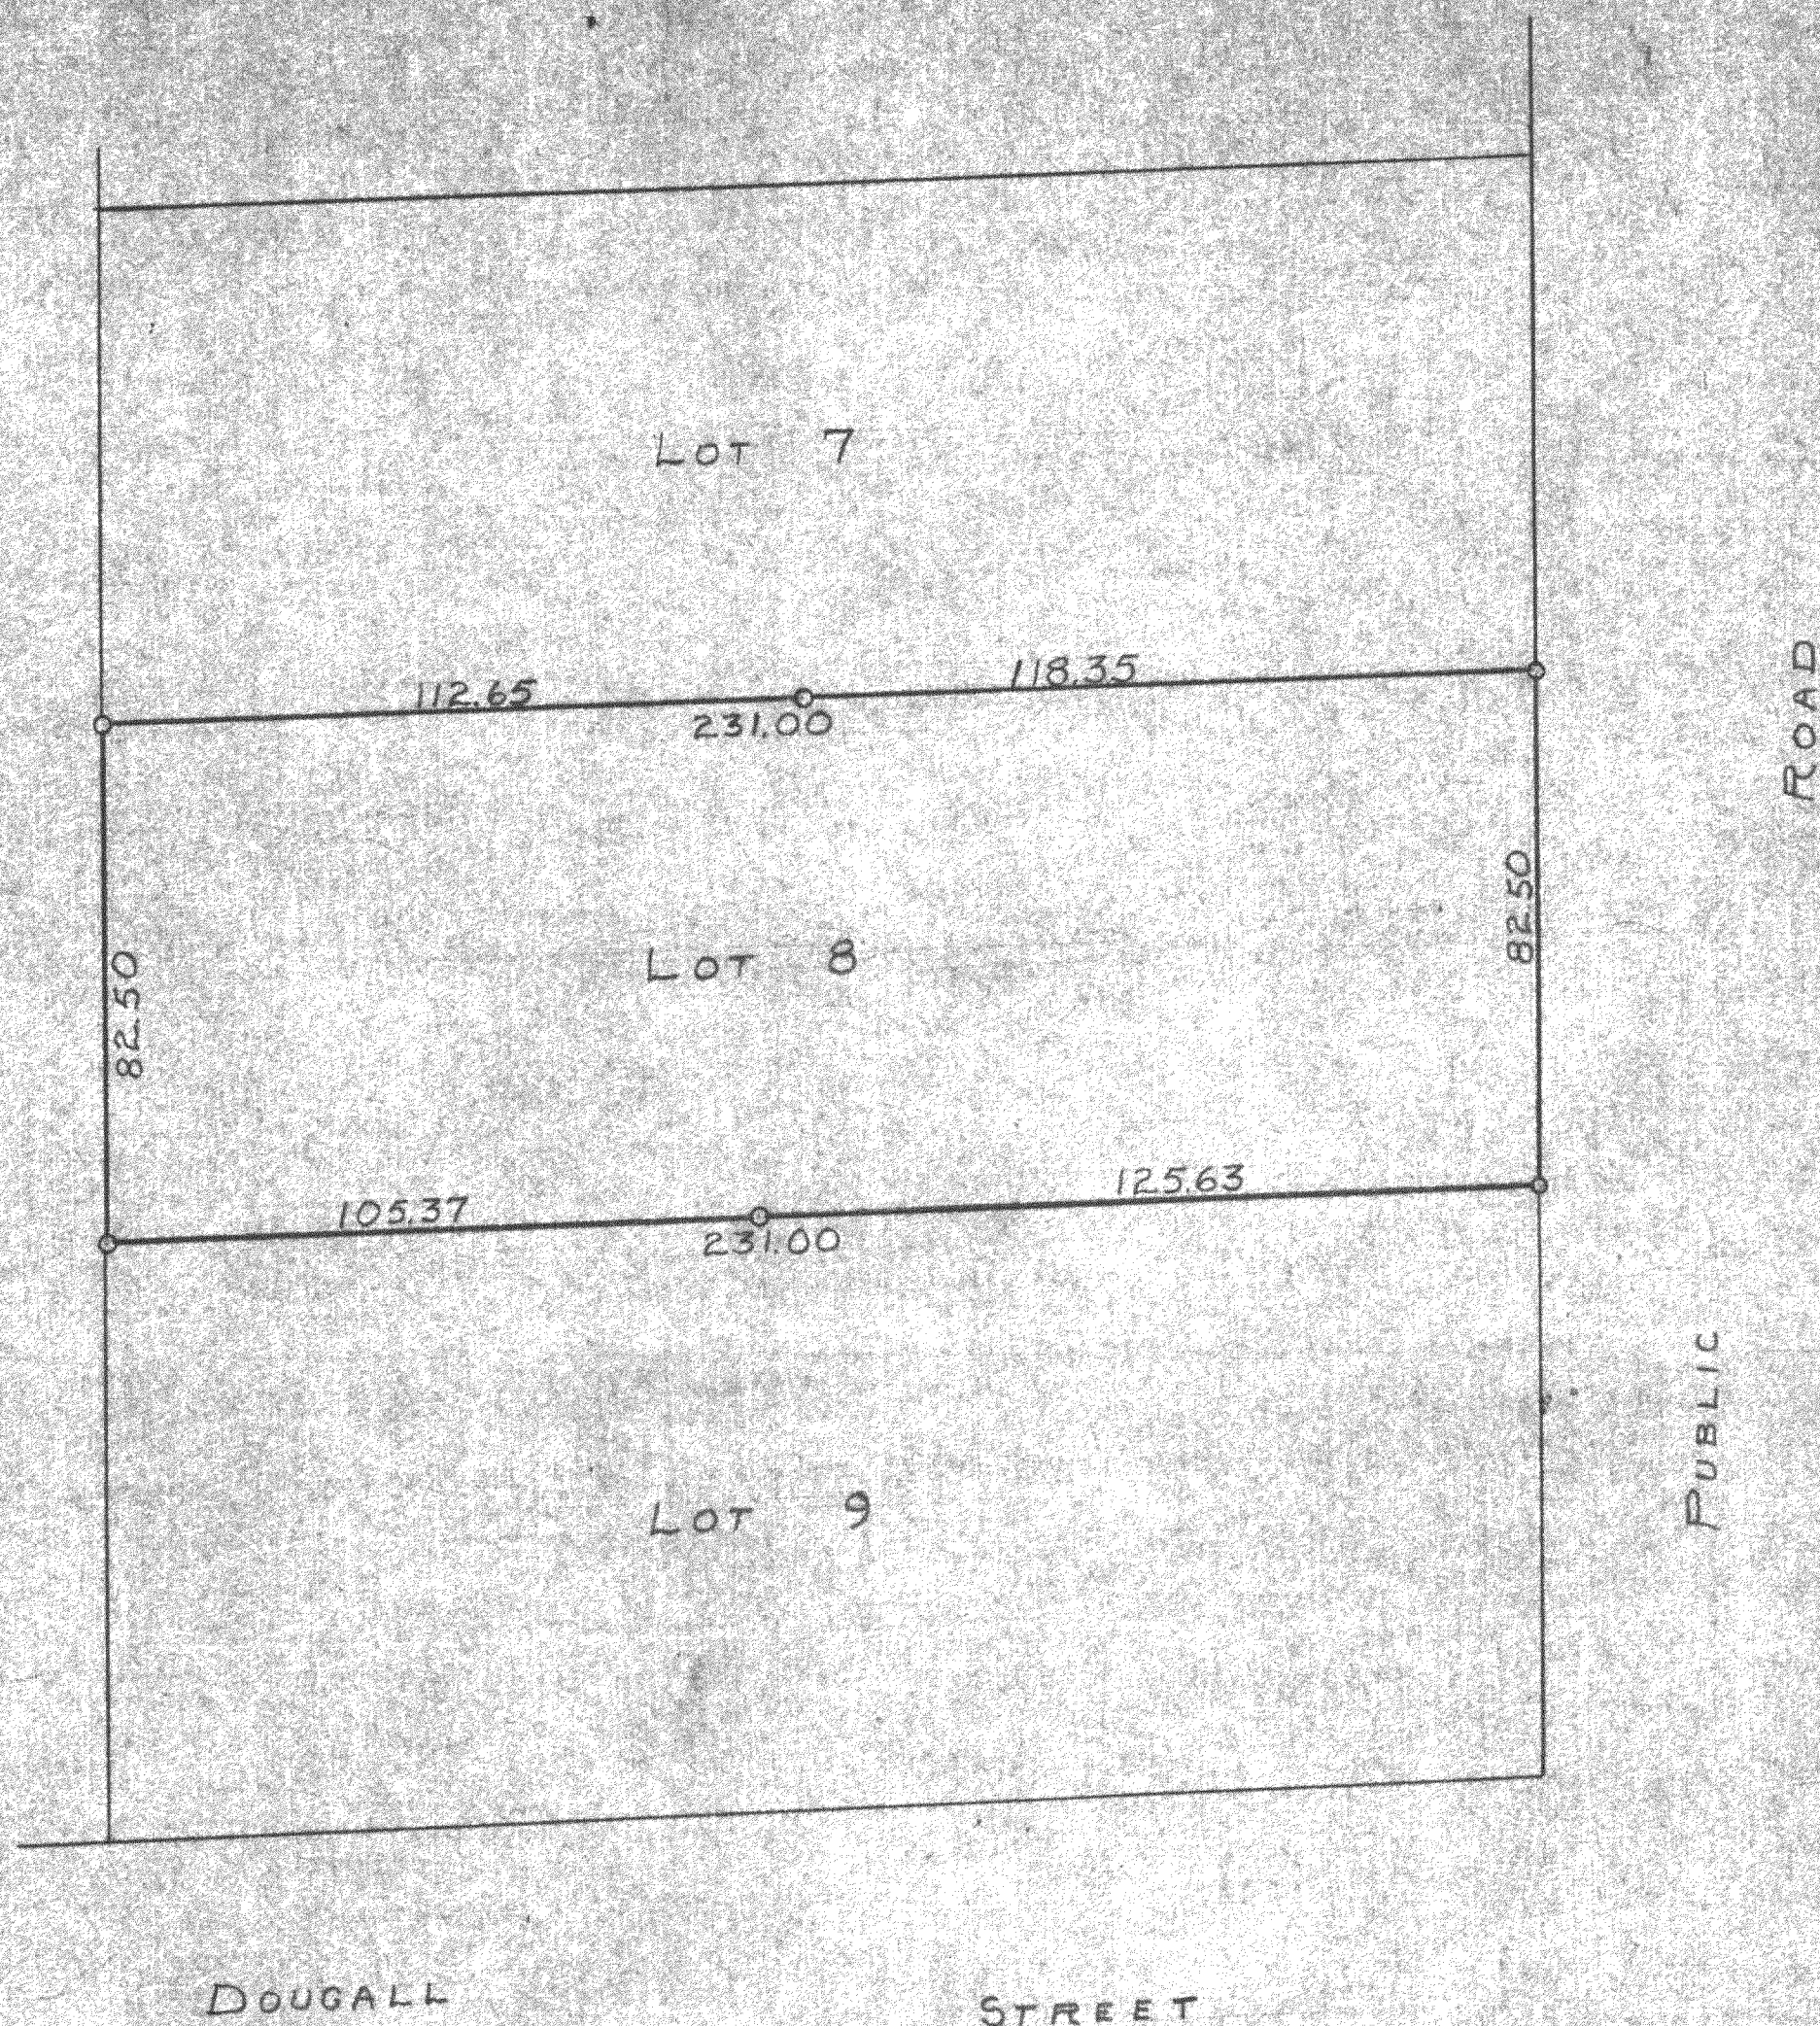

SCALE-1"=30'
O=IRON PIPE



PLAT OF SURVEY OF LOT 8, BLOCK 2, SHARON LAND
AND IMPROVEMENT COMPANIES' ADDITION TO THE
VILLAGE OF SHARON, WALWORTH COUNTY, WISCONSIN
SEPTEMBER 1952
George T. Dunham
SURVEYOR

U5LH-16

8-2