KOLB LAND CONSULTING, INC.
LAKE GENEVA, WIS.

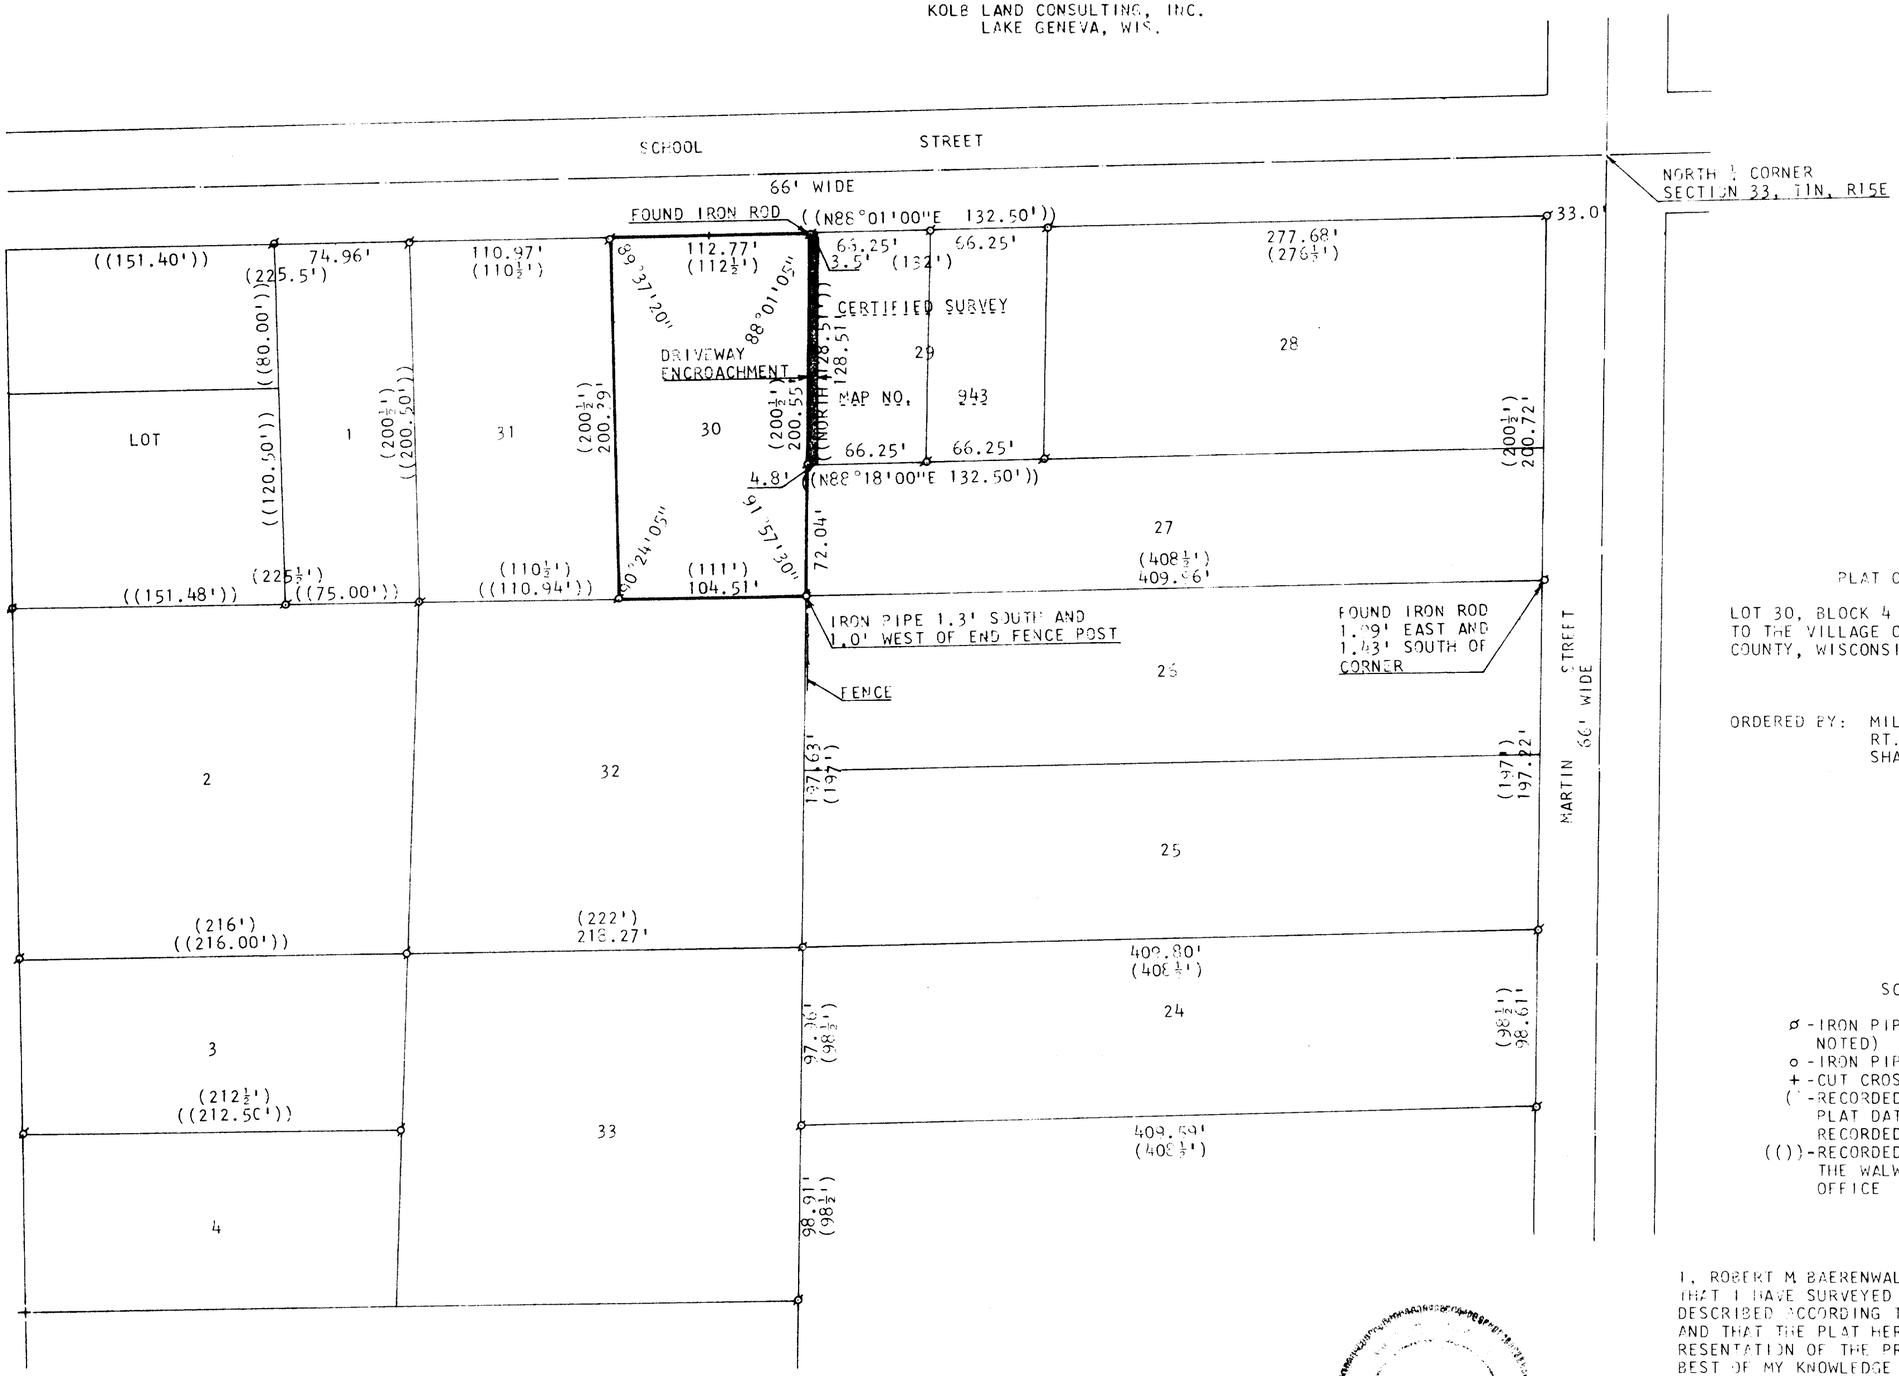

PLAT OF SURVEY OF

LOT 30, BLOCK 4 OF CITIZENS ADDITION TO THE VILLAGE OF SHARON, WALWORTH COUNTY, WISCONSIN.

ORDERED BY: MILBURN TRAVIS
RT. 1 - BOX 32
SHARON, WI. 53585

SCALE: 1"=60'

ø - IRON PIPE FOUND (UNLESS OTHERWISE NOTED)
o - IRON PIPE PLACED
+ - CUT CROSS FOUND
( ) - RECORDED AS--VILLAGE OF SHARON PLAT DATED JULY 17, 1894 AND RECORDED ON JULY 21, 1894
(()) - RECORDED AS--SURVEYS ON FILE AT THE WALWORTH COUNTY SURVEYOR'S OFFICE

I, ROBERT M BAERENWALD, DO HEREBY CERTIFY THAT I HAVE SURVEYED THE PROPERTY HEREON DESCRIBED ACCORDING TO THE OFFICIAL RECORDS AND THAT THE PLAT HEREON IS A CORRECT REPRESENTATION OF THE PROPERTY LINES TO THE BEST OF MY KNOWLEDGE AND BELIEF.

ROBERT M. BAERENWALD
WISCONSIN REGISTERED LAND SURVEYOR, S-1508

DATE Apr 26, 19

UCA-75

8-90-KV