


DUNHAM SURVEYING, S.C.
SURVEYING & SUBDIVIDING
DELAVAN, WISCONSIN 53115

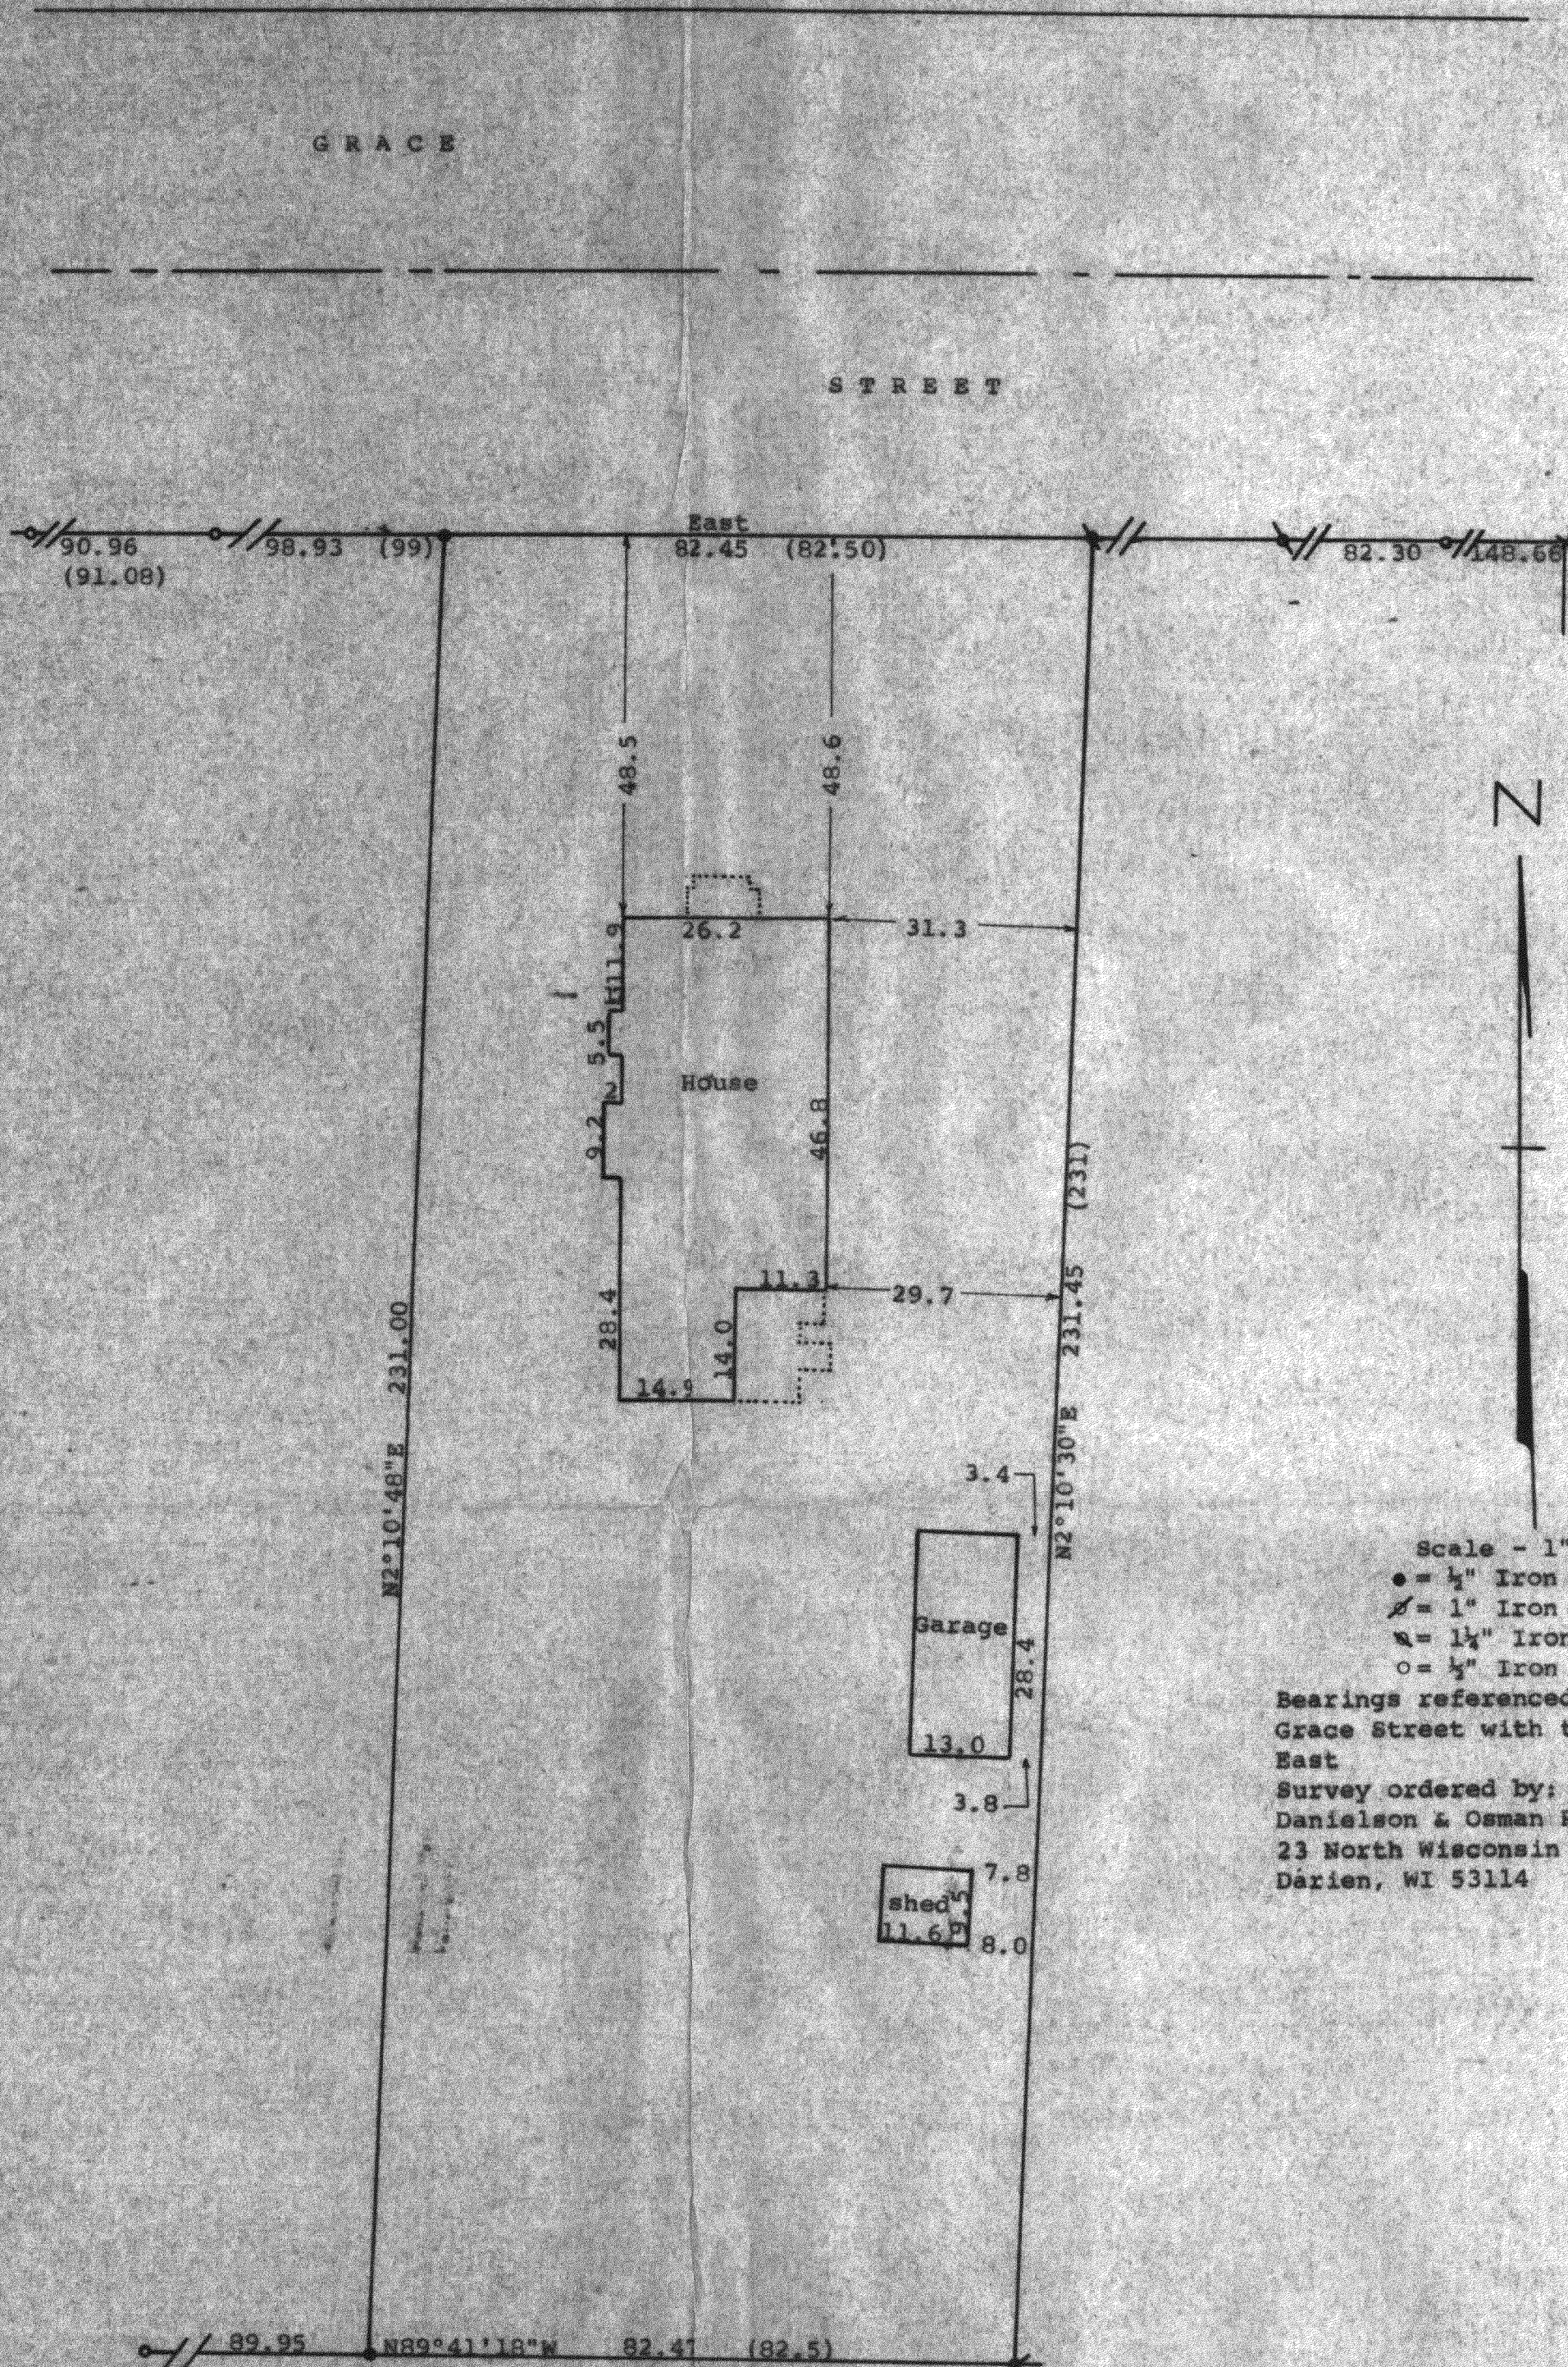

Scale - 1" = 20'

- = 1/4" Iron Rod Found
- ⊗ = 1" Iron Pipe Found
- ⊕ = 1 1/4" Iron Pipe Found
- = 1/2" Iron Pipe Found

Bearings referenced to the south line of Grace Street with the assumed bearing of East

Survey ordered by:
Danielson & Osman Realty
23 North Wisconsin Street
Darien, WI 53114

STATE OF WISCONSIN) ss
COUNTY OF WALWORTH)

I, George T. Dunham, Surveyor, certify that I have surveyed the property described as follows:

The East 5 rods of Lot 3 in Block 2 of Sharon Land and Improvement Co's Addition to the Village of Sharon, Walworth County, Wisconsin, and that the plat shown hereon is a correct representation thereof and shows the size and location of the property, its exterior boundaries, the location of all visible structures and dimensions of all principal buildings thereon, boundary fences, apparent easements, roadways and visible encroachments, if any, and that I have surveyed the property hereon described, according to the official records, to the best of my knowledge and belief.
March 29, 1991

George T. Dunham
George T. Dunham, Surveyor

