PREPARED FOR
JOHN LAW
RE/MAX GENEVA REALTY, LTD
101 BROAD ST. SUITE 102
LAKE GENEVA WI. 53147

PLAT OF SURVEY

- OF -

OUTLOTS 88 AND 90 OF THE ASSESSORS PLAT OF THE VILLAGE OF WALOWRTH TOWN 1 NORTH, RANGE 16 EAST, WALWORTH COUNTY, WISCONSIN EXCEPTING THE WEST 33 FEET OF OUTLOT 88 FOR ROAD WAY PURPOSES

PATHFINDER SURVEYING INC.
W2888 KRUEGER RD. UNIT "D"
LAKE GENEVA WI. 53147
(262) 248-3697

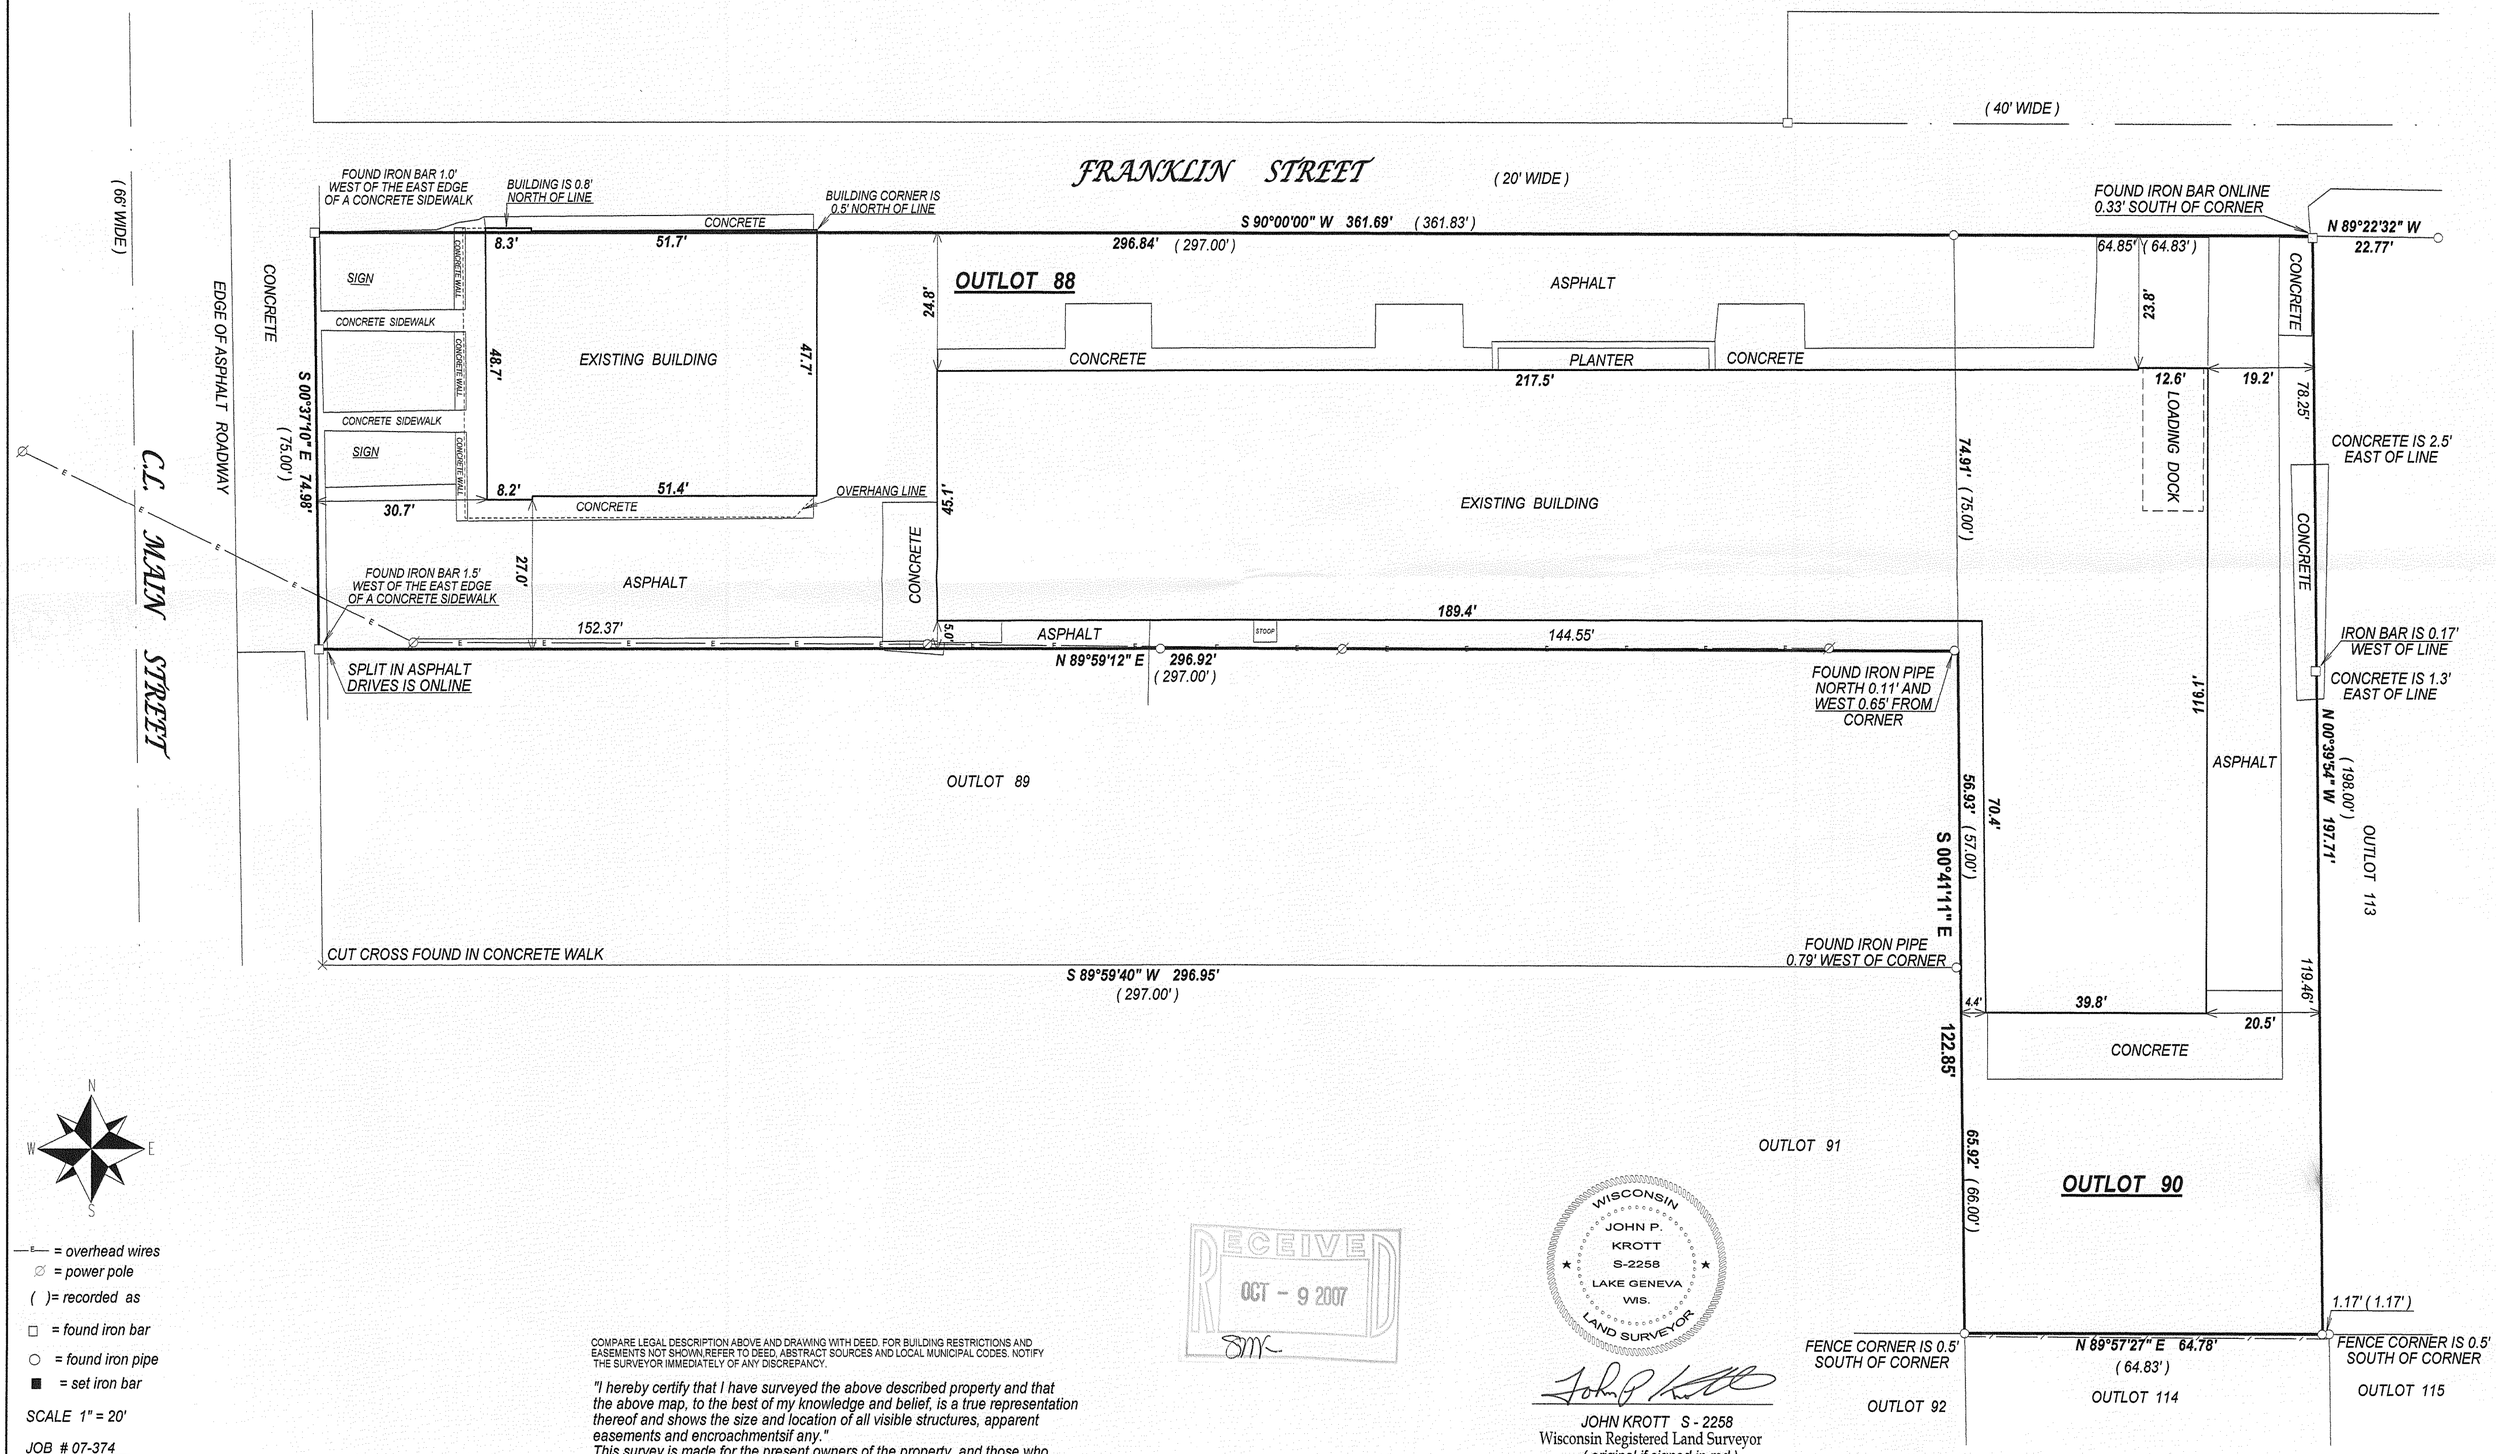

N
W E
S

—E— = overhead wires
∅ = power pole
( )= recorded as
□ = found iron bar
○ = found iron pipe
■ = set iron bar

SCALE 1" = 20'

JOB # 07-374

TAX ID # VWP00101

COMPARE LEGAL DESCRIPTION ABOVE AND DRAWING WITH DEED. FOR BUILDING RESTRICTIONS AND EASEMENTS NOT SHOWN REFER TO DEED, ABSTRACT, SOURCES AND LOCAL MUNICIPAL CODES. NOTIFY THE SURVEYOR IMMEDIATELY OF ANY DISCREPANCY.

"I hereby certify that I have surveyed the above described property and that the above map, to the best of my knowledge and belief, is a true representation thereof and shows the size and location of all visible structures, apparent easements and encroachmentsif any."
This survey is made for the present owners of the property, and those who purchase, mortgage, or guarentee the title thereto, within one year from the date hereof.

RECEIVED
OCT - 9 2007

WISCONSIN
JOHN P.
KROTT
S-2258
LAKE GENEVA
WIS.
LAND SURVEYOR

JOHN KROTT S - 2258
Wisconsin Registered Land Surveyor
(original if signed in red)

DATED THIS THE 5th DAY OF SEPTEMBER 2007.

009 - 1059